
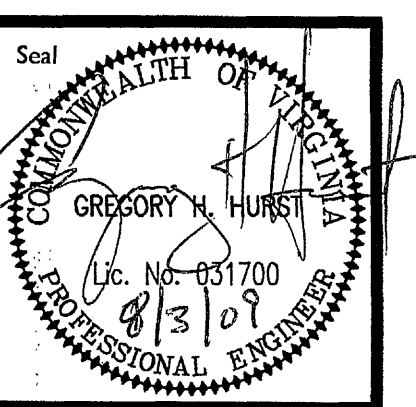
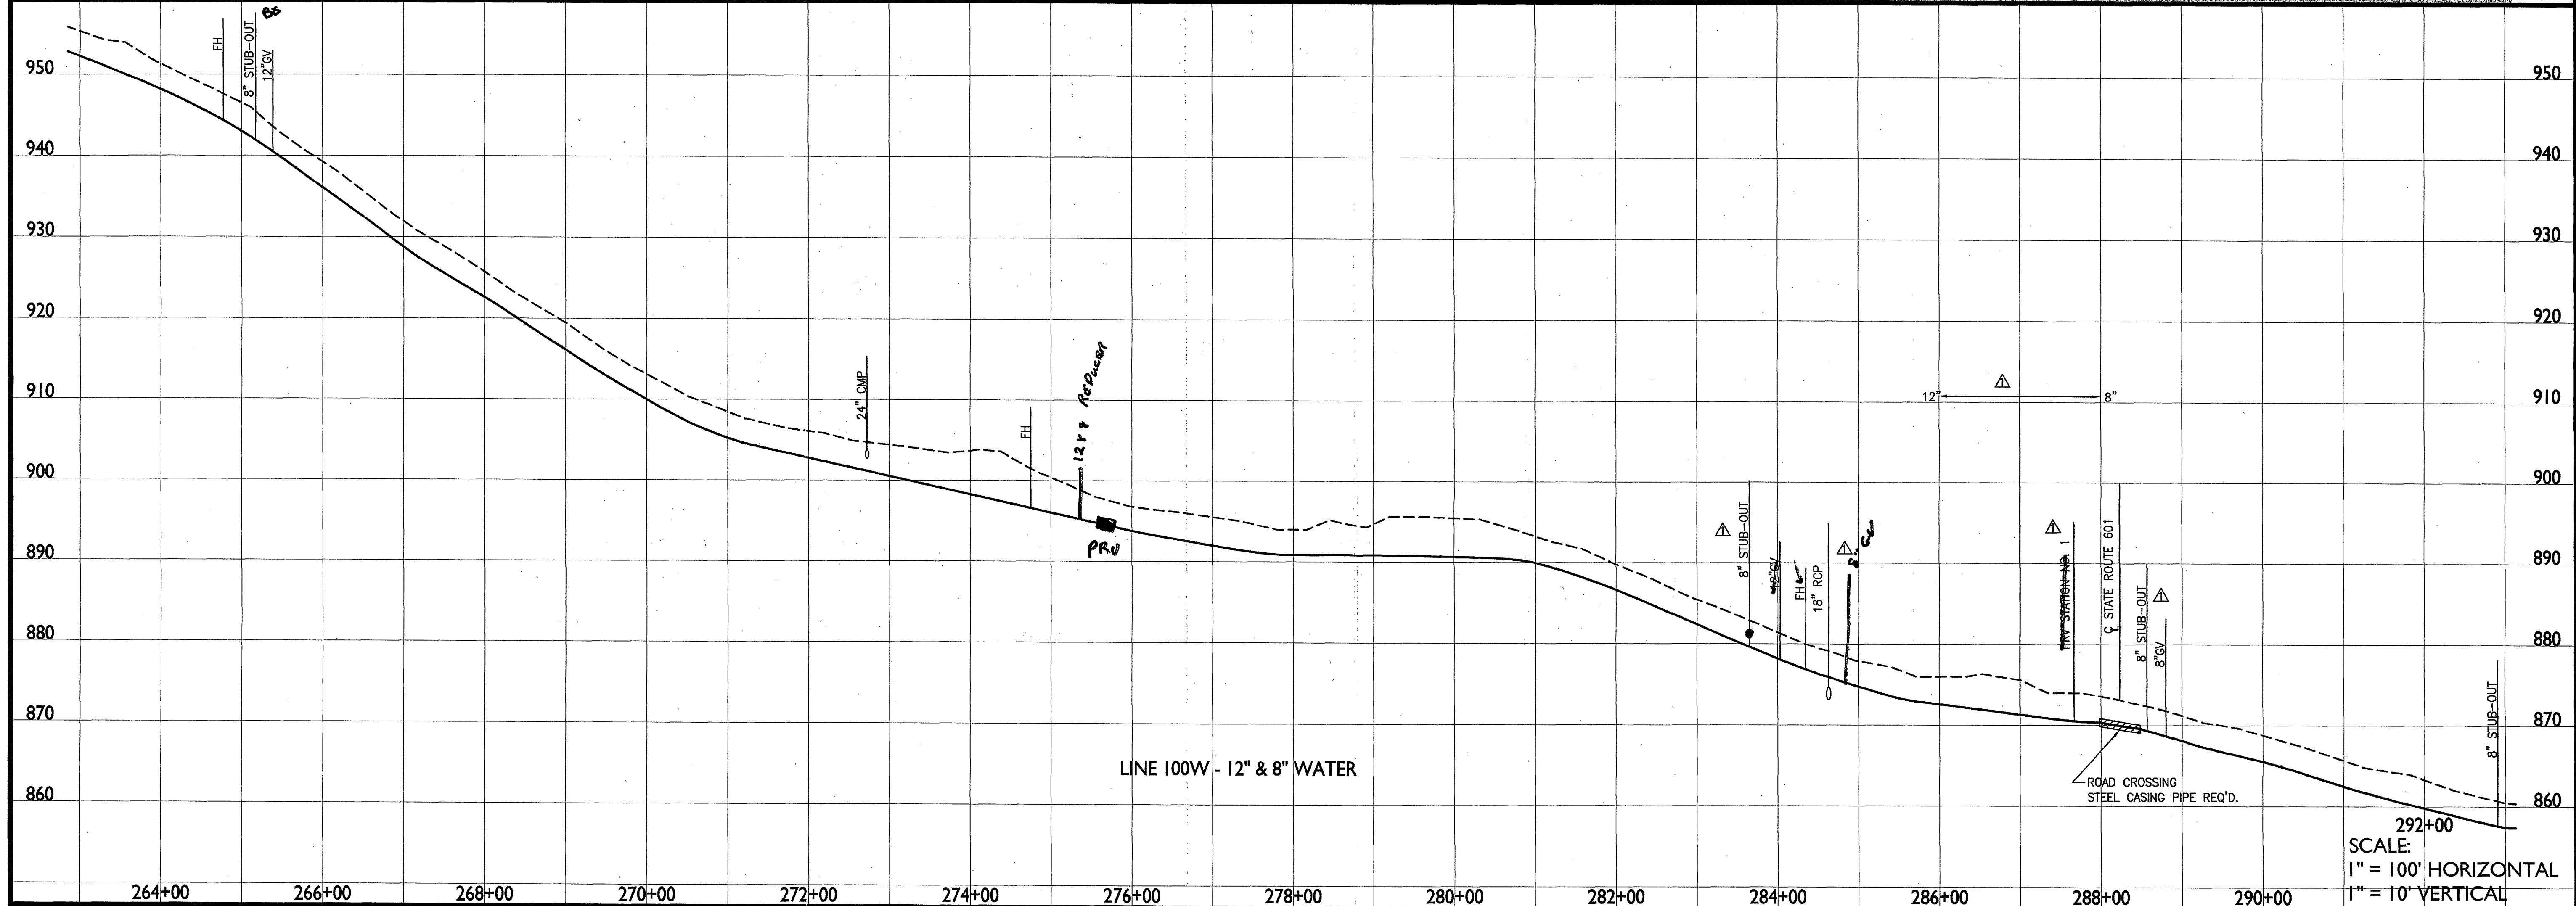


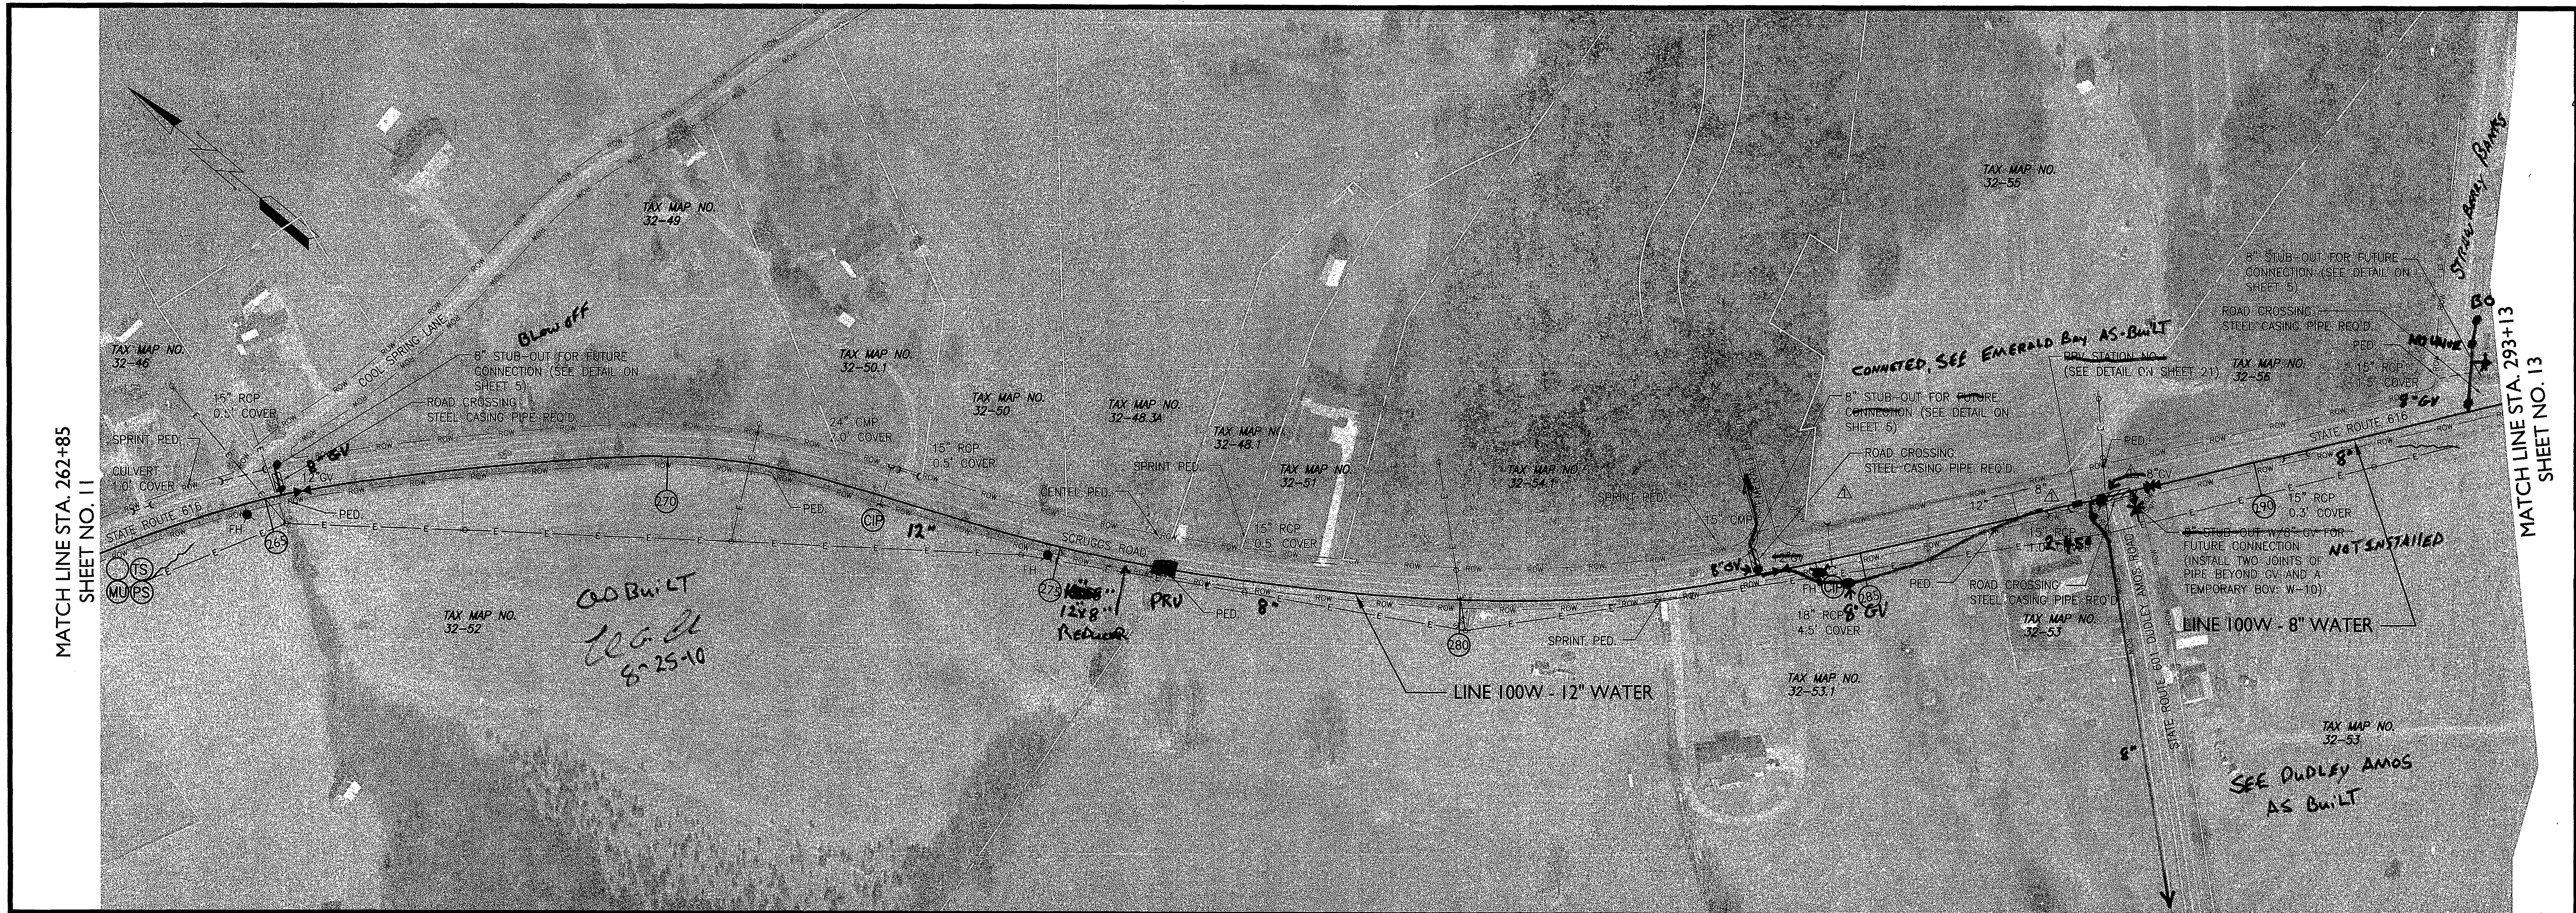

STATE ROUTE 616 WATER LINE EXTENSION
FOR THE
FRANKLIN COUNTY BOARD OF SUPERVISORS
AND
WESTERN VIRGINIA WATER AUTHORITY

PLAN & PROFILE - LINE 100W

No.	Date	Purpose of Document Issue
1	07/02/09	REVIEW DOCUMENTS ISSUED
2	07/17/09	OWNER COMMENTS 07/13/09
3	07/22/09	FINAL DOCUMENTS ISSUED

Designed: *[Signature]*
Drawn: *[Signature]*
Checked: *[Signature]*
Date: JULY 2009
File No.: WATER LINE PLANS

Project No.: 9343-02



Sheet No.: 12