



s:\30\130715-southway_phase1_infrastructure\DWG\Sheet\CD39175-C7-10-PFUT.dwg | Plotted on 9/29/2017 8:14 AM by Rich Samaria

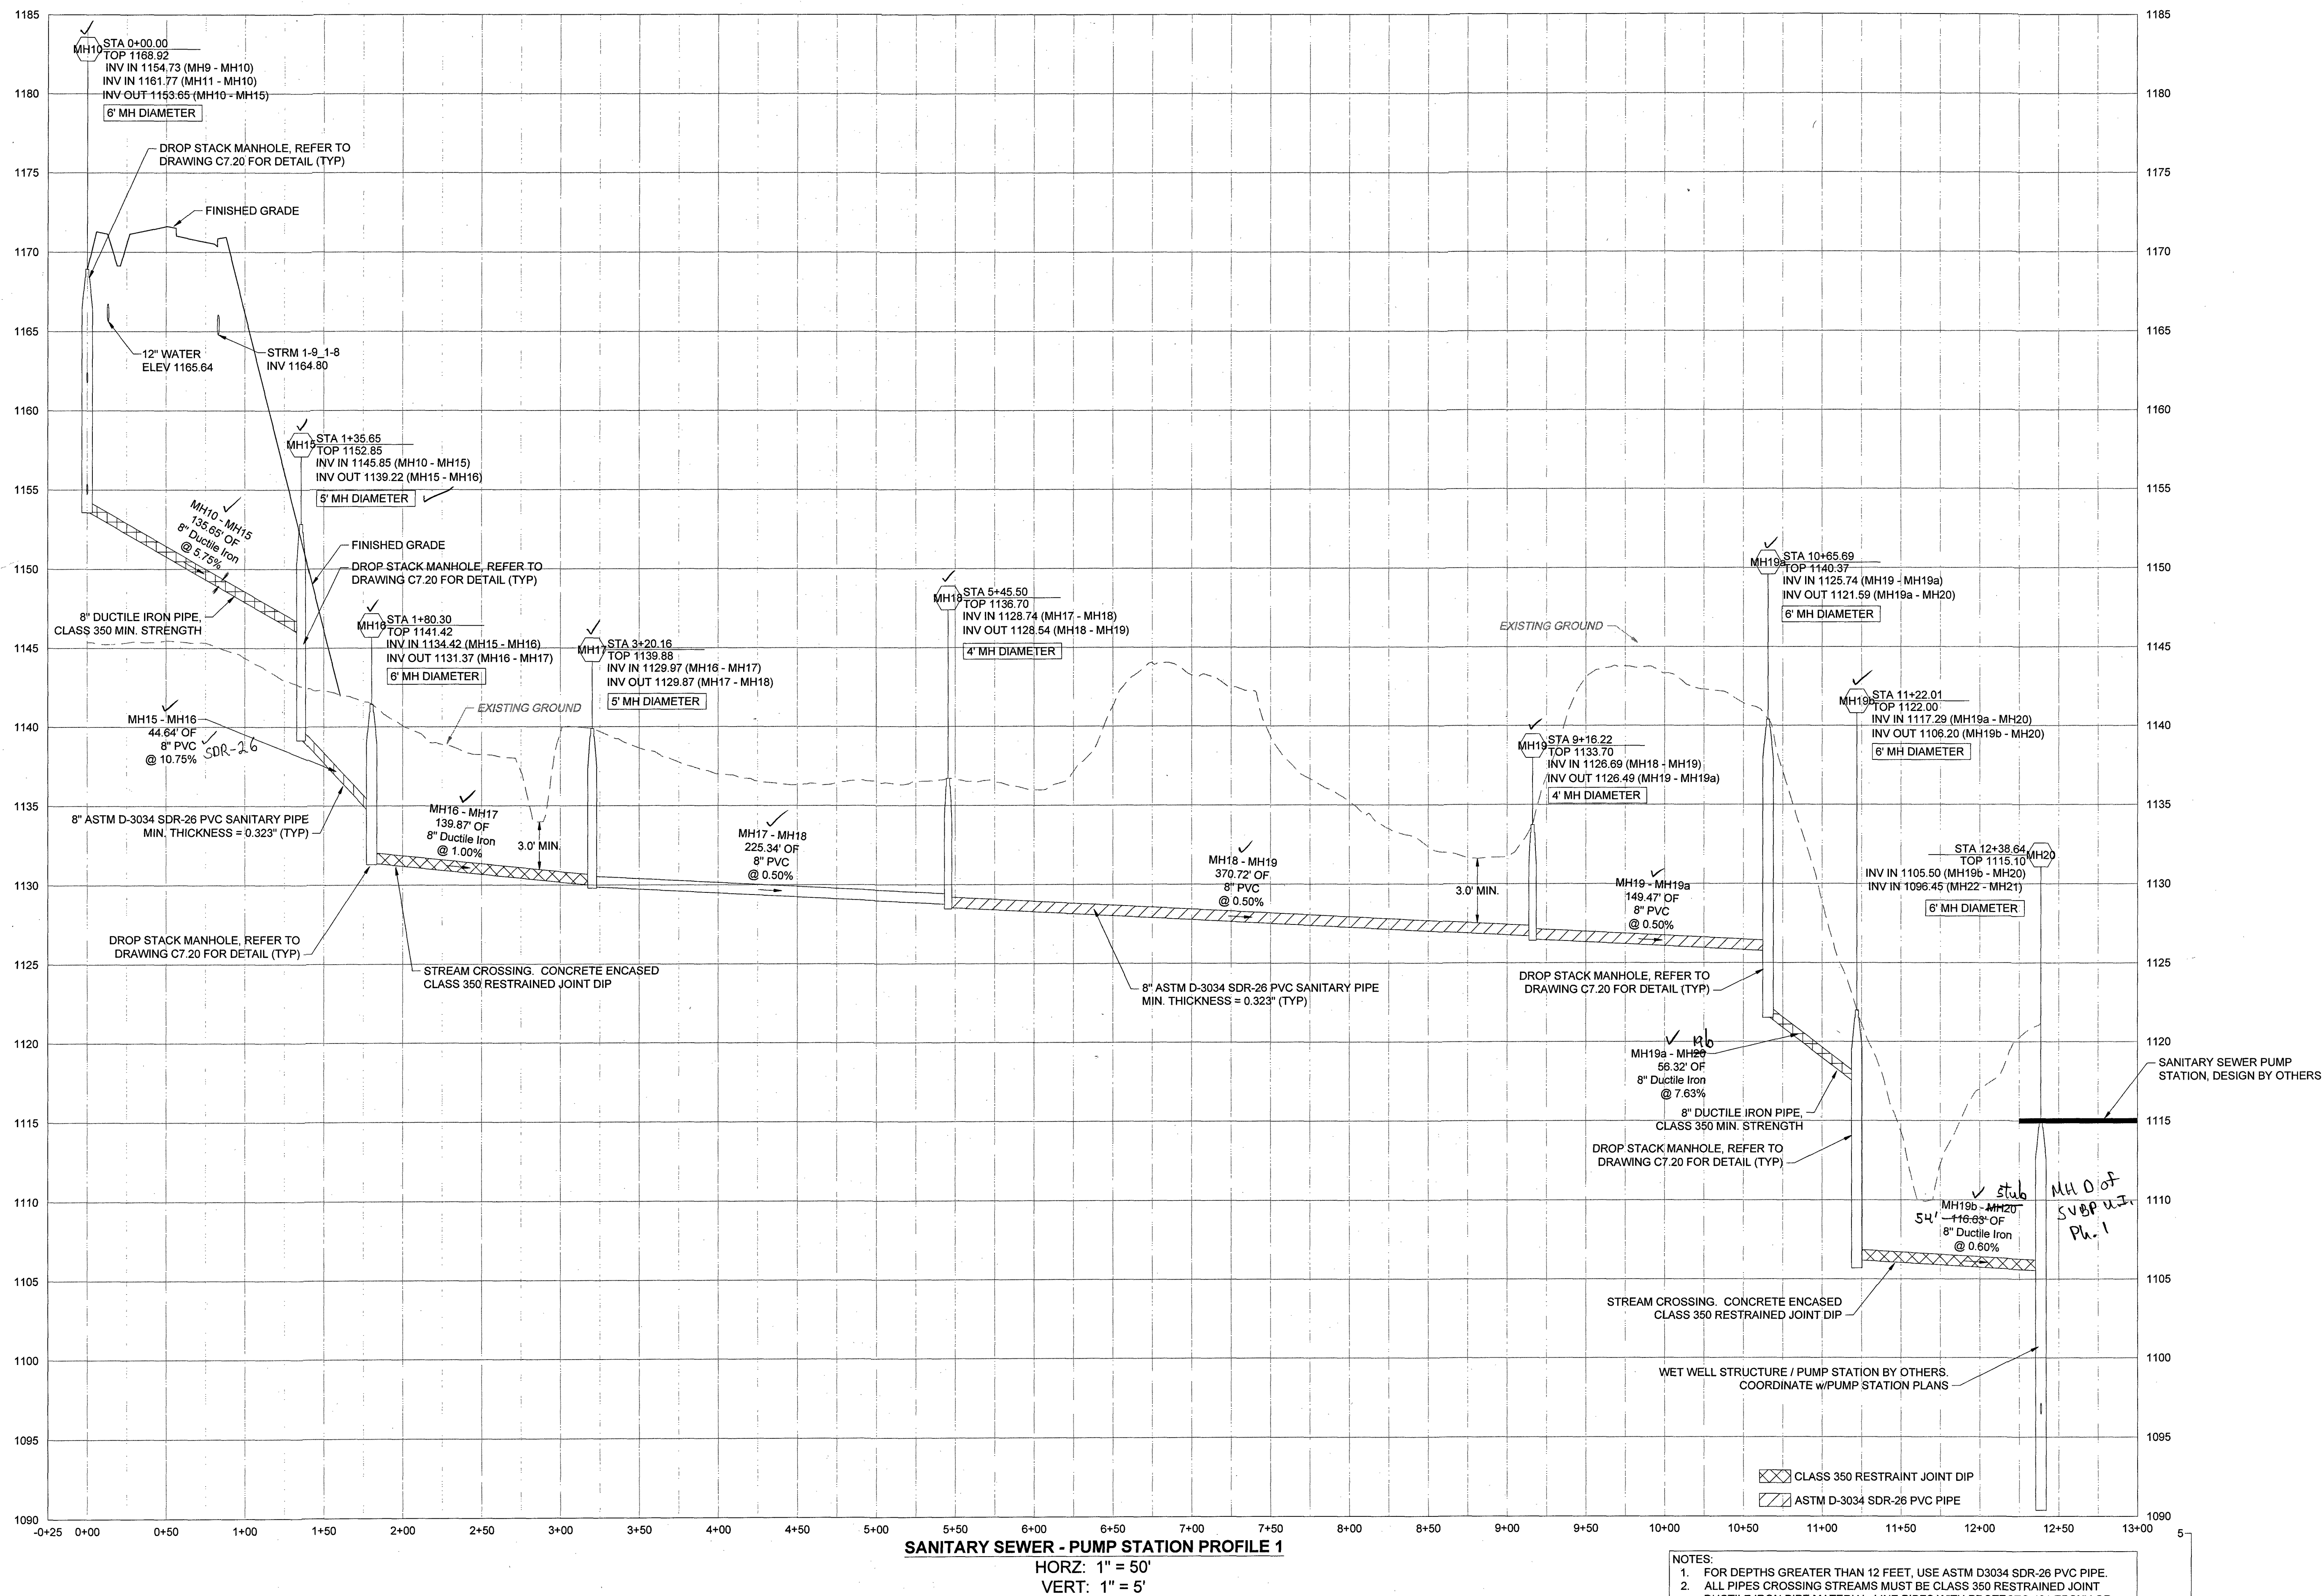

SANITARY SEWER - PUMP STATION PROFILE 1

HORIZ: 1" = 50'
VERT: 1" = 5'

- NOTES:
1. FOR DEPTHS GREATER THAN 12 FEET, USE ASTM D3034 SDR-26 PVC PIPE.
 2. ALL PIPES CROSSING STREAMS MUST BE CLASS 350 RESTRAINED JOINT DUCTILE IRON PIPE MATERIAL, LINE PIPES WITH PROTECTO 401 EPOXY OR APPROVED EQUAL.
 3. ALL DROP MANHOLES SHALL HAVE A DIAMETER OF 5 FEET OR GREATER DEPENDING ON DEPTH.

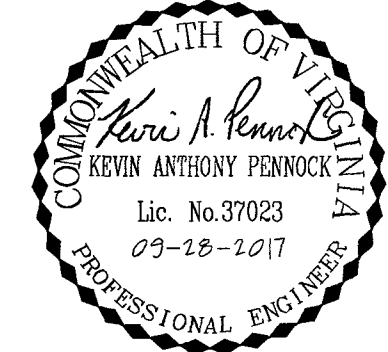

THIS DRAWING PREPARED AT THE
CORPORATE OFFICE
1001 Boulders Parkway, Suite 300 | Richmond, VA 23225
TEL 804.200.6500 FAX 804.560.1016 www.timmons.com

YOUR VISION ACHIEVED THROUGH OURS.

DATE	ISSUE FOR BID	ADDENDUM NO. 3	ADDENDUM NO. 4	ADDENDUM NO. 8	REVISIONS PER VDOT COMMENTS	REVISIONS PER COUNTY FOR BORROW AREA
07/14/2017	08/04/2017	08/09/2017	08/21/2017	09/15/2017	09/28/2017	

DRAWN BY
D.O.

DESIGNED BY
R.S.

CHECKED BY
K.P.

SCALE
H: 1" = 50'
V: 1" = 5'

SUMMIT VIEW BUSINESS PARK PHASE 1

FRANKLIN COUNTY, VA
SANITARY SEWER PROFILES

JOB NO.

39176

SHEET NO.

C7.12

These plans and associated documents are the exclusive property of TIMMONS GROUP and may not be reproduced in whole or in part and shall not be used for any purpose whatsoever, inclusive, but not limited to construction, bidding, and/or construction staking without the express written consent of TIMMONS GROUP.