

Existing Storm Drainage Table						
#	STRUCTURE	RIM	TOP	GRATE	INV. OUT	INV. IN
D-1	Headwall	1162.28'			1160.30' (12" CMP)	
D-2	Headwall	1160.24'			1157.71' (12" CMP)	
D-3	12" CMP				1165.87' (12" CMP)	1167.70' (12" CMP)

Existing Storm Drainage						
#	STRUCTURE	RIM	TOP	GRATE	INV. OUT	INV. IN
D-3	12" CMP				1165.87' (12" CMP)	
D-4	12" CMP				1174.96' (12" CMP)	
D-5	12" CMP				1184.13' (12" CMP)	
D-6	12" CMP				1183.50' (12" CMP)	
D-7	12" CMP				1089.17' (12" CMP)	



WESTERN VIRGINIA WATER AUTHORITY
601 South Jefferson Street, Suite 300
Roanoke, Virginia 24011

DES: PJM
DRAWN: JES
CHECK: GWF
DATE: 05/24/18


SCALE: AS SHOWN
HORIZ: 1" = 40'
VERT: N/A

SUMMIT VIEW BUSINESS PARK UTILITY IMPROVEMENTS
PHASE 1

EXISTING CONDITIONS
LIFT STATION #1

DRAWING
C1.02

SHEET
5

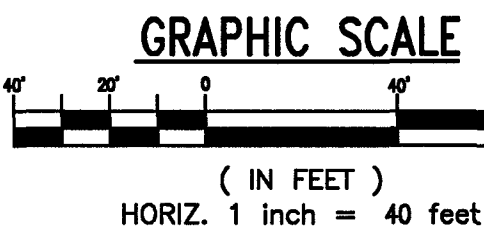

As-Built

REV	DATE	DESCRIPTION
-----	------	-------------