



NOTE:

1. ALL PIPE MATERIALS SHALL BE AS SPECIFIED ON THE PIPE SCHEDULE SHOWN ON DRAWING C4.02.

Issued 02/15/2019

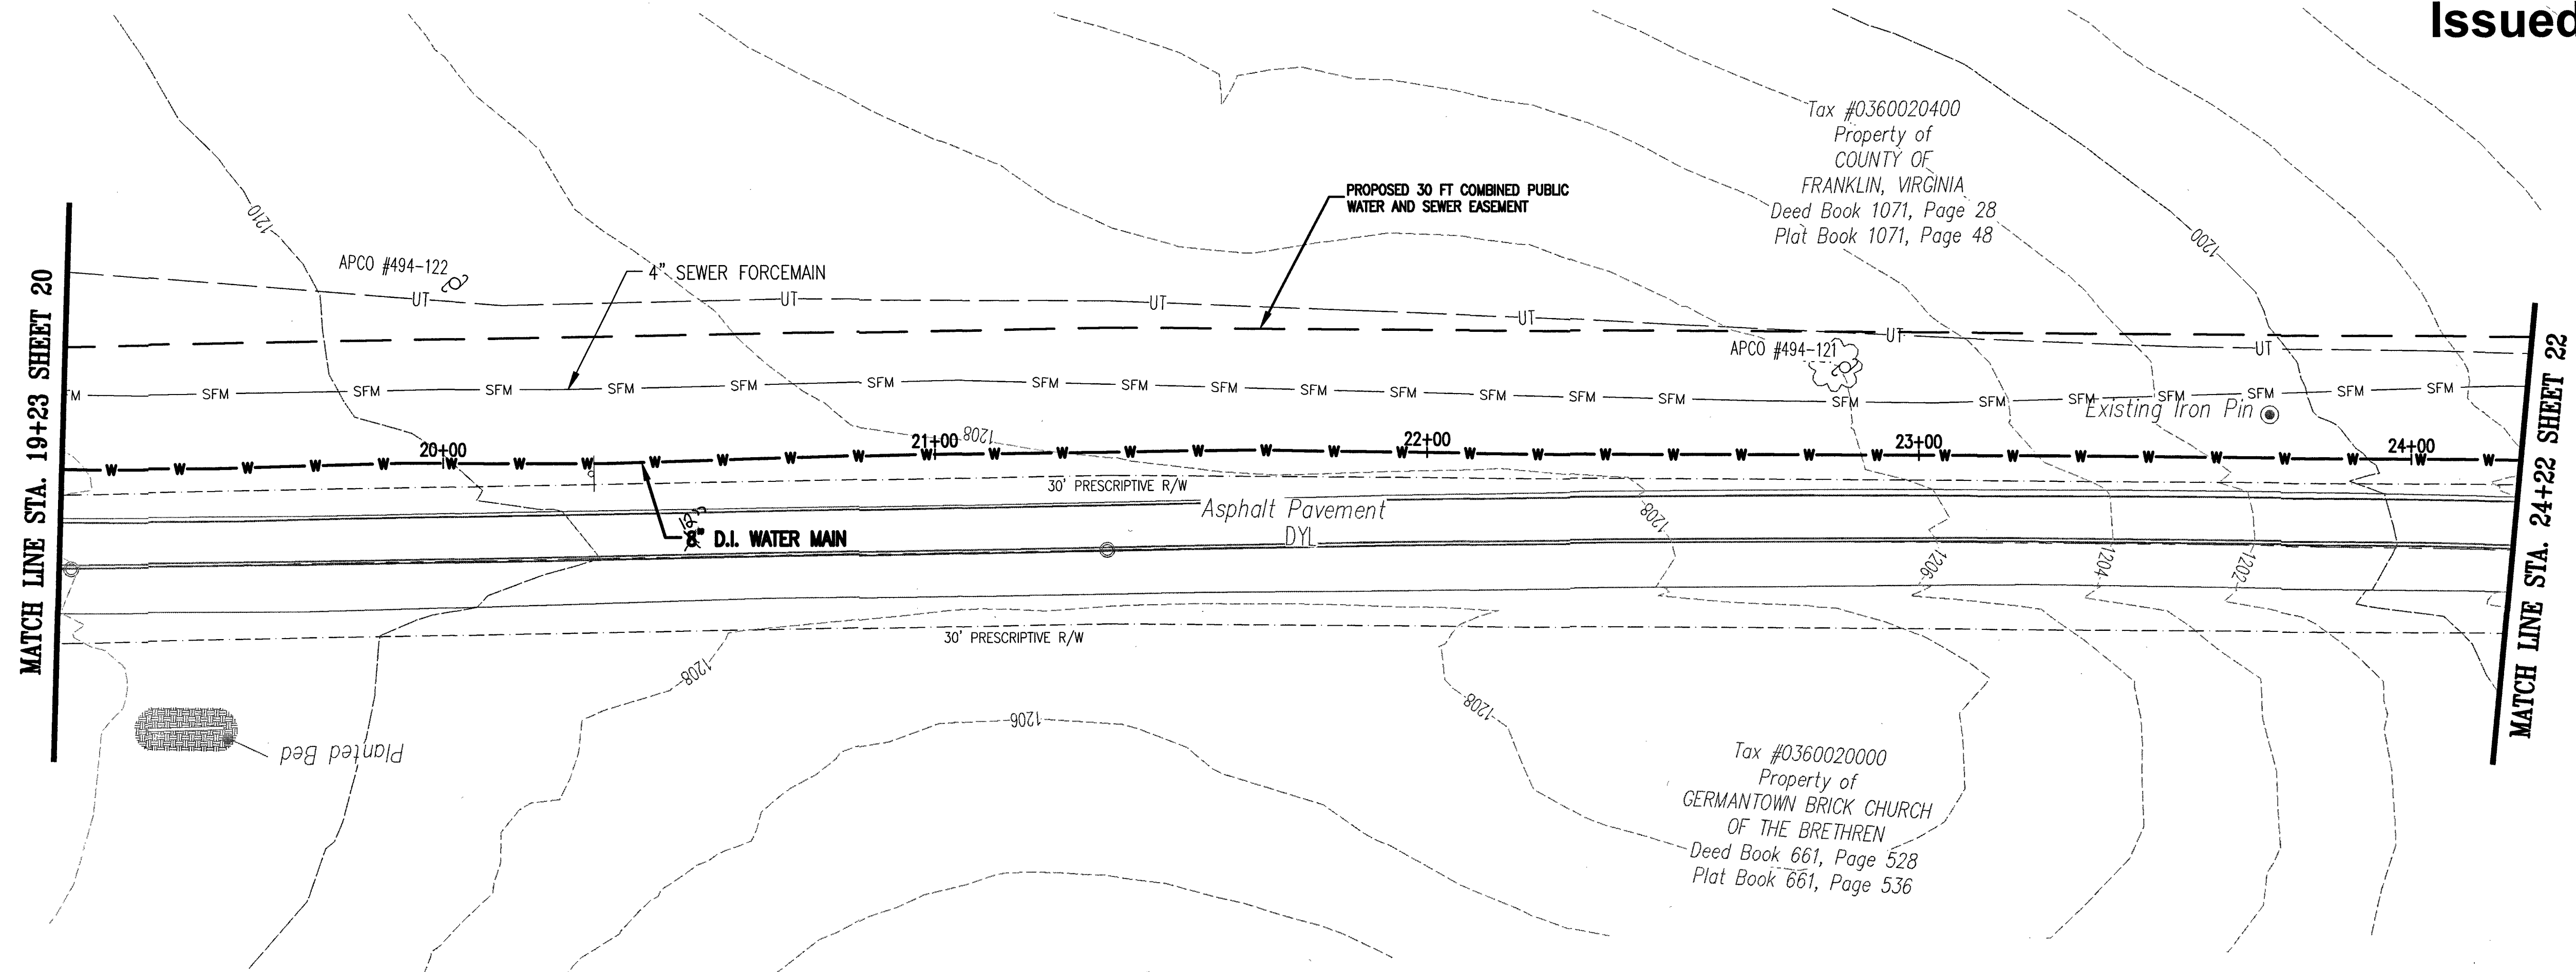

Changed To 18" Pipe

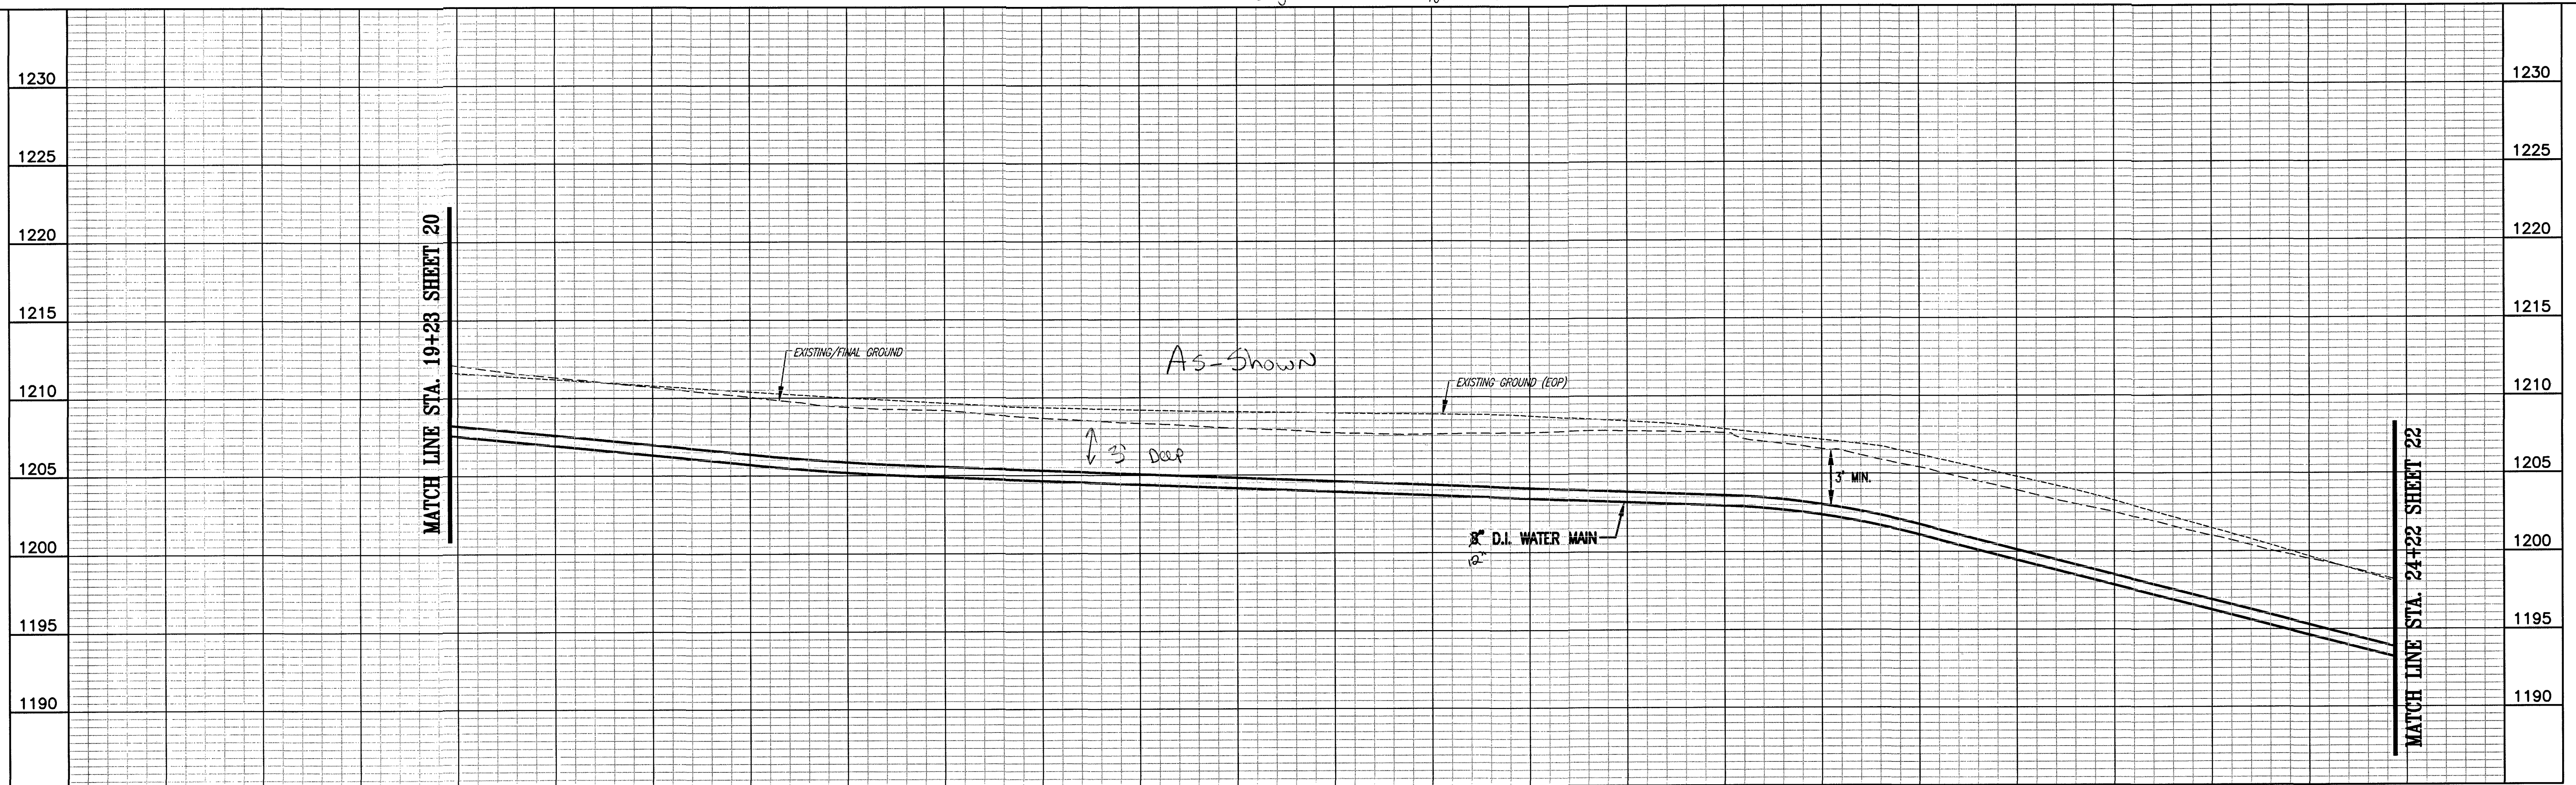

19+00


20+00

21+00

22+00

23+00

24+00

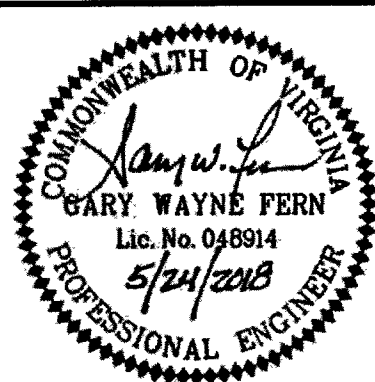


Whitman, Requardt & Associates, LLP
1700 Kraft Dr, Suite 1200, Blacksburg, VA 24060

WESTERN VIRGINIA WATER AUTHORITY
601 South Jefferson Street, Suite 300
Roanoke, Virginia 24011

DES: PJM
DRAWN: JES
CHECK: GWF
DATE: 05/24/18

SCALE: AS SHOWN
HORIZ: 1" = 20'
VERT: 1" = 5'

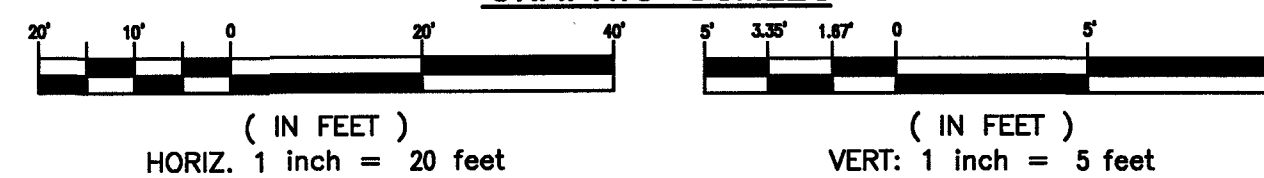

SUMMIT VIEW BUSINESS PARK UTILITY IMPROVEMENTS
PHASE 1

8" D.I. WATER MAIN PLAN - PROFILE
STA. 19+23 TO STA. 24+22

As-Built		
REV	DATE	DESCRIPTION

DRAWING
C4.05

SHEET
21