
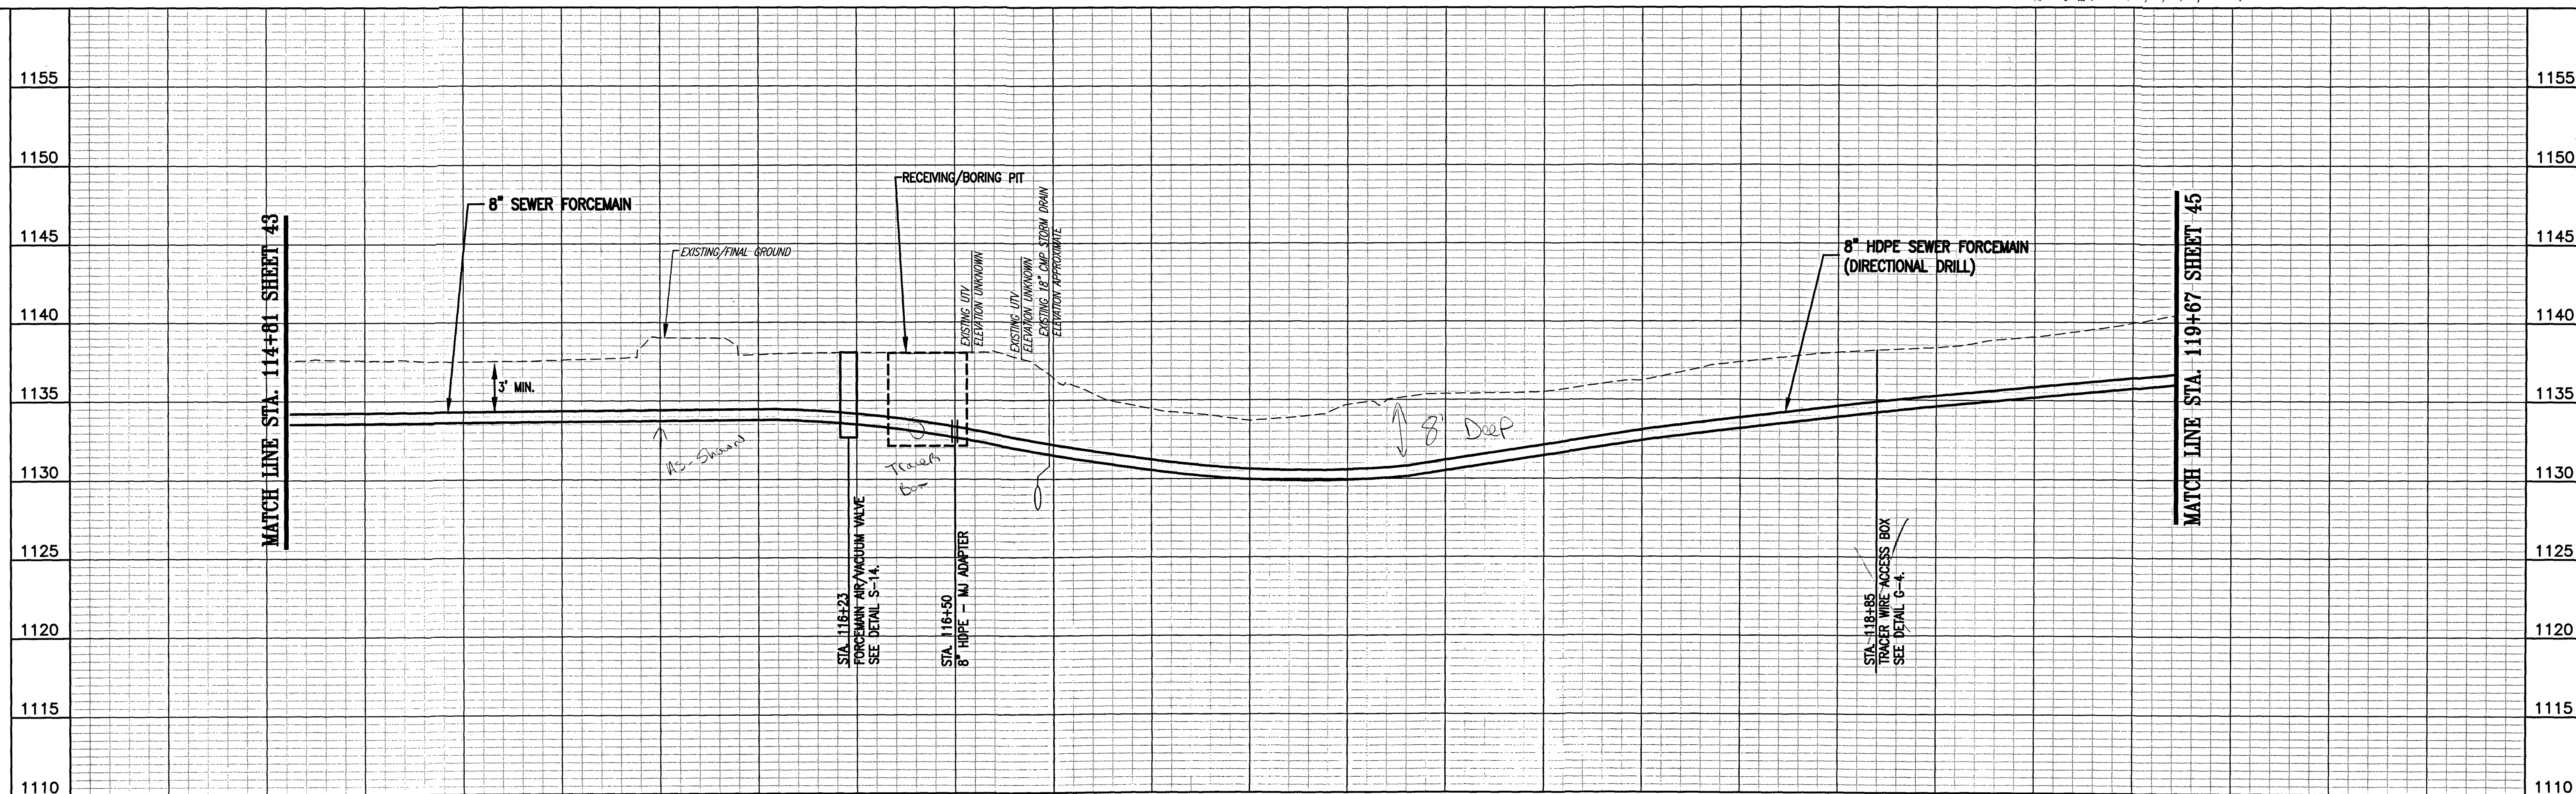


NOTE:

1. ALL PIPE MATERIALS SHALL BE AS SPECIFIED ON THE PIPE SCHEDULE SHOWN ON DRAWING C4.02.


Issued 04/10/2019

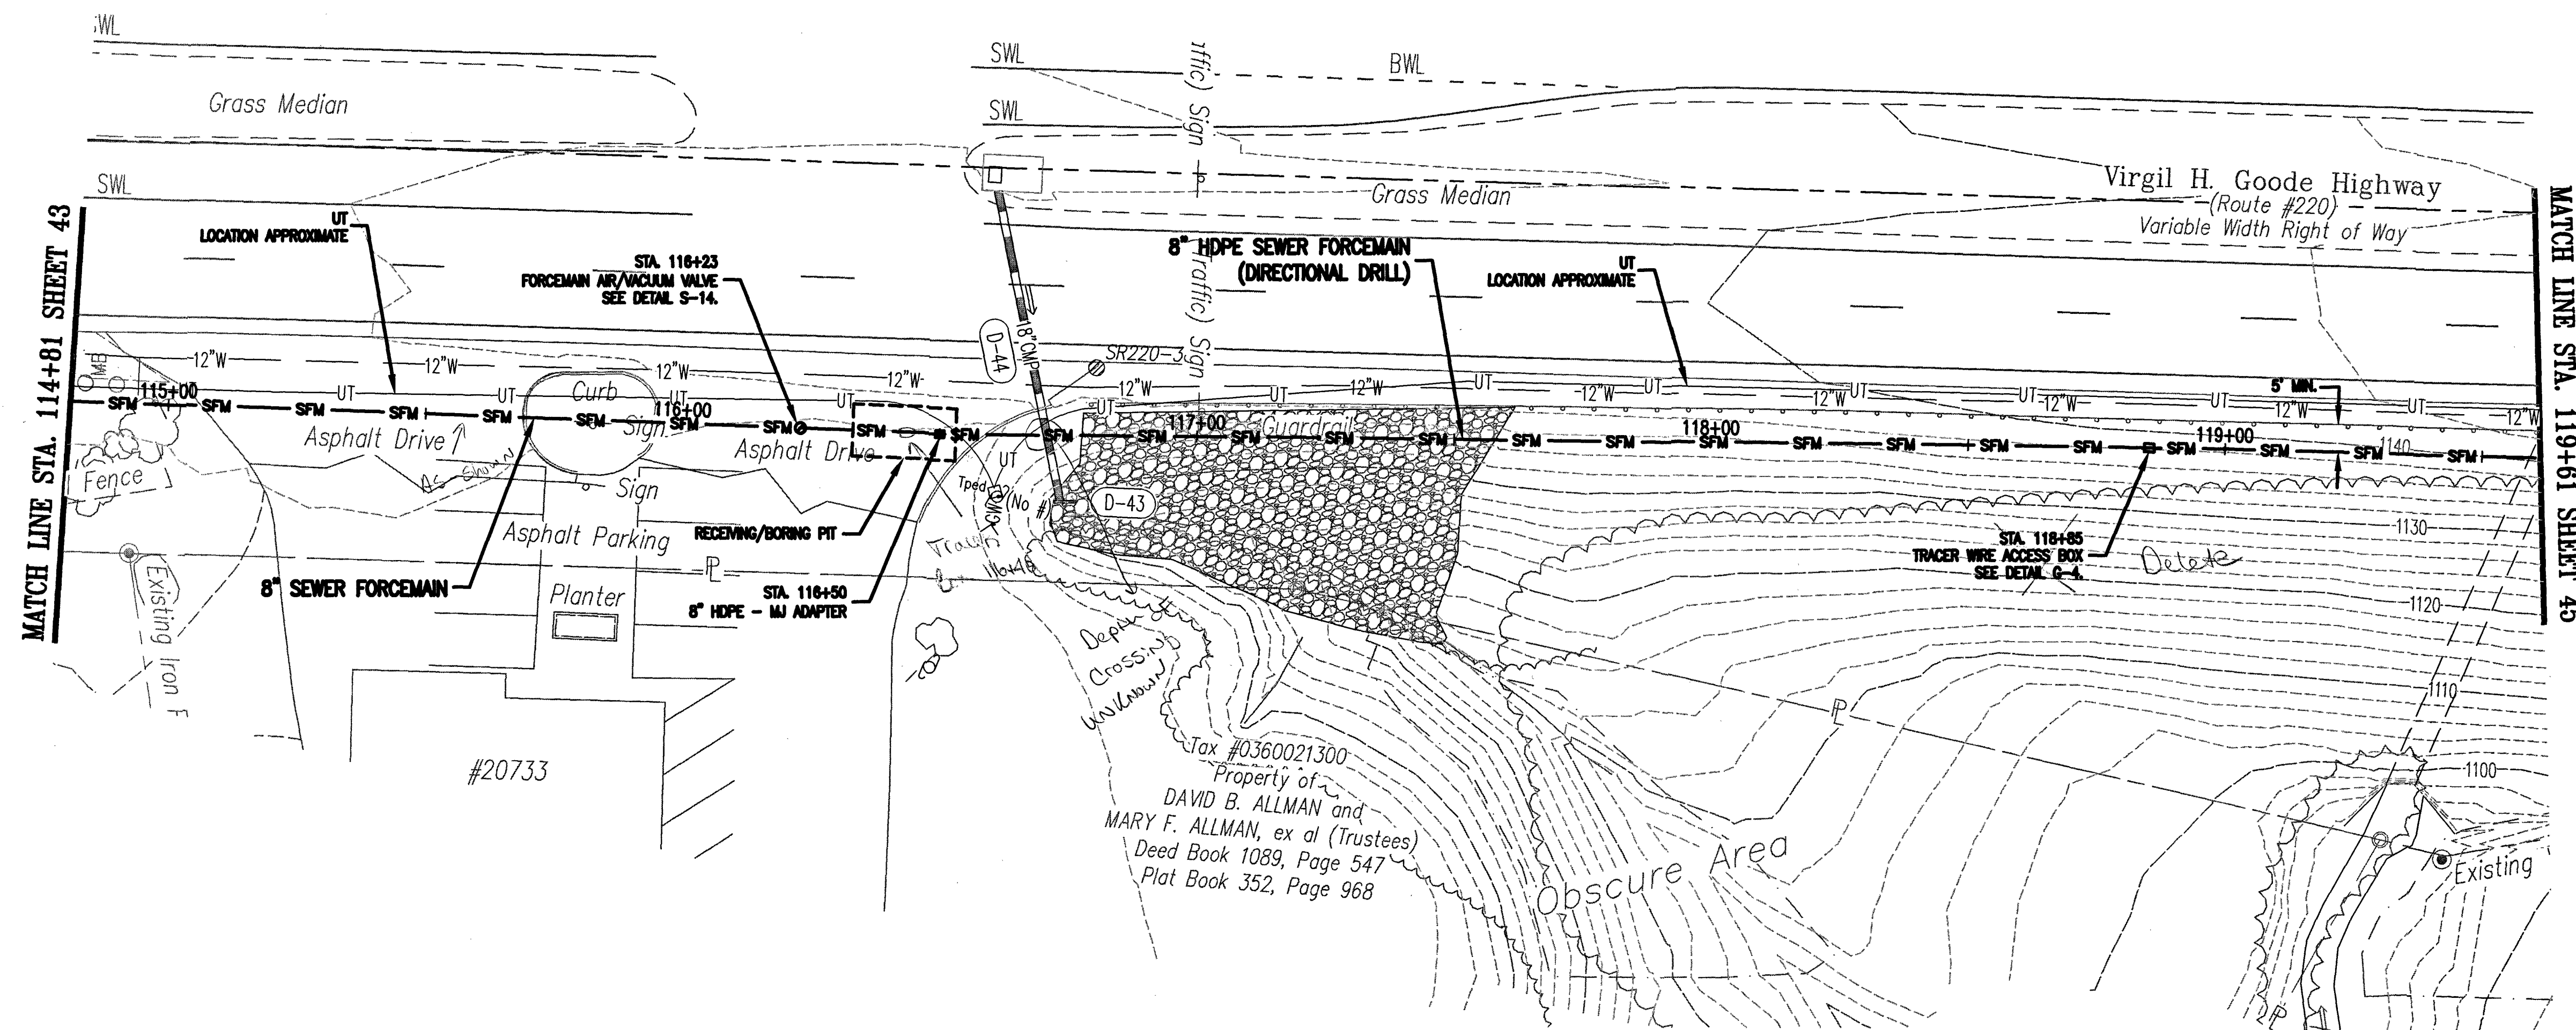

WESTERN VIRGINIA WATER AUTHORITY
601 South Jefferson Street, Suite 300
Roanoke, Virginia 24011

DES: KN
DRAWN: JES
CHECK: GWF
DATE: 8/01/18

SCALE: AS SHOWN
HORIZ: 1" = 20'
VERT: 1" = 5'

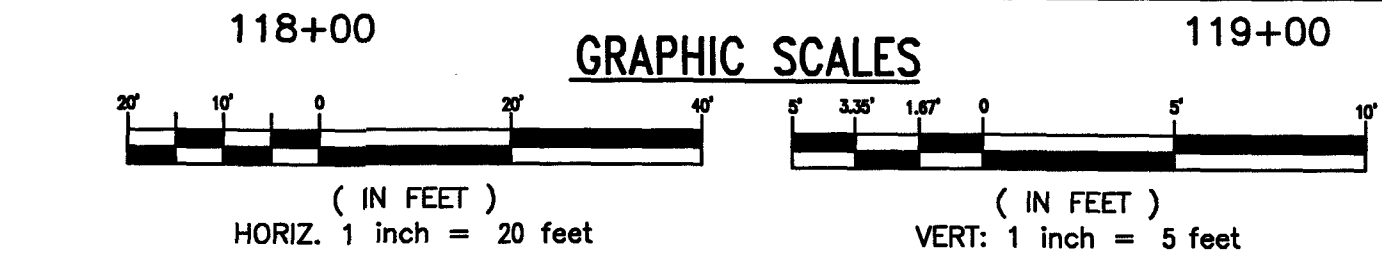

SUMMIT VIEW BUSINESS PARK UTILITY IMPROVEMENTS
PHASE 2

8" SEWER FORCEMAIN PLAN - PROFILE
STA. 114+81 TO STA. 119+61

AS-BUILT		ALIGNMENT REVISION	
REV	DATE	DESCRIPTION	
1	4/10/2019		
DRAWING		SHEET	
C4.28		44	