
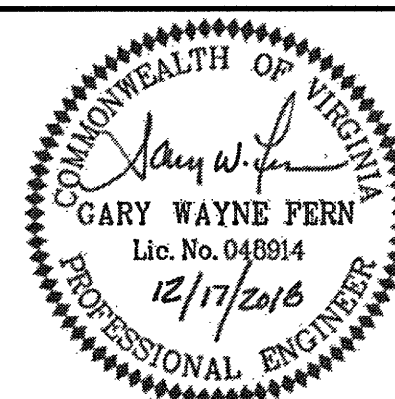
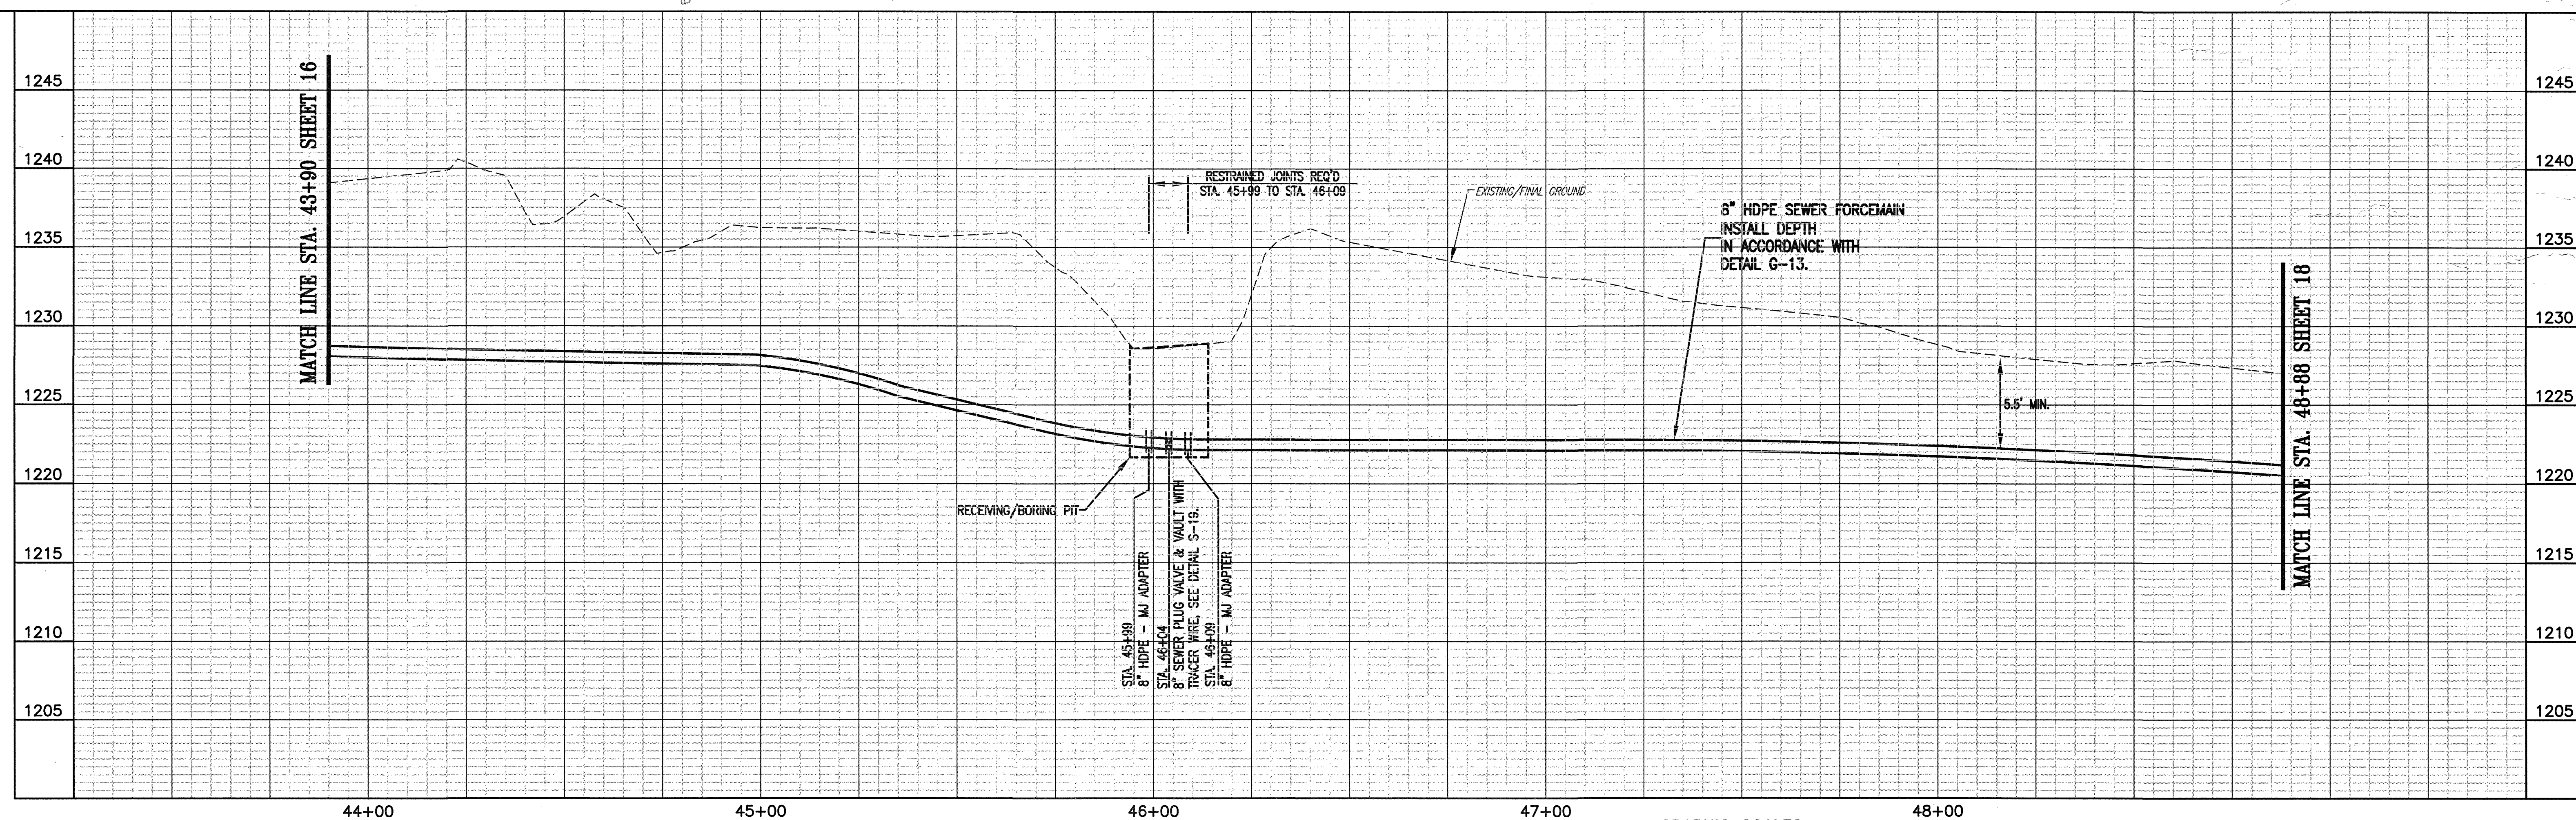


1. ALL PIPE MATERIALS SHALL BE AS SPECIFIED ON THE PIPE SCHEDULE SHOWN ON DRAWING C1.06.

Virgil H. Goode Highway
(Route #220)
Variable Width Right-of-Way

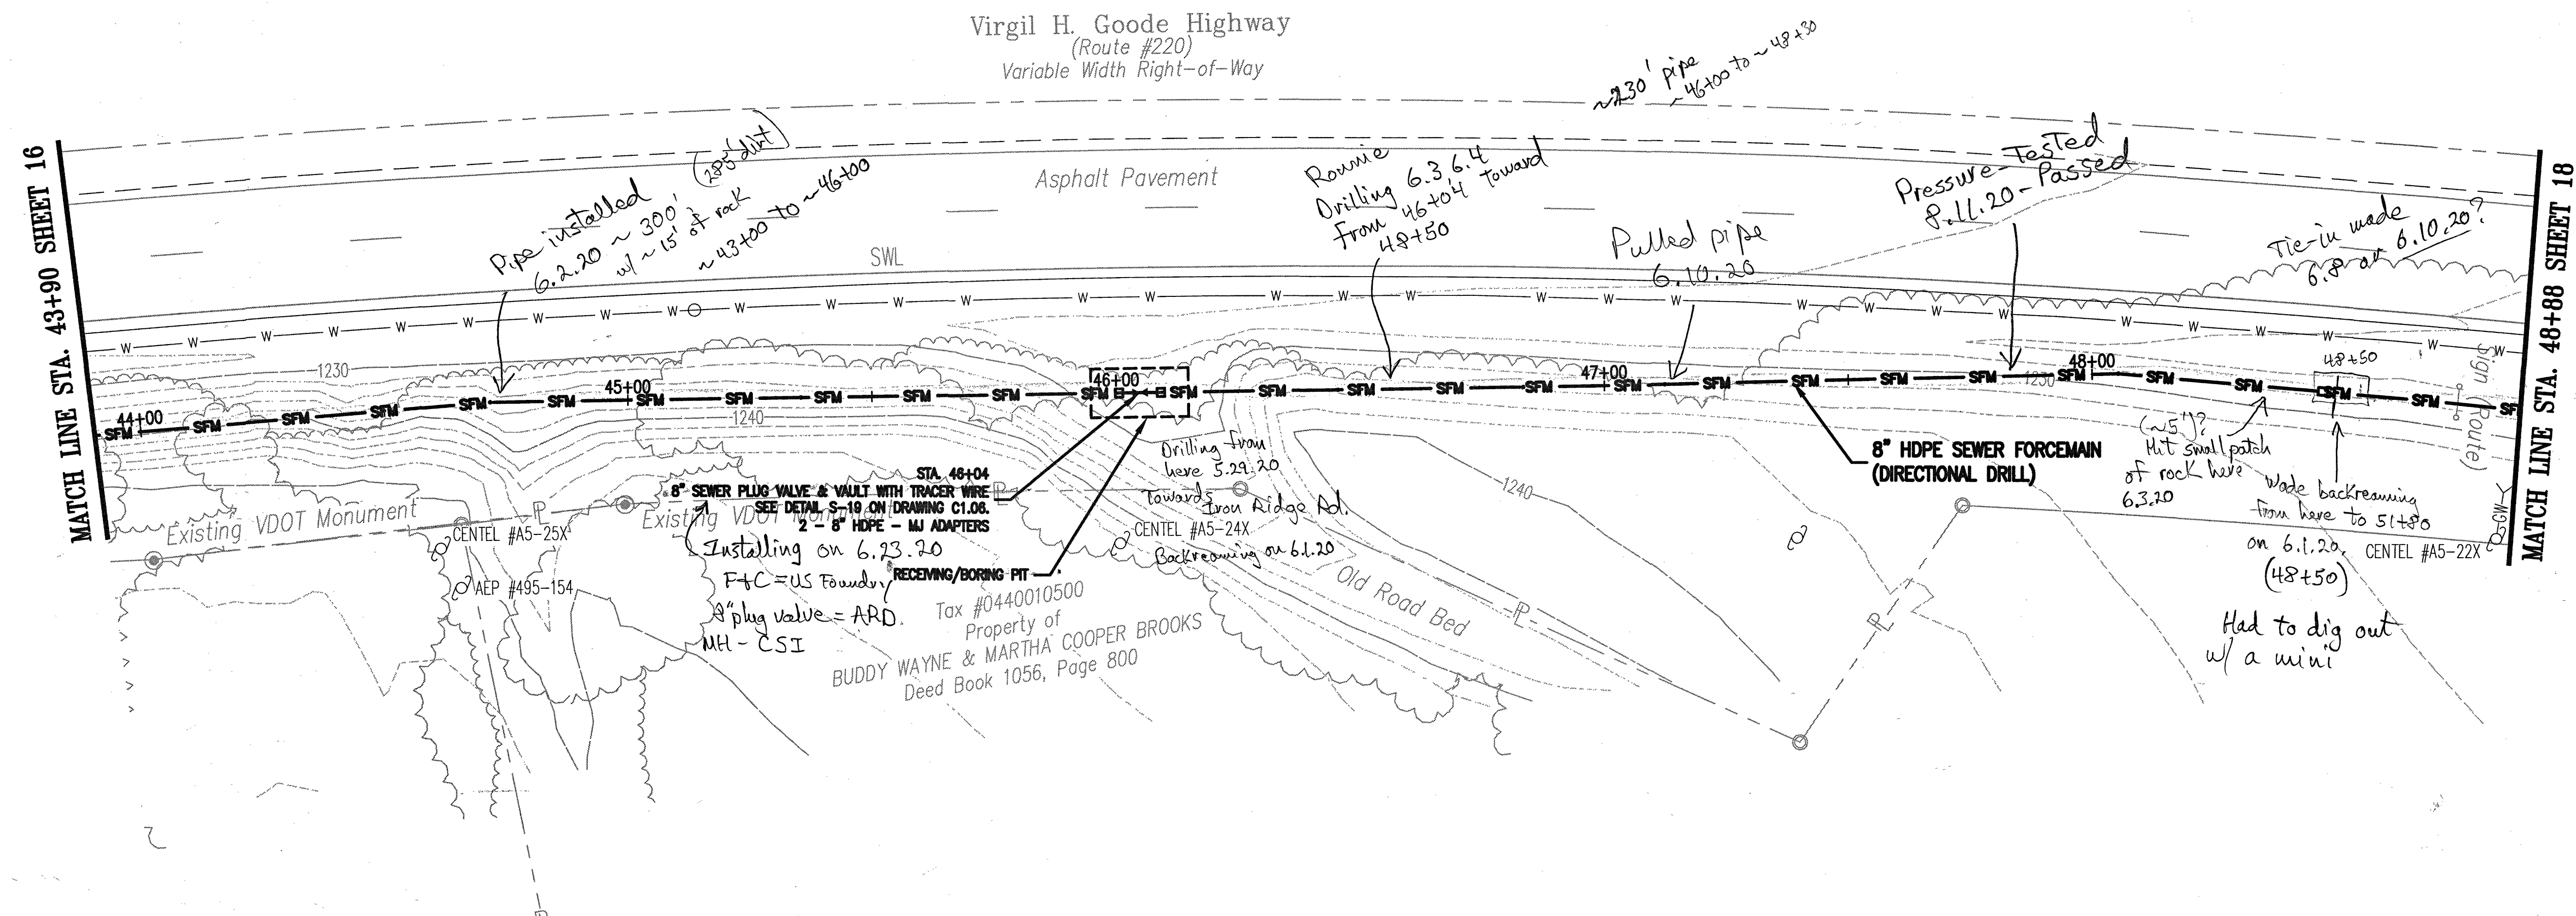

Whitman, Requardt & Associates, LLP
1700 Kraft Dr, Suite 1200, Blacksburg, VA 24060

WESTERN VIRGINIA WATER AUTHORITY
601 South Jefferson Street, Suite 300
Roanoke, Virginia 24011

DES: PJM	SCALE: AS SHOWN
DRAWN: JES	HORIZ: 1" = 20'
CHECK: GWF	VERT: 1" = 5'
DATE: 12/17/18	

GRAPHIC SCALES

47+00

(IN FEET)

HORIZ. 1 inch = 20 feet

48+00

(IN FEET)

VERT: 1 inch = 5 feet

SUMMIT VIEW BUSINESS PARK UTILITY IMPROVEMENTS
PHASE 2

8" SEWER FORCEMAIN PLAN - PROFILE
STA. 43+90 TO STA. 48+88

REV	DATE	DESCRIPTION
DRAWING		SHEET
C1.14		17