

NOTE:

- ALL PIPE MATERIALS SHALL BE AS SPECIFIED ON THE PIPE SCHEDULE SHOWN ON DRAWING C1.06.


Across both sides U.S. Rte. 220 is
Price Ln and Three Brooks Ln

7/14/18


7/15/18

Virgil H. Goode Highway
(Route #220) South
Variable Width Right-of-Way

WATER - MATCH LINE STA. 43+22 SHEET 20
SFM - MATCH LINE STA. 65+31 SHEET 20

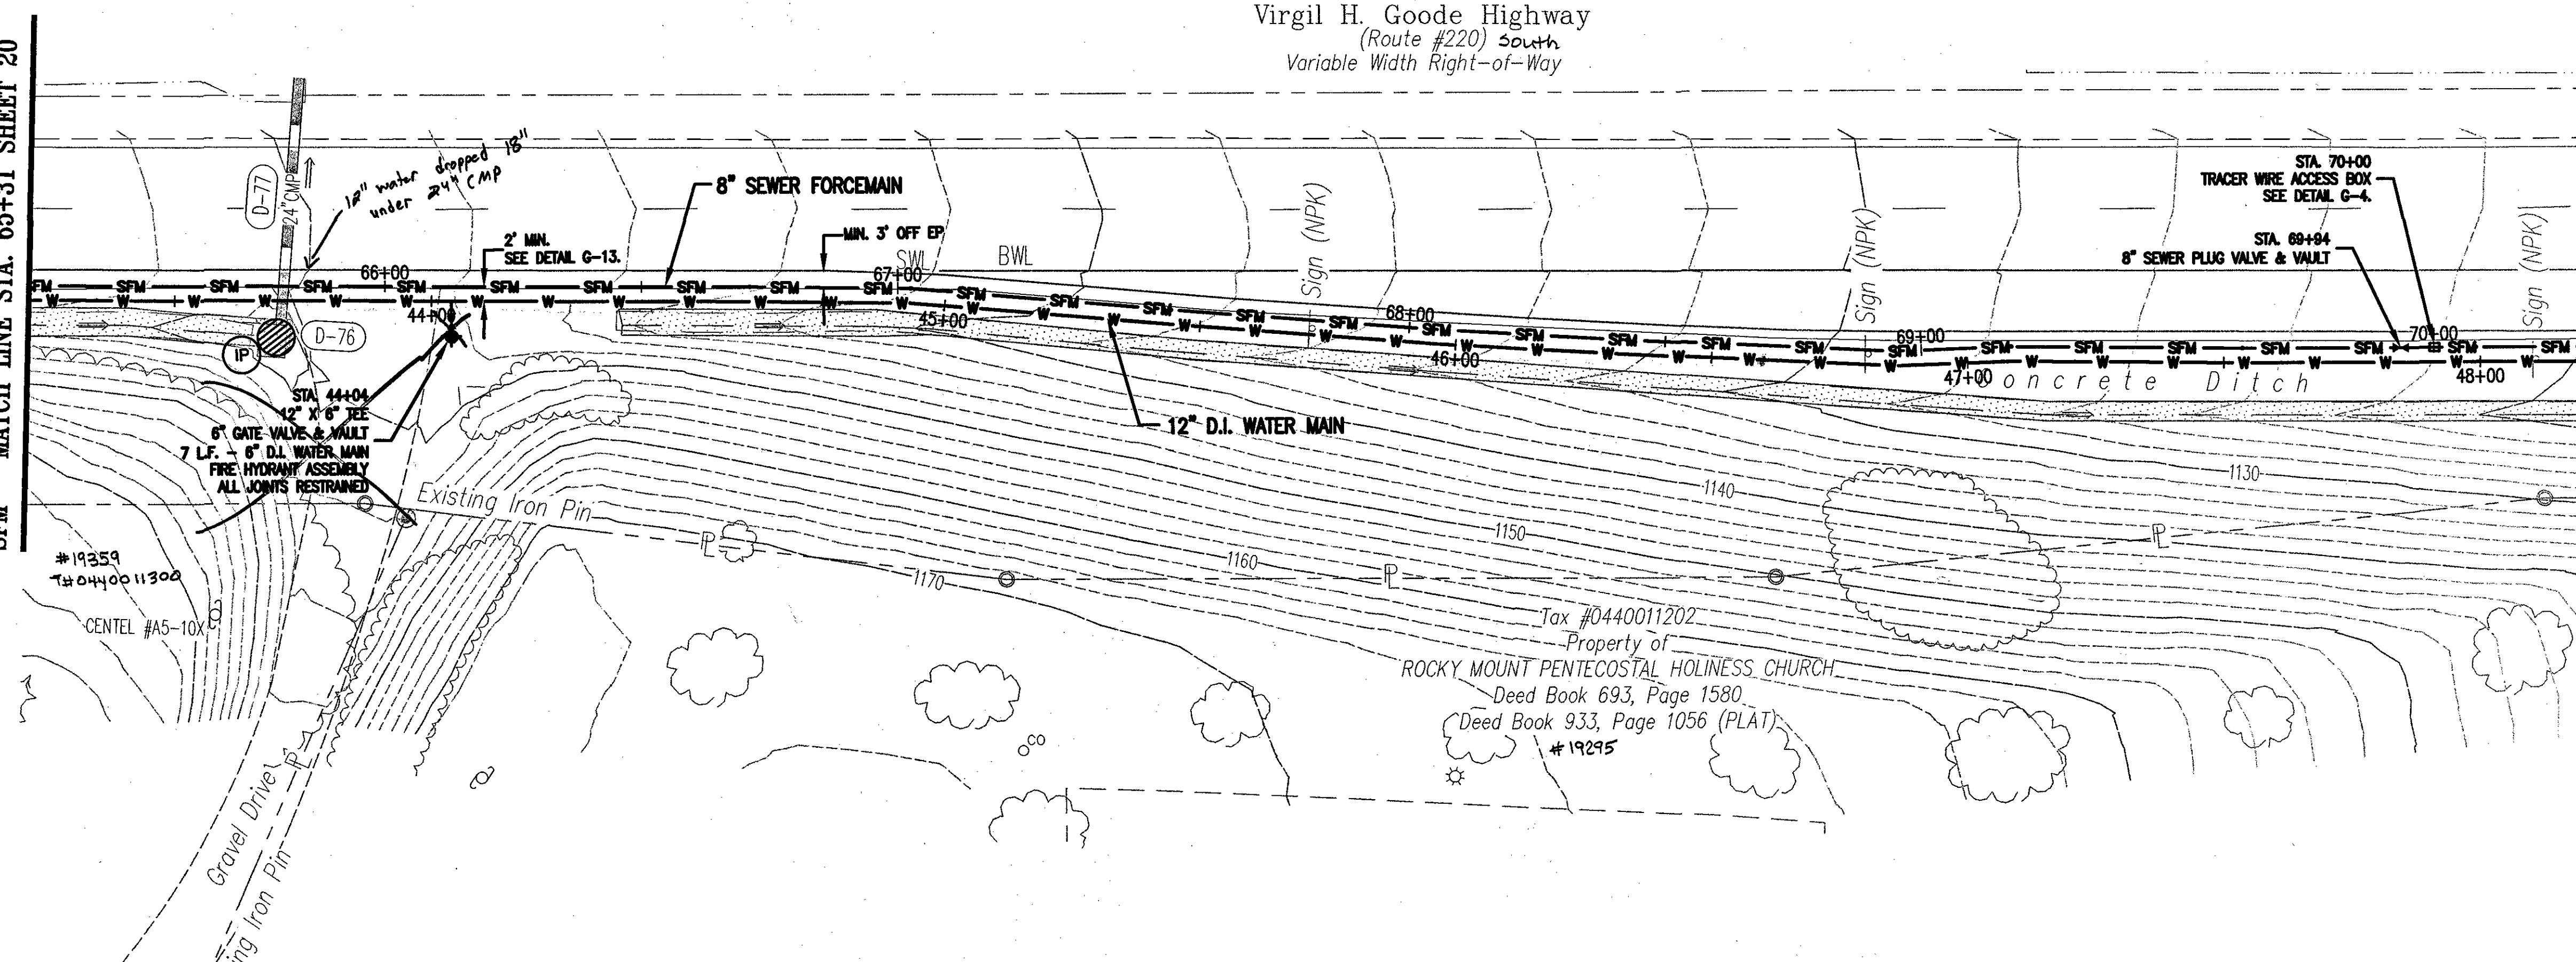

WATER - MATCH LINE STA. 48+22 SHEET 22
SFM - MATCH LINE STA. 70+31 SHEET 22

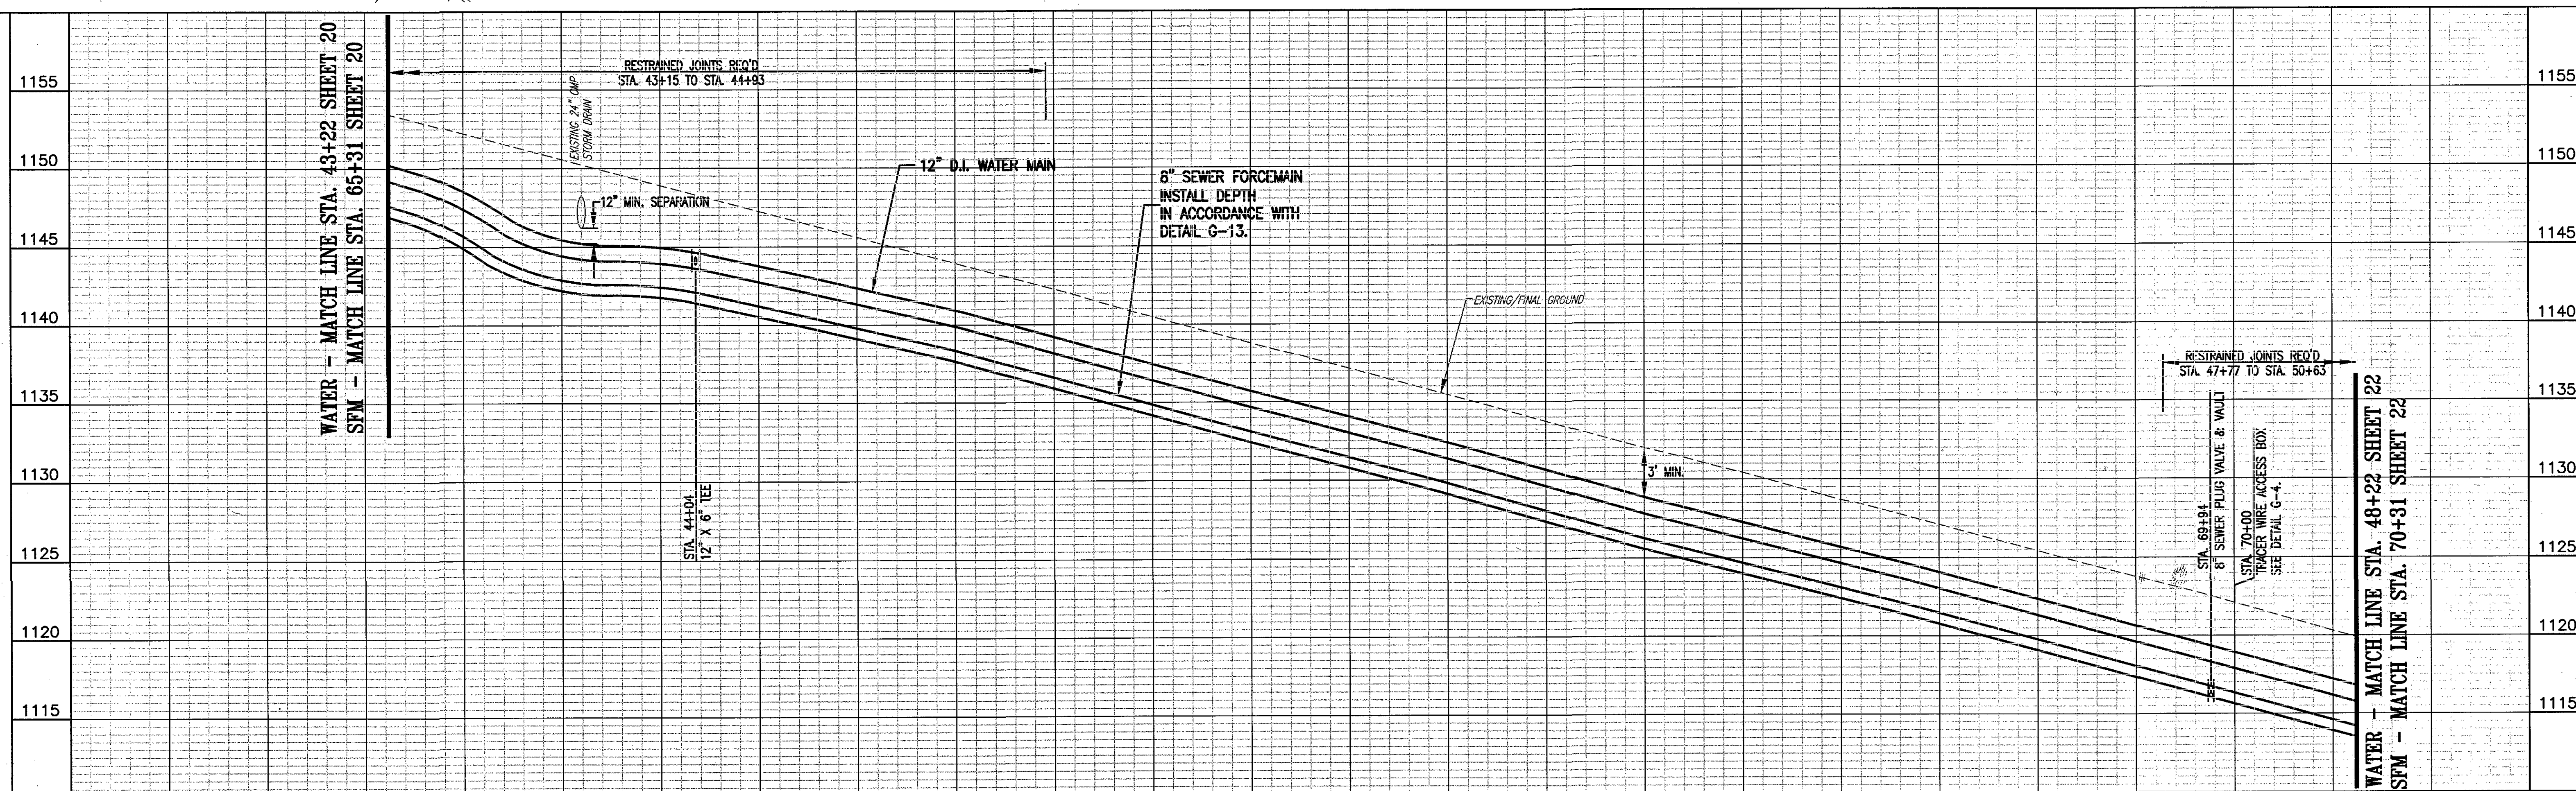

44+00 45+00 46+00 47+00 48+00 66+00 67+00 68+00 69+00 70+00



WESTERN VIRGINIA WATER AUTHORITY
601 South Jefferson Street, Suite 300
Roanoke, Virginia 24011

DES: KN
DRAWN: JES
CHECK: GWP
DATE: 06/15/18

SCALE: AS SHOWN
HORIZ: 1" = 20'
VERT: 1" = 5'

SUMMIT VIEW BUSINESS PARK UTILITY IMPROVEMENTS
PHASE 2

WATER ONLY INSTALLED

8" SEWER FORCEMAIN PLAN - PROFILE
STA. 65+31 TO STA. 70+31
12" WATER MAIN PLAN - PROFILE
STA. 43+22 TO STA. 48+22

DRAWING
C1.18
SHEET
21