


NOTE:

- ALL PIPE MATERIALS SHALL BE AS SPECIFIED ON THE PIPE SCHEDULE SHOWN ON DRAWING C1.06.
- IN THE EVENT CONTRACTOR DAMAGES EXISTING PAVEMENT, CONTRACTOR SHALL MILL AND RE-PAVE WITH SURFACE MIX (1.5-INCH DEEP) ONE LANE OF ROADWAY AT NO COST TO THE OWNER.



Across both lanes of U.S. Rte 220 is Bonbrake Mill Rd

WATER - MATCH LINE STA. 58+22 SHEET 23
SFM - MATCH LINE STA. 80+31 SHEET 23


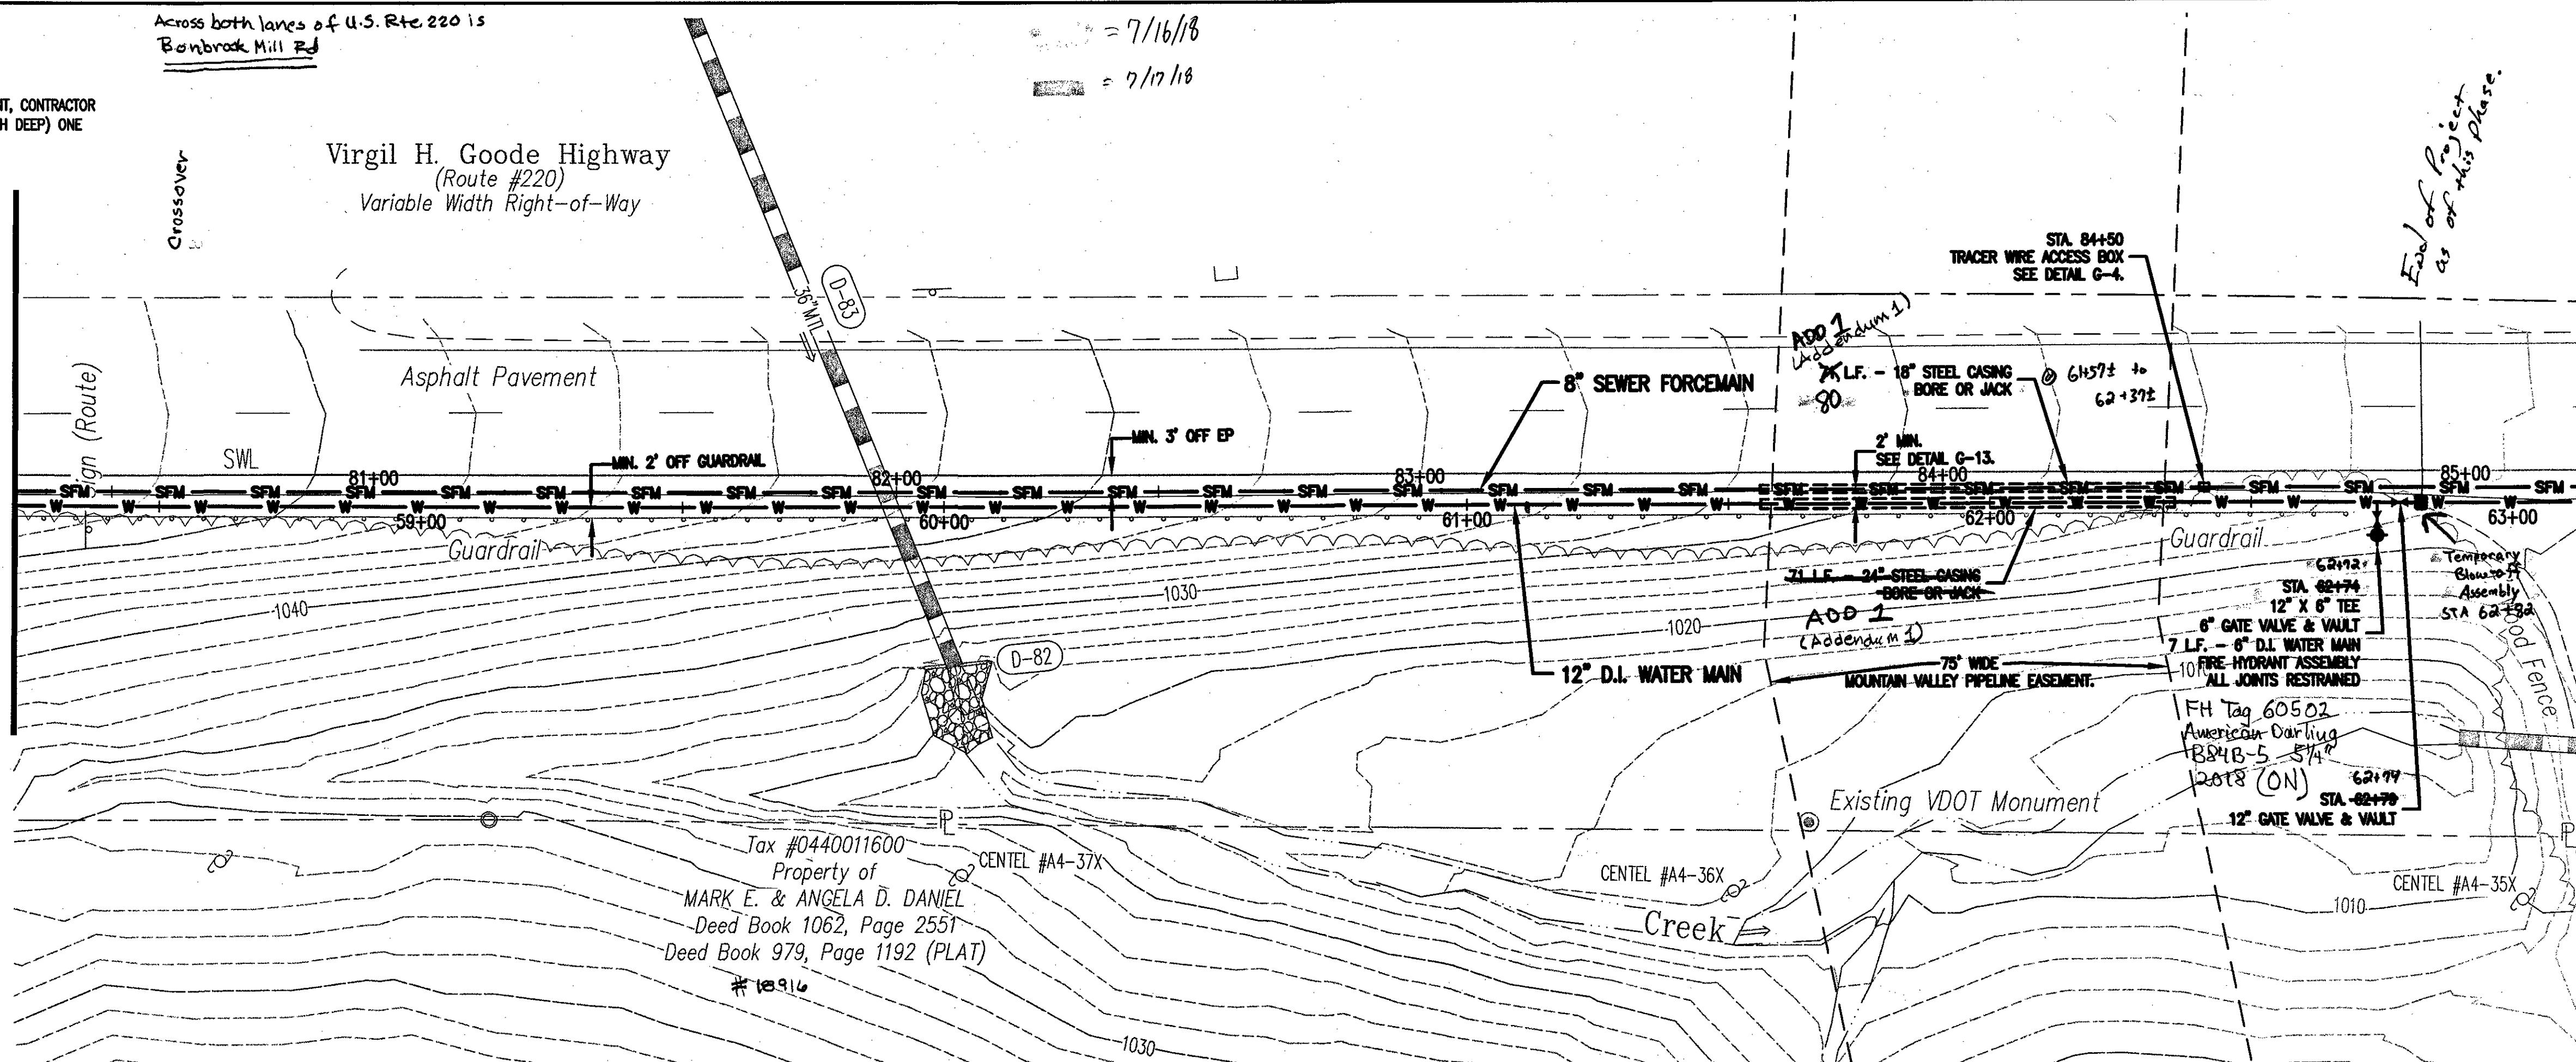


WATER - MATCH LINE STA. 63+22 SHEET 25
SFM - MATCH LINE STA. 85+31 SHEET 25

NOT TO SCALE

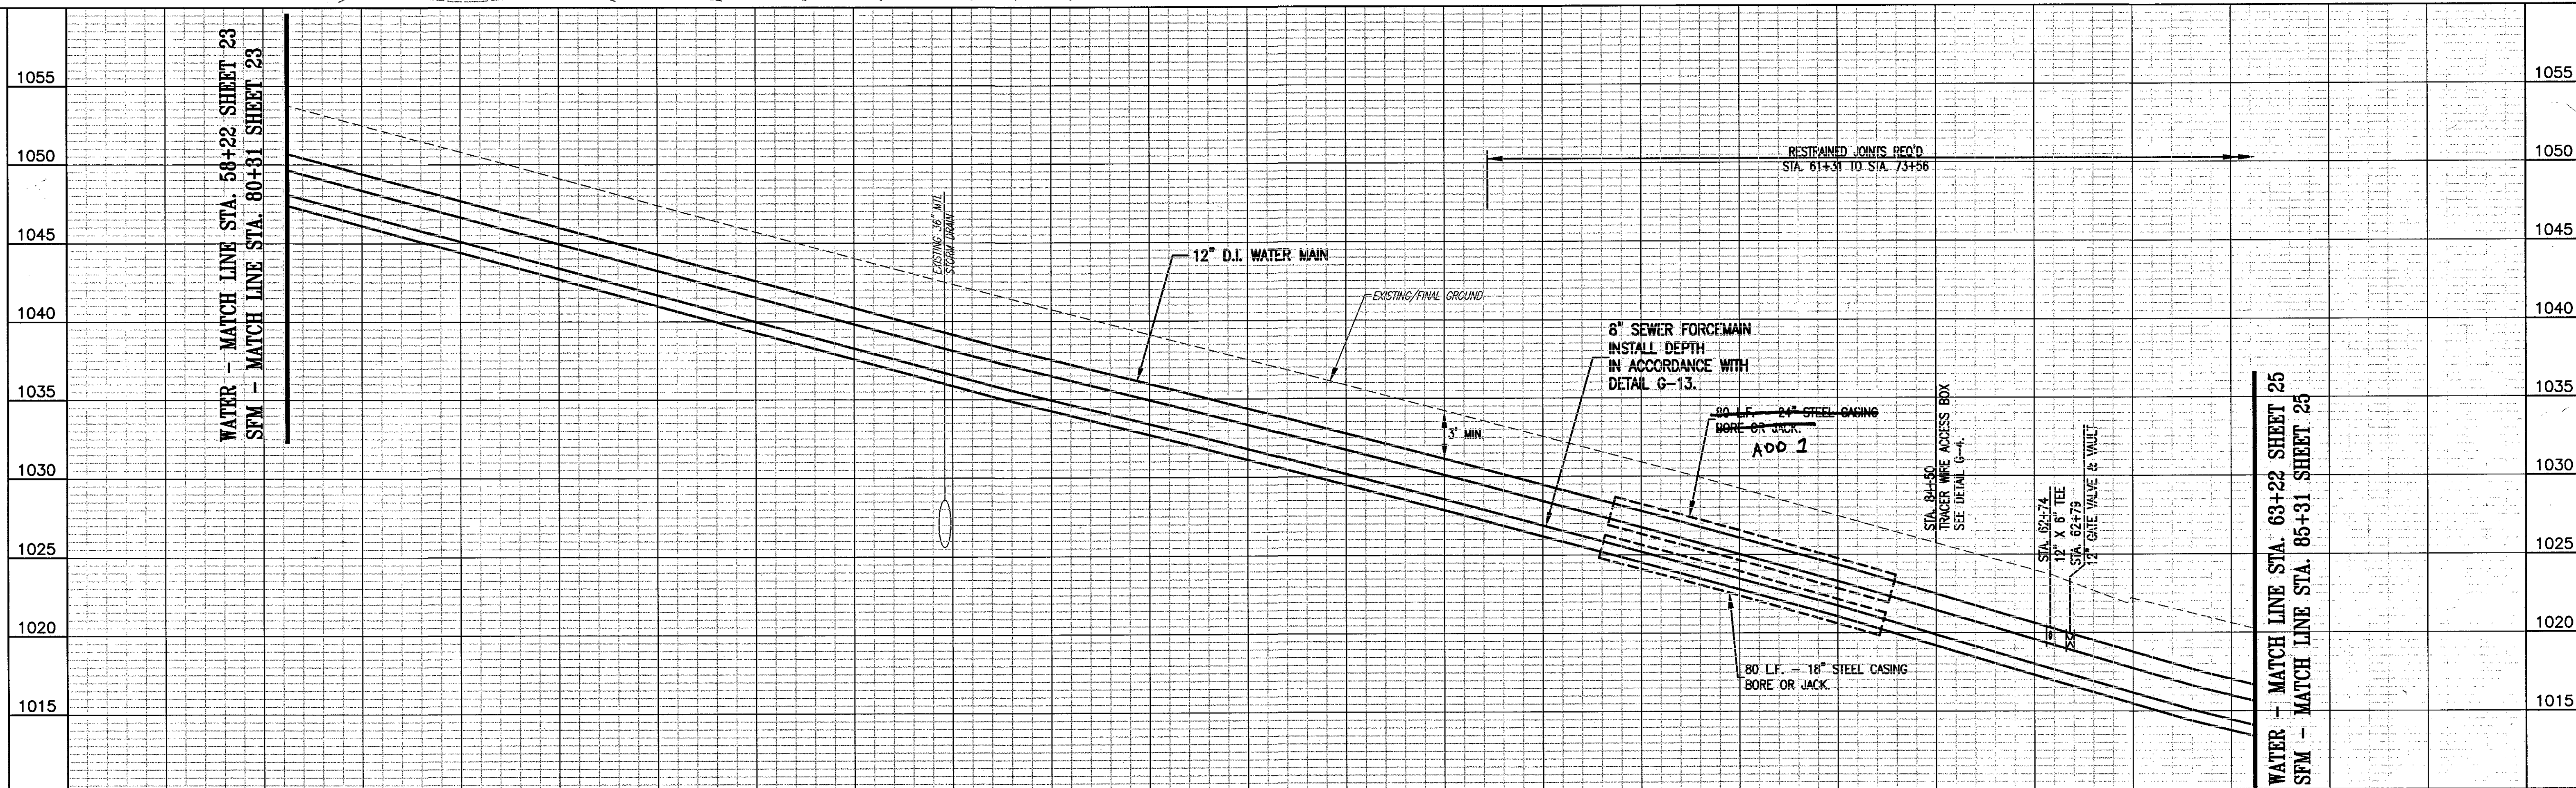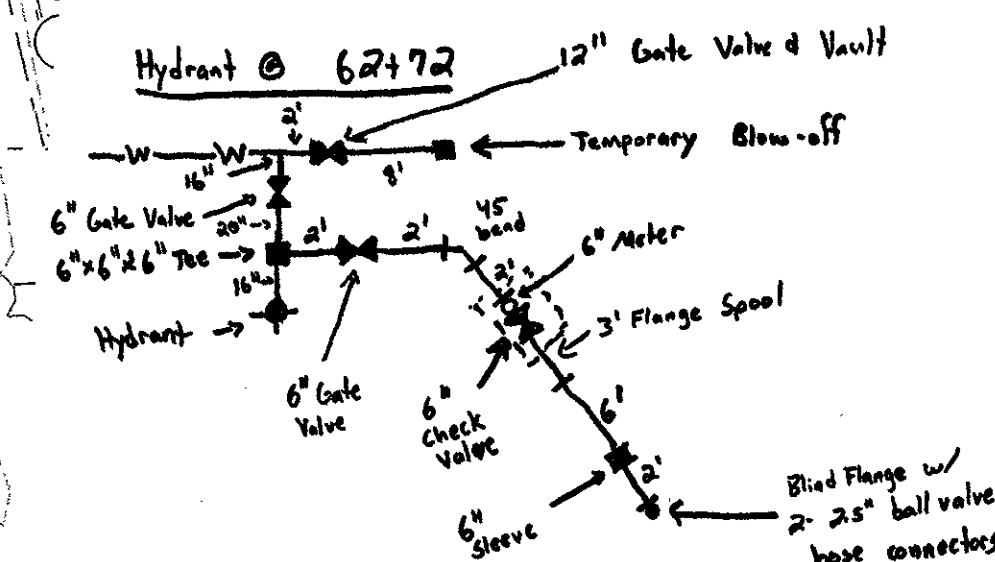

WATER ONLY INSTALLED

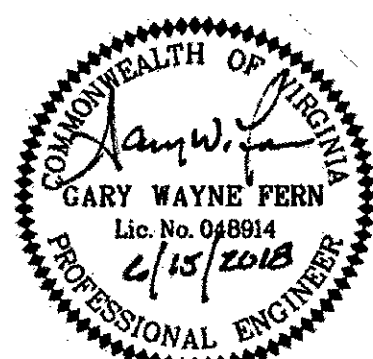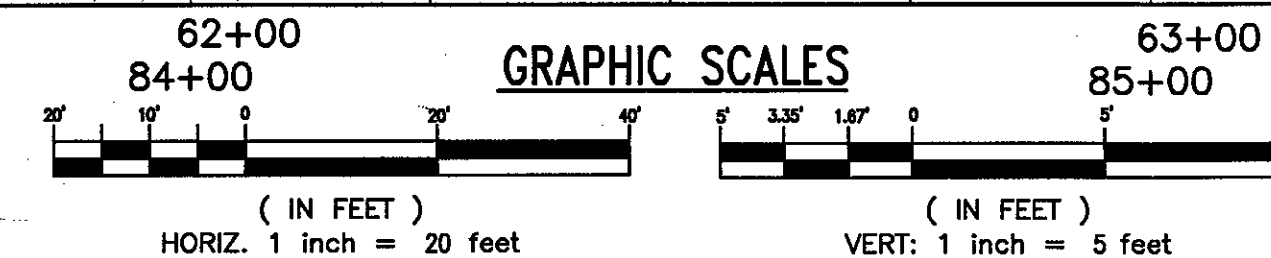

WESTERN VIRGINIA WATER AUTHORITY
601 South Jefferson Street, Suite 300
Roanoke, Virginia 24011

DES: KN
DRAWN: JES
CHECK: GWF
DATE: 06/15/18

SCALE: AS SHOWN
HORIZ: 1" = 20'
VERT: 1" = 5'

SUMMIT VIEW BUSINESS PARK UTILITY IMPROVEMENTS
PHASE 2

8" SEWER FORCEMAIN PLAN - PROFILE
-STA. 80+31 TO STA. 85+31-
12" WATER MAIN PLAN - PROFILE
STA. 58+22 TO STA. 63+22

REV DATE DESCRIPTION

C1.21

SHEET
24