

SITE IMPROVEMENTS CONTRACT SI-3

SECTION 5

GAINSBORO NEIGHBORHOOD DEVELOPMENT PROGRAM

CITY OF ROANOKE REDEVELOPMENT AND HOUSING AUTHORITY


ROANOKE, VIRGINIA

HAYES, SEAY, MATTERN & MATTERN

ARCHITECTS - ENGINEERS - PLANNERS

ROANOKE, VA ROCKVILLE, MD VIRGINIA BEACH, VA

**AS BUILT
DRAWING**

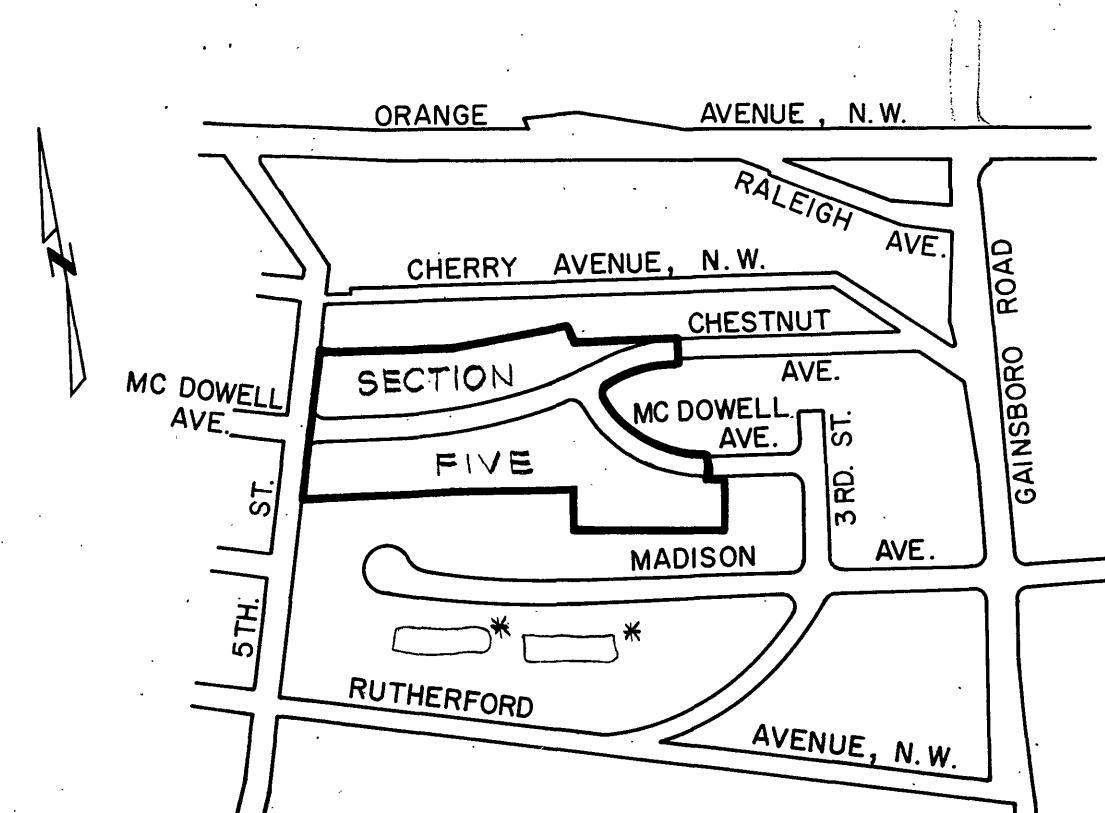


PROJECT LOCATION MAP
NO SCALE

* APPROXIMATE LOCATION OF EXISTING
BORROW MATERIAL STOCKPILES.

INDEX OF SHEETS	
SHEET NO.	TITLE
0	TITLE SHEET & LOCATION PLAN
G-1	ABBREVIATIONS & LEGEND
1	DIMENSIONAL LAYOUT GRADING & DRAINAGE PLAN TYPICAL STREET SECTION GENERAL NOTES
2	SANITARY SEWER & WATER PLAN
3	PROFILES

APPROVED

SIGNATURE	TITLE	AGENCY	DATE
<i>Thomas G. L. Reddy</i>	CITY ENGINEER	CITY OF ROANOKE, VA.	6-26-78
<i>William W. Mattern</i>	AGENT	CITY OF ROANOKE PLANNING COMMISSION	26 Jan 79

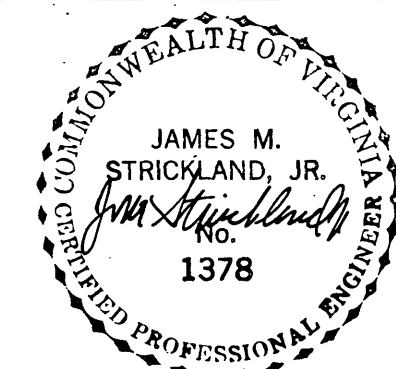

COMM. 3756 C DATE 24 MAR. 1978 SHEET 0