
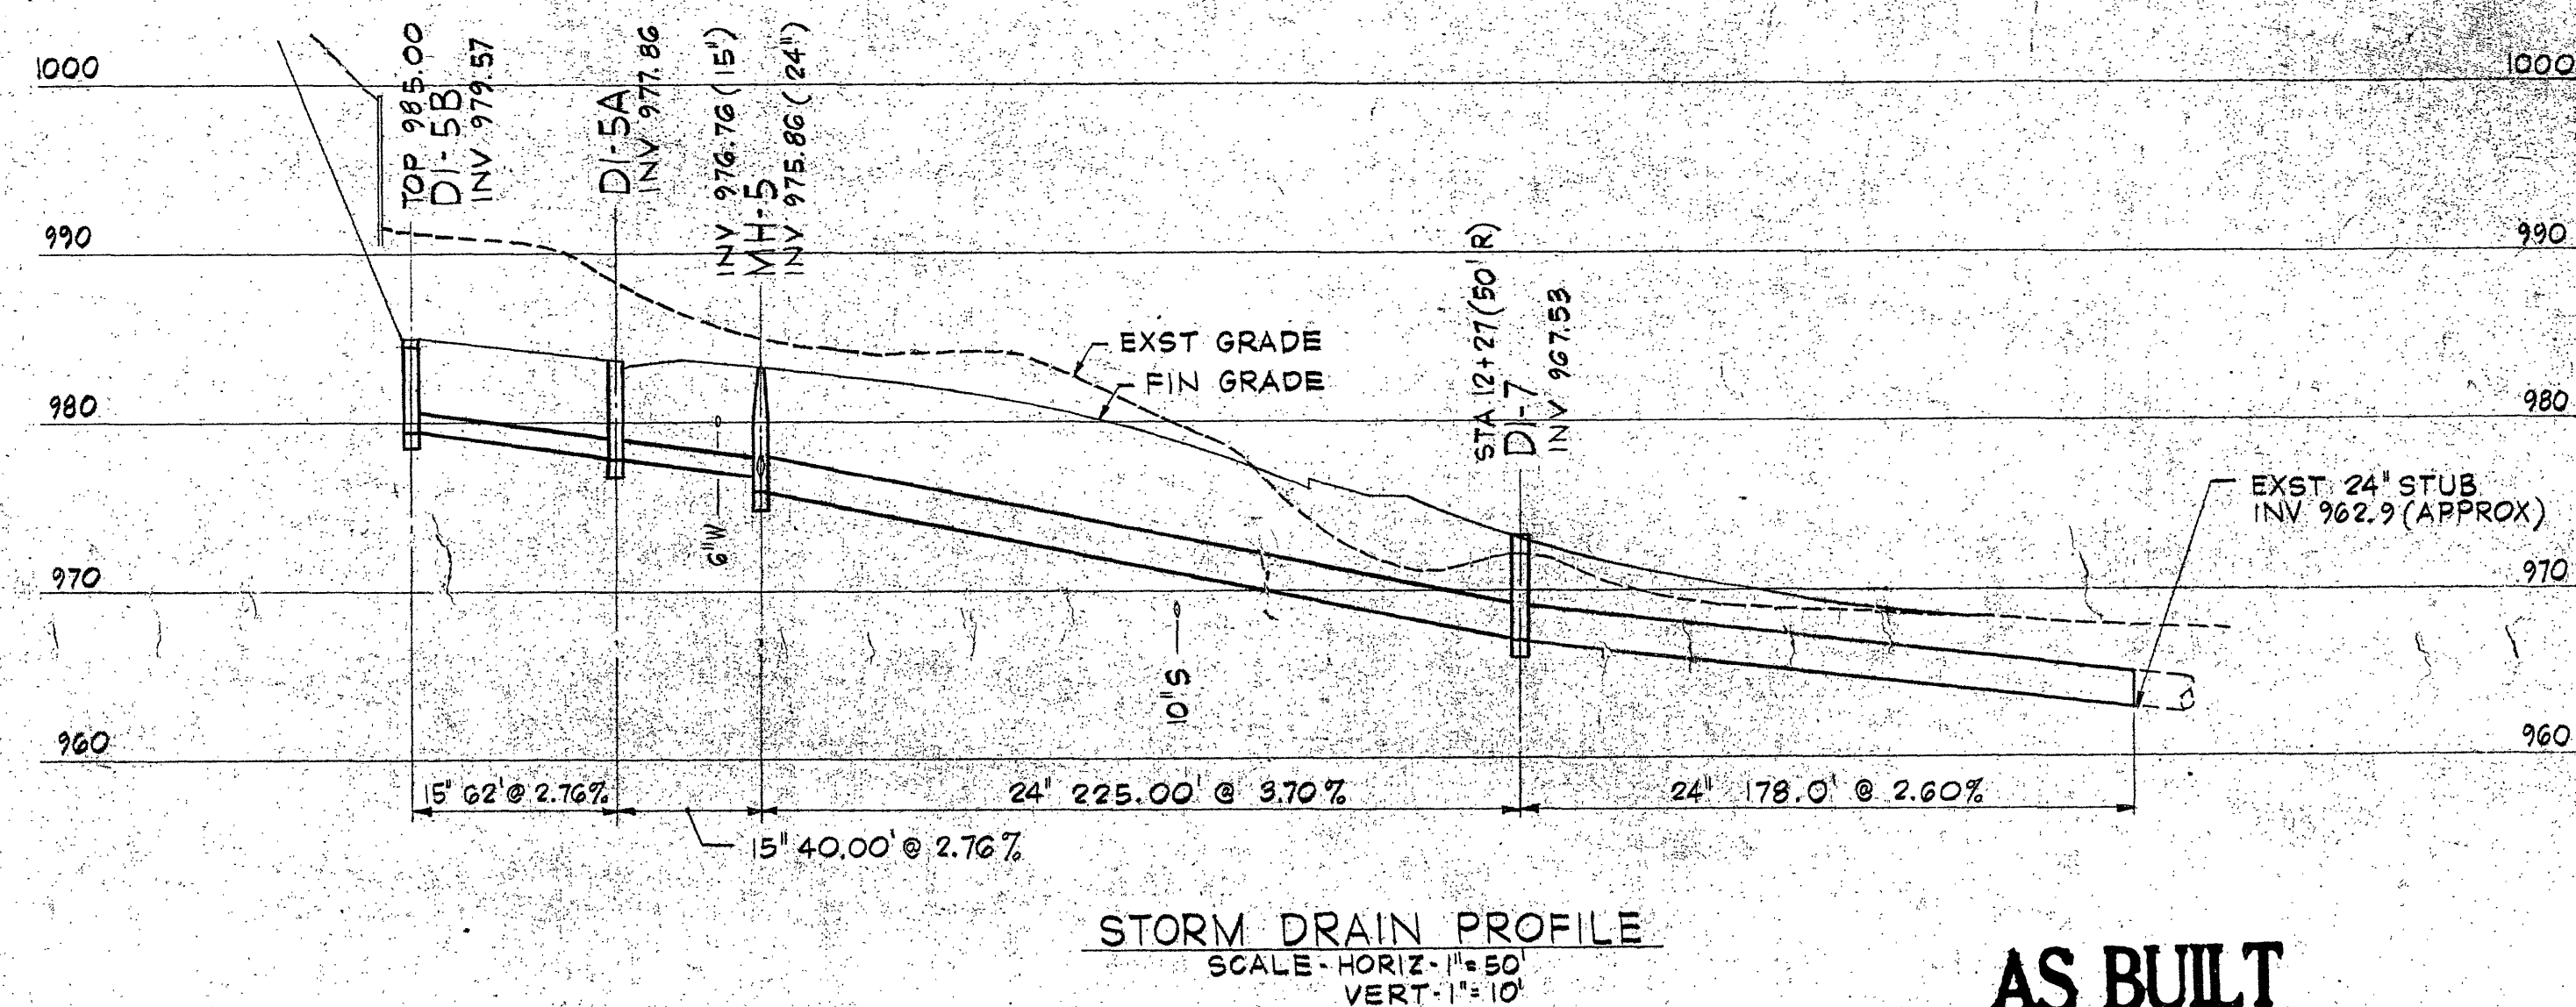
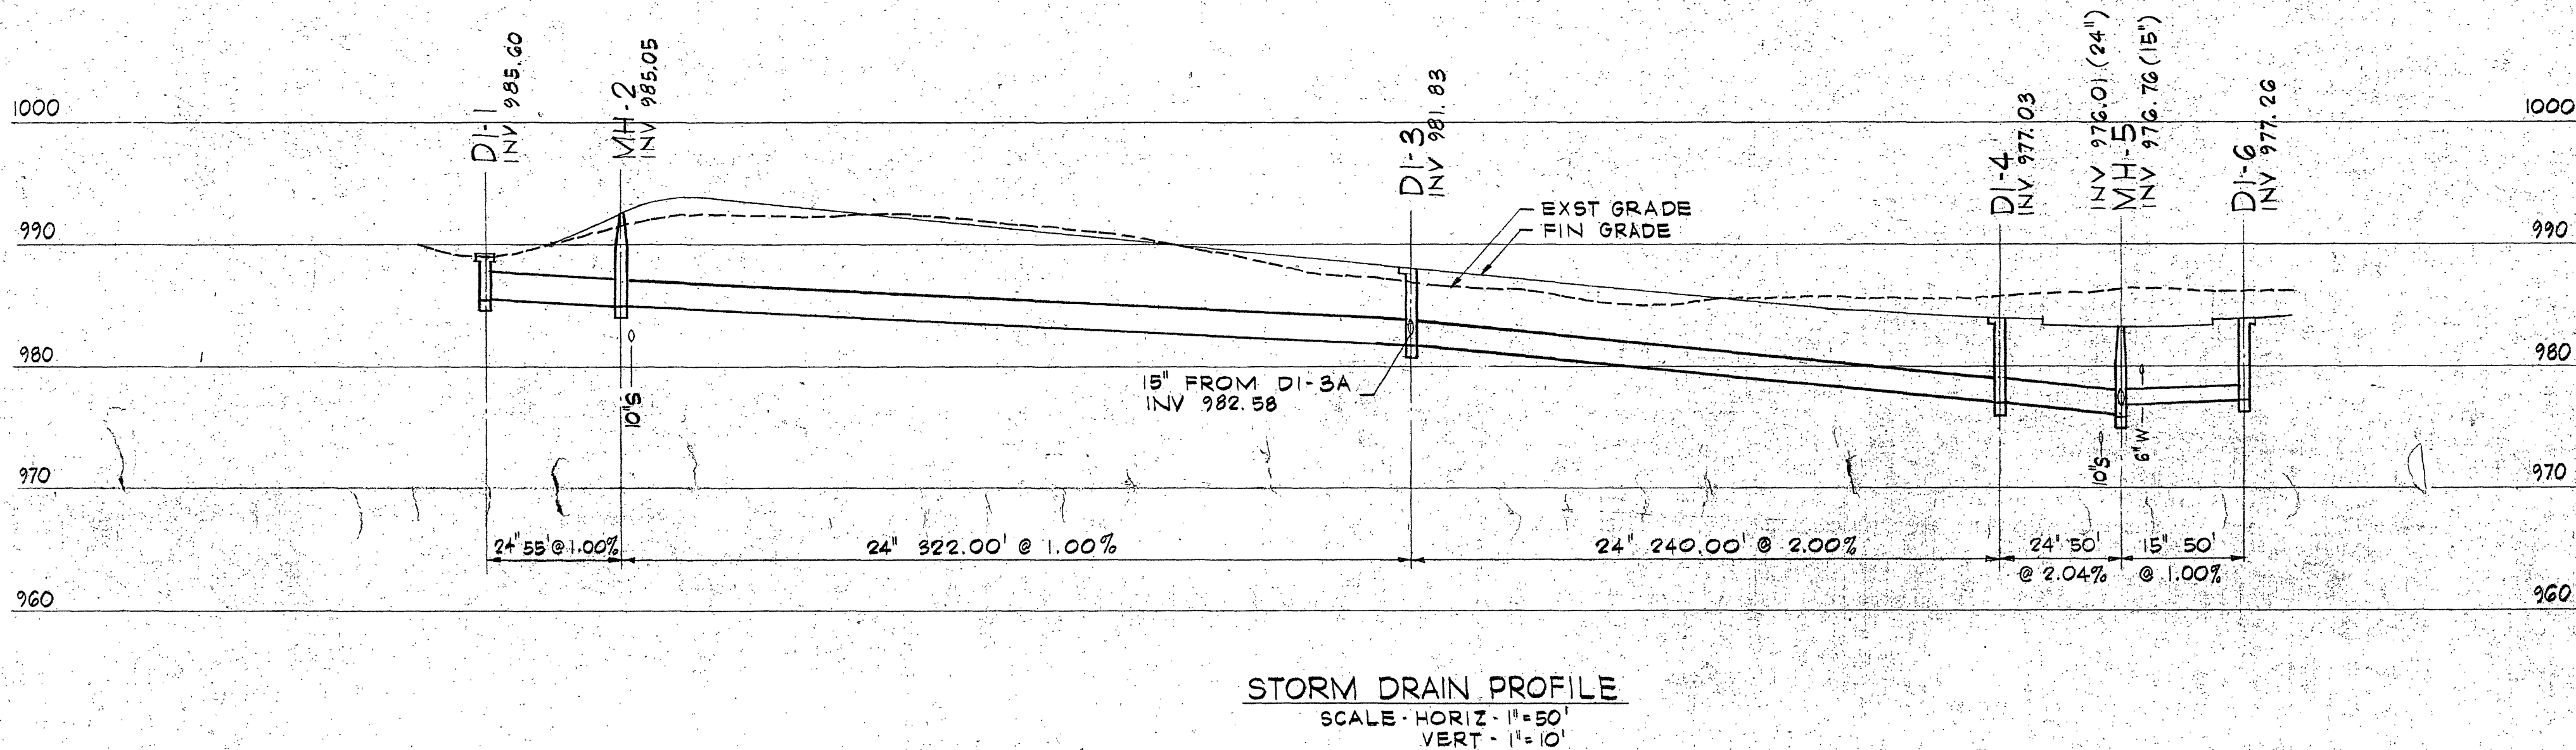
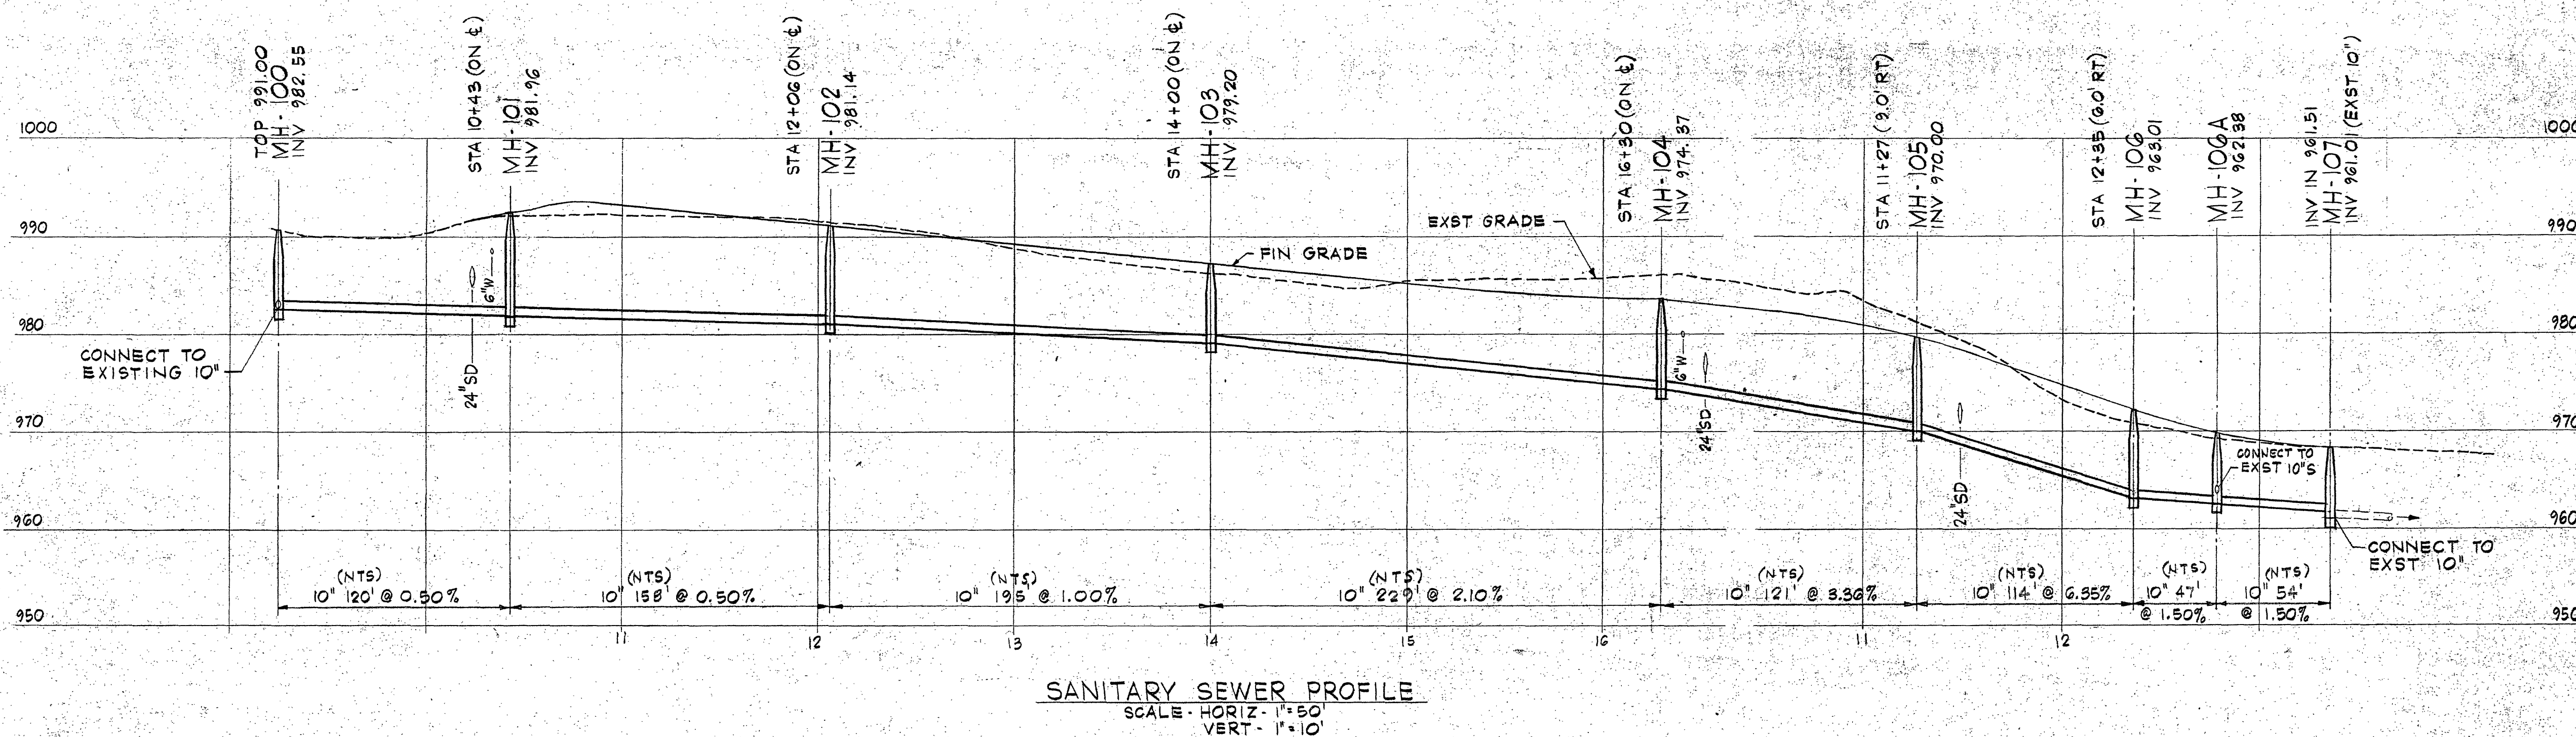
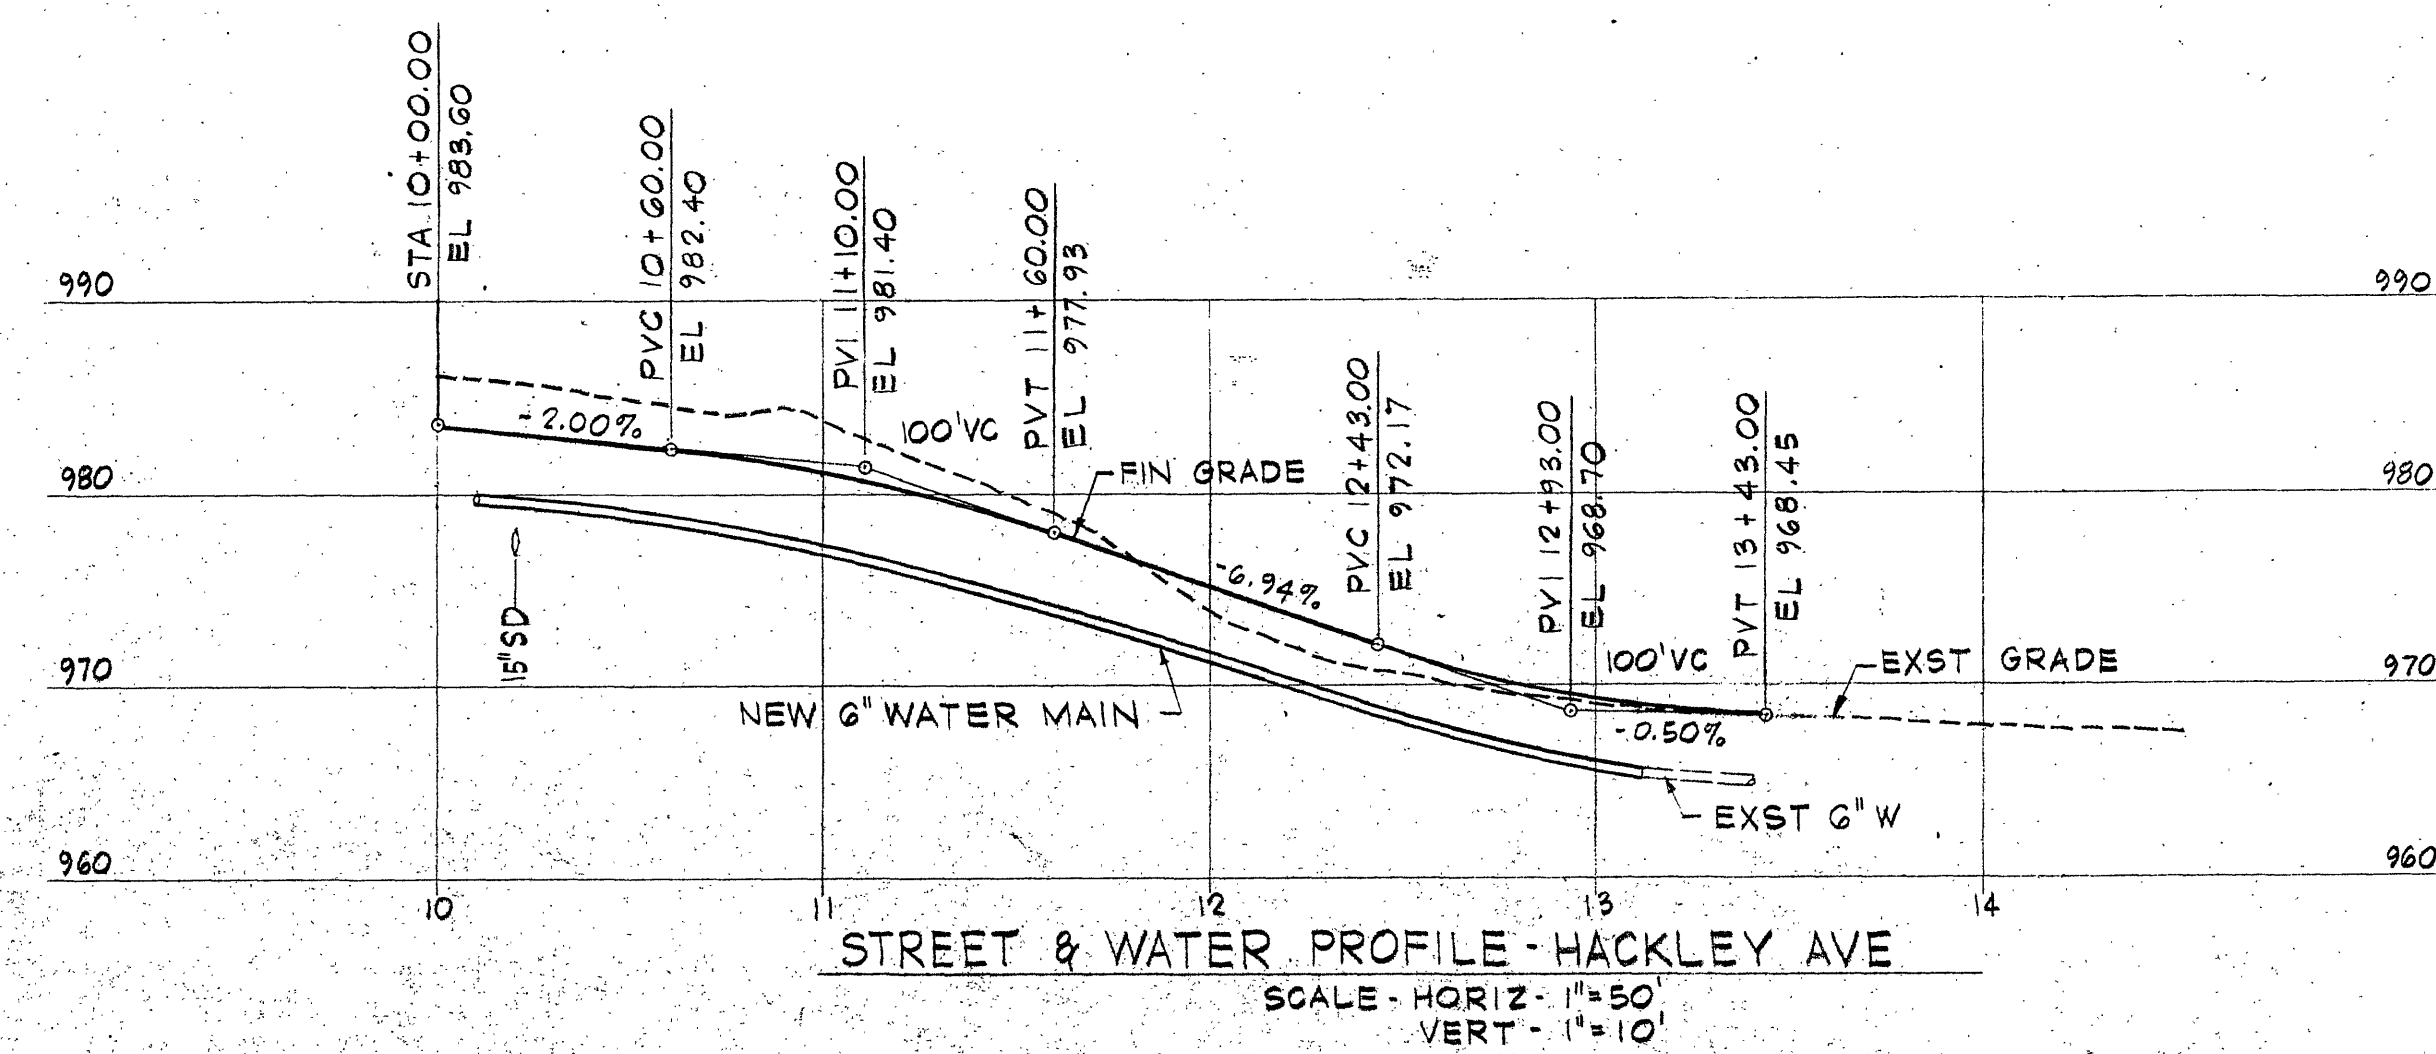


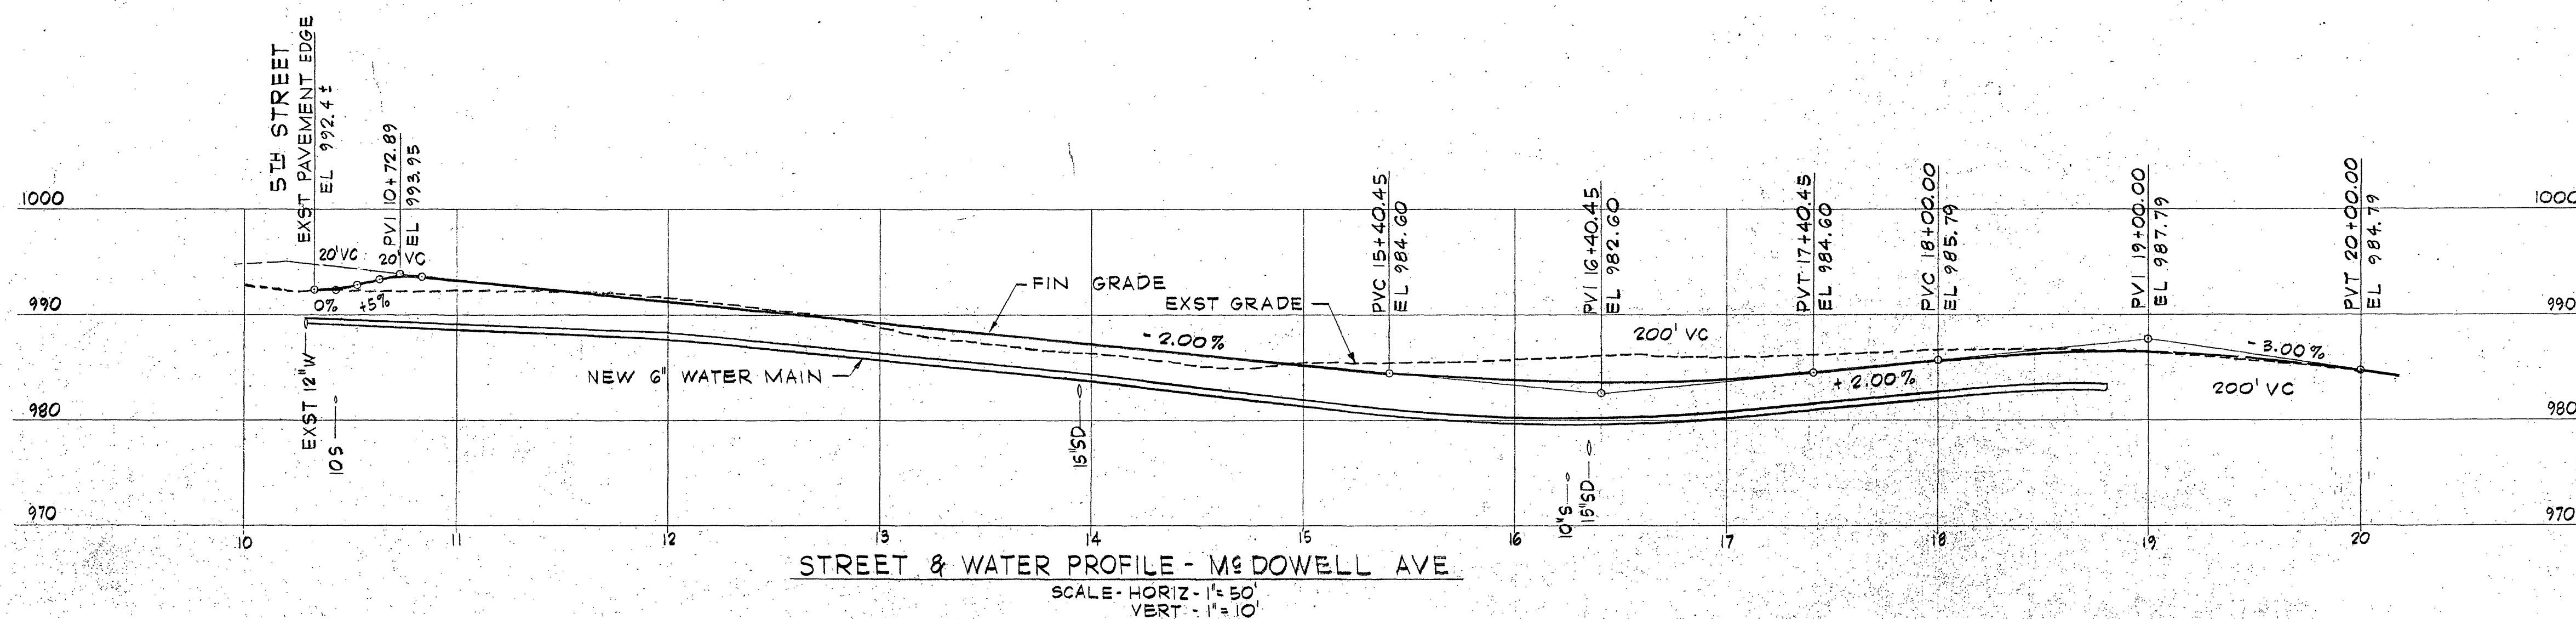

AS BUILT
DRAWING

DESIGNED	J.H.M.	DATE	10-15-79	AS BUILT	BY	J.H.M.
DRAWN	J.H.M.	DATE	6-2-78	ADDED NEW STREET NAMES PER CITY OF ROKE PLANNING DEPT.	BY	J.H.M.
CHECKED	J.H.M.	DATE			BY	
APPROVED	J.H.M.	DATE			BY	
SUBMITTED	J.H.M.	DATE			BY	
SITE IMPROVEMENTS CONTRACT SI-3 SECTION FIVE GAINSBORO NEIGHBORHOOD DEVELOPMENT PROGRAM						PROFILES
HAYES, SEAY, MATTERN & MATTERN ARCHITECTS - ENGINEERS - PLANNERS ROANOKE, VIRGINIA RICHMOND, VIRGINIA WASHINGTON, D.C.						SCALE AS NOTED DATE 24 MAR 1978
						COMM. NO. 3753C SHEET 3