

0	TITLE SHEET
1	SHEET INDEX MAP
2	QUANTITY SHEET
3	ABBREVIATIONS AND LEGEND
4 - 15	PLANS AND PROFILES
16 - 17	



OFFICE OF CITY ENGINEER


CONSTRUCTION PLAN

GLADE CREEK SANITARY SEWER INTERCEPTOR

PREPARED BY

MATTER and CRAIG

AS BUILT

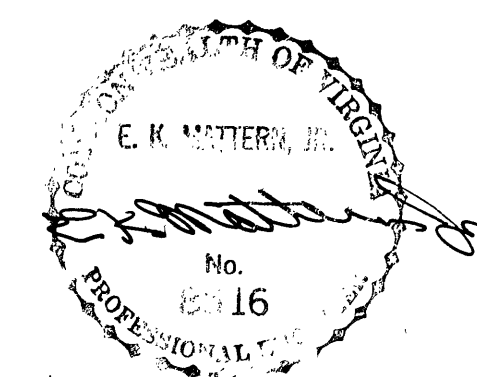

SHEET NO.	DATE	SHEET NO.	DATE

PLANS REVISED

[illegible]

<u>APPROVED</u>
<u>DATE</u>

SHEET 0 OF 17

SET NO.

PLAN NO. 5670