



23+00 24+00 25+00 26+00 27+00 27+50

STATE	FEDERAL AID	ROUTE	PROJECT
MA.			

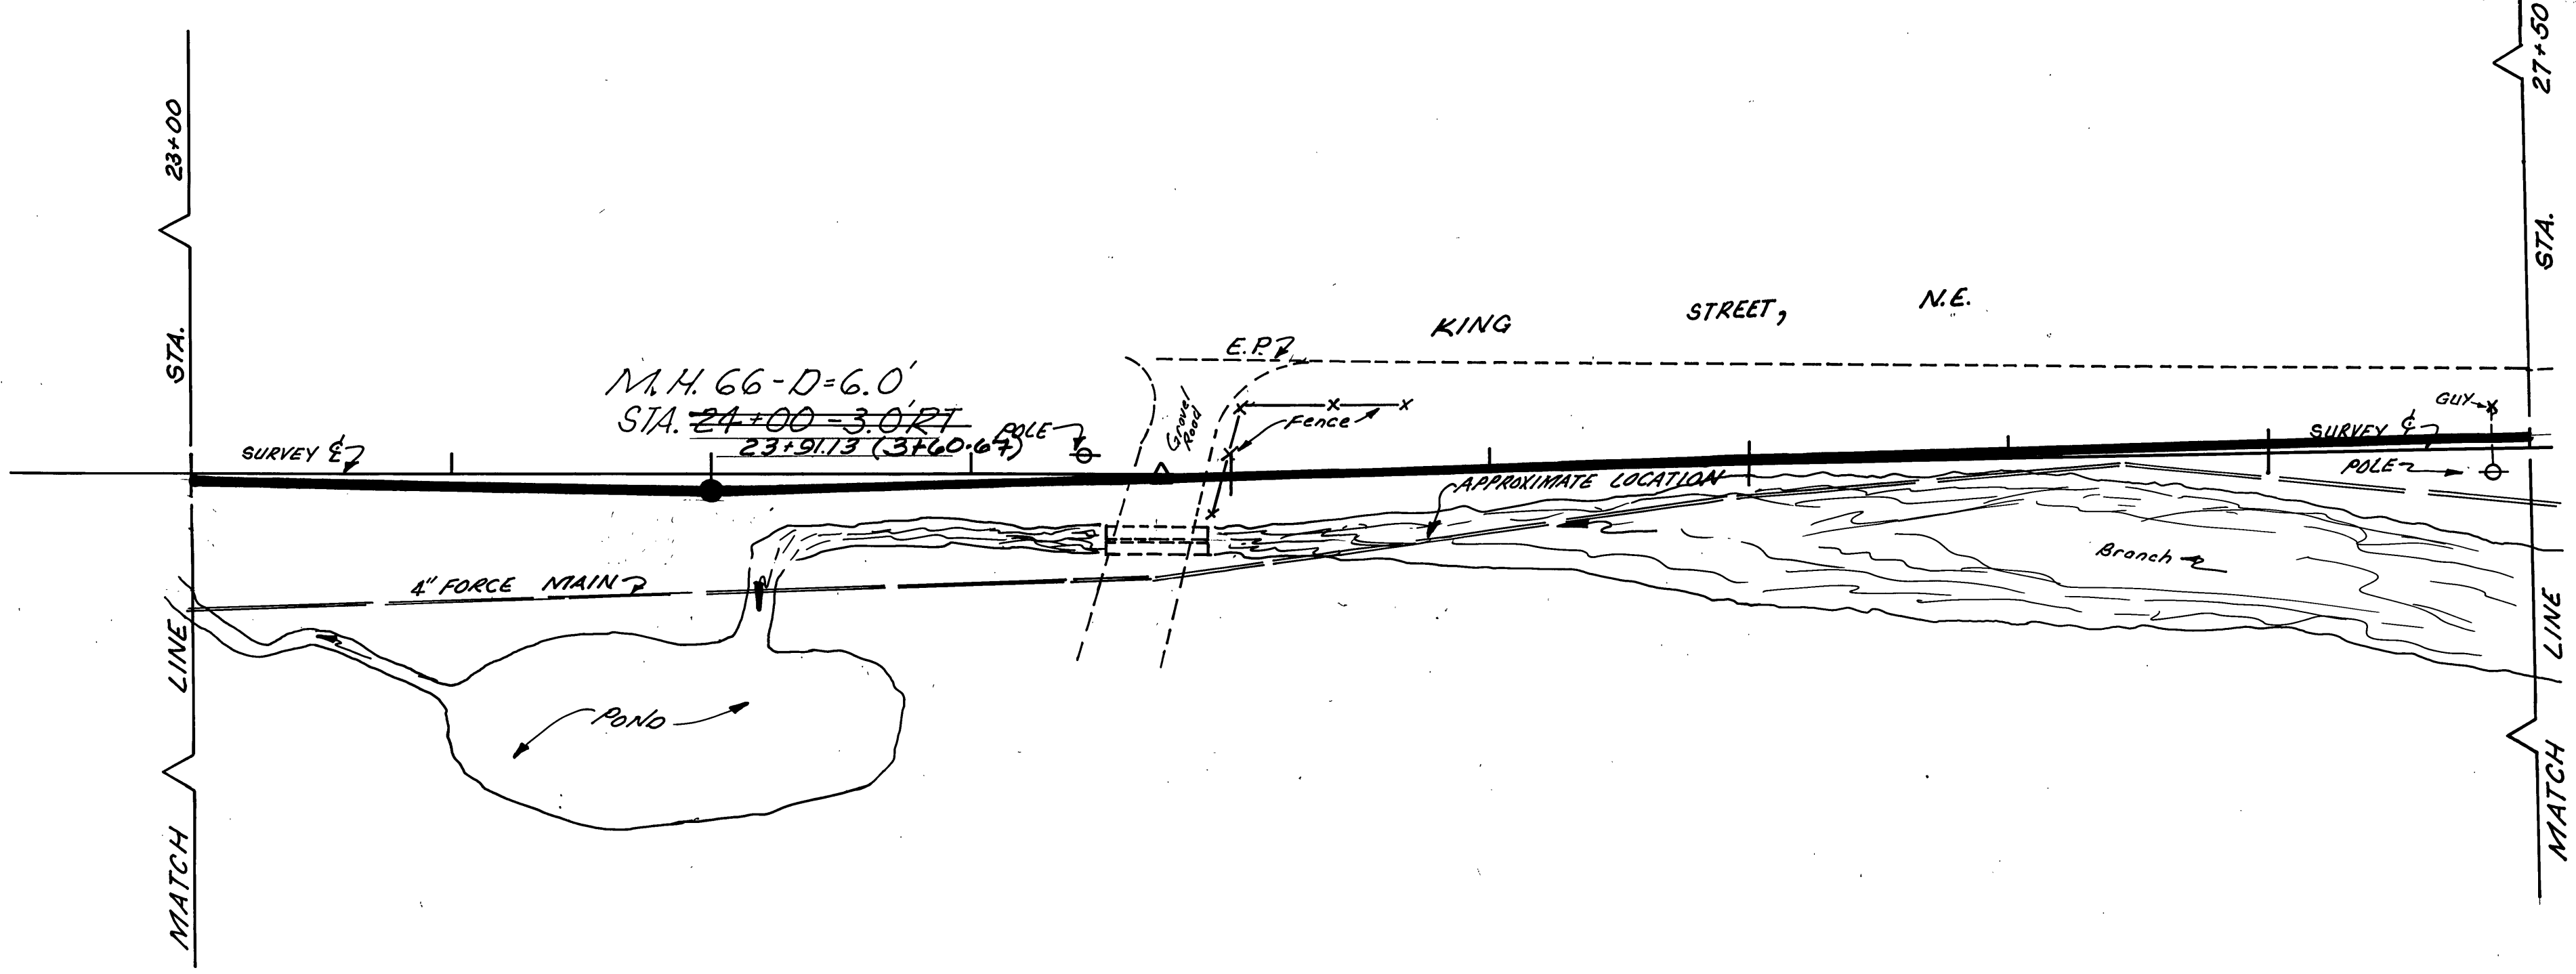

PLAN SCALE: 1" = 25'

PROFILE SCALE: HORIZ. 1" = 25'
VERT. 1" = 10'

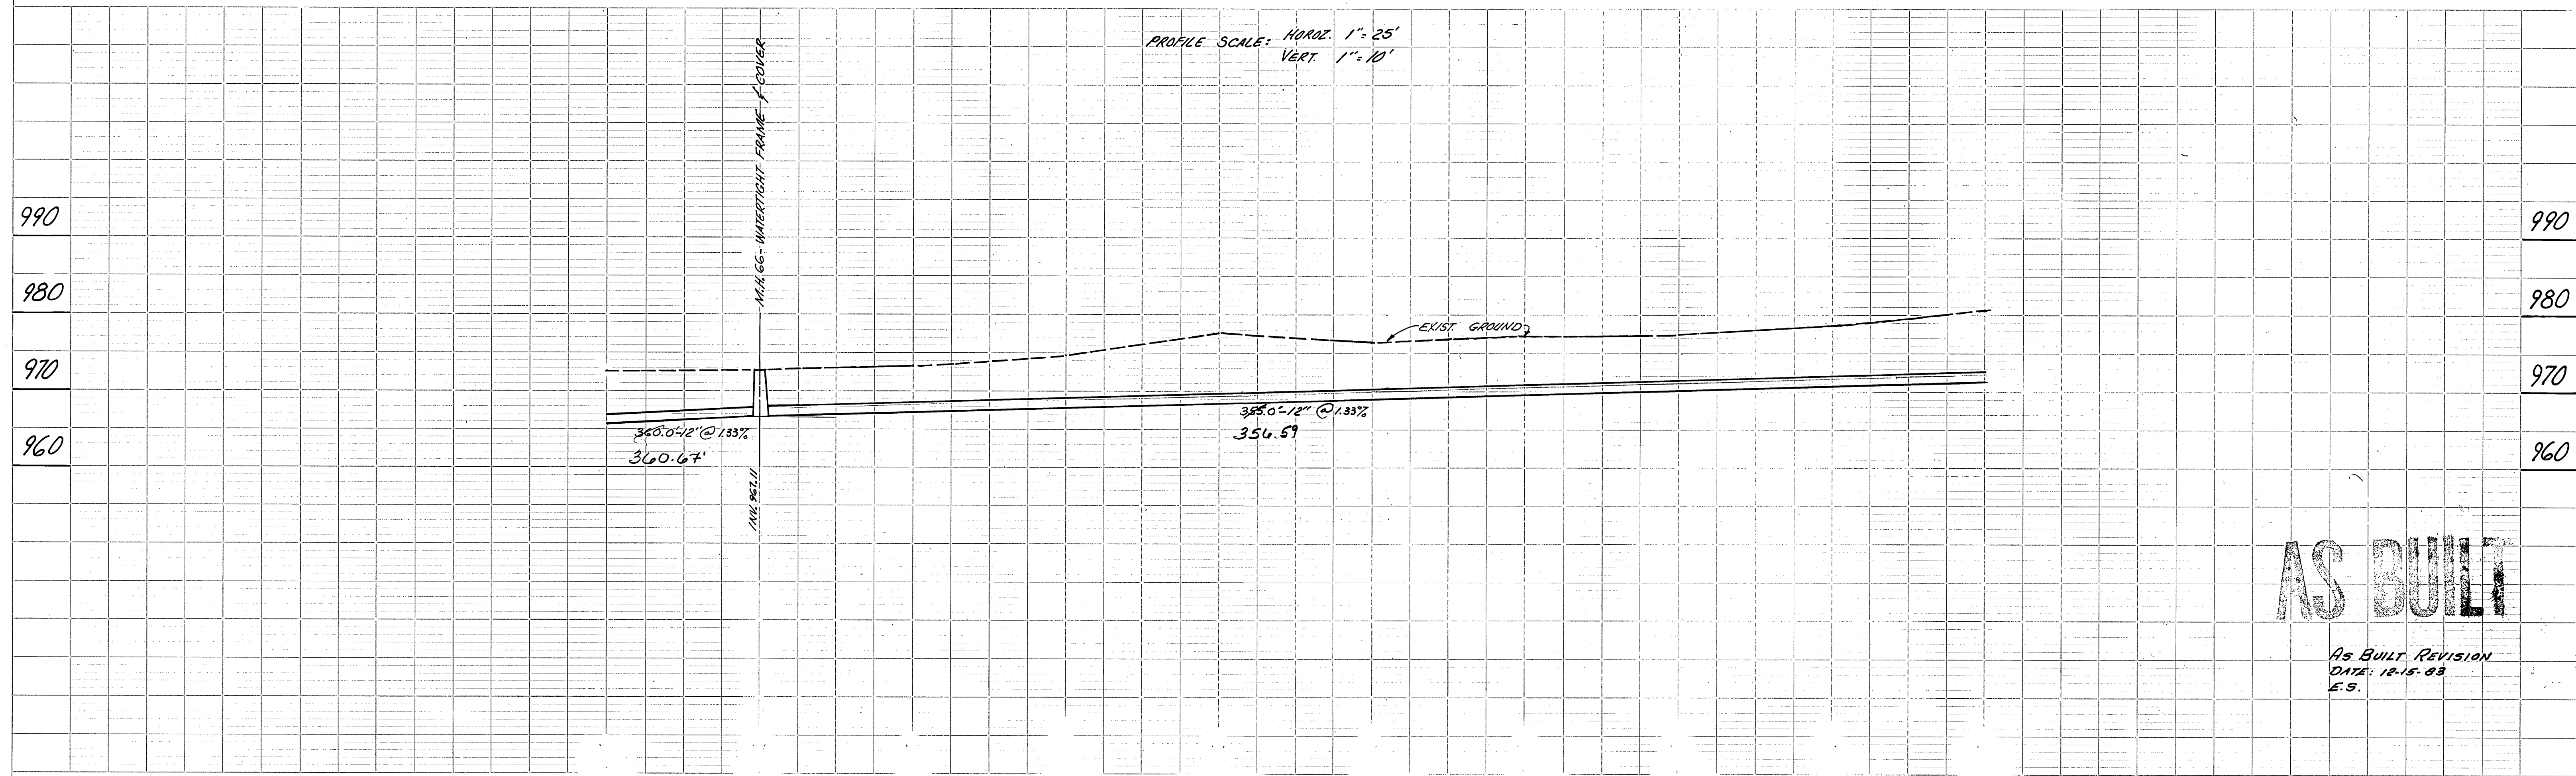

AS BUILT

AS BUILT REVISION
DATE: 12-15-83
E.S.

DATE: 4-80
BY: H. MASON
G. McNEALD
NO. 571

DATE: 4-80
BY: H. MASON
G. McNEALD
NO. 571