



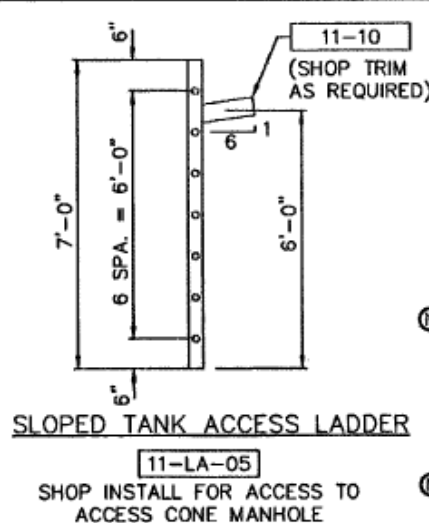


ACCESS TUBE LADDER
11-LA-03

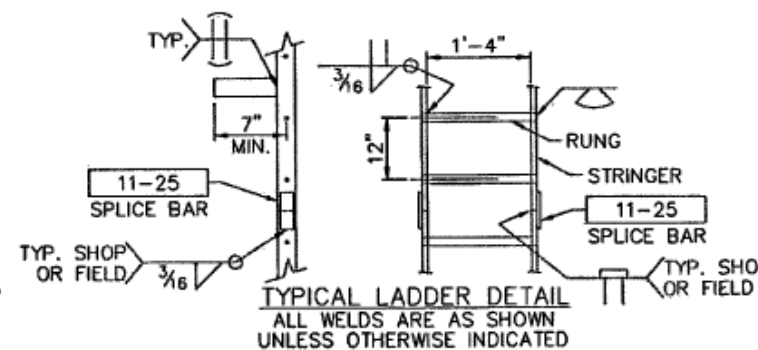

1. LADDERS (EXCEPT 11-LA-05) WILL BE FURNISHED w/CABLE-TYPE SAFE-CLIMBING DEVICE
 ** 2. 11-13, 11-14, 11-15 & 11-23 SHALL BE SHIPPED DIRECTLY TO THE OWNER.

AS BUILT

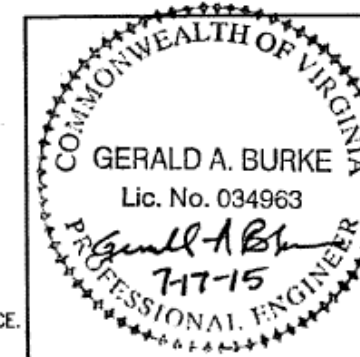

REV.	BY:	DATE	REMARKS
			
ROANOKE, VIRGINIA 250,000 GALLON PEDESHERE			
BY: AMK		TITLE: LADDER DETAILS	
DATE: 07/07/15		DRAWING NO.: F-8344	