



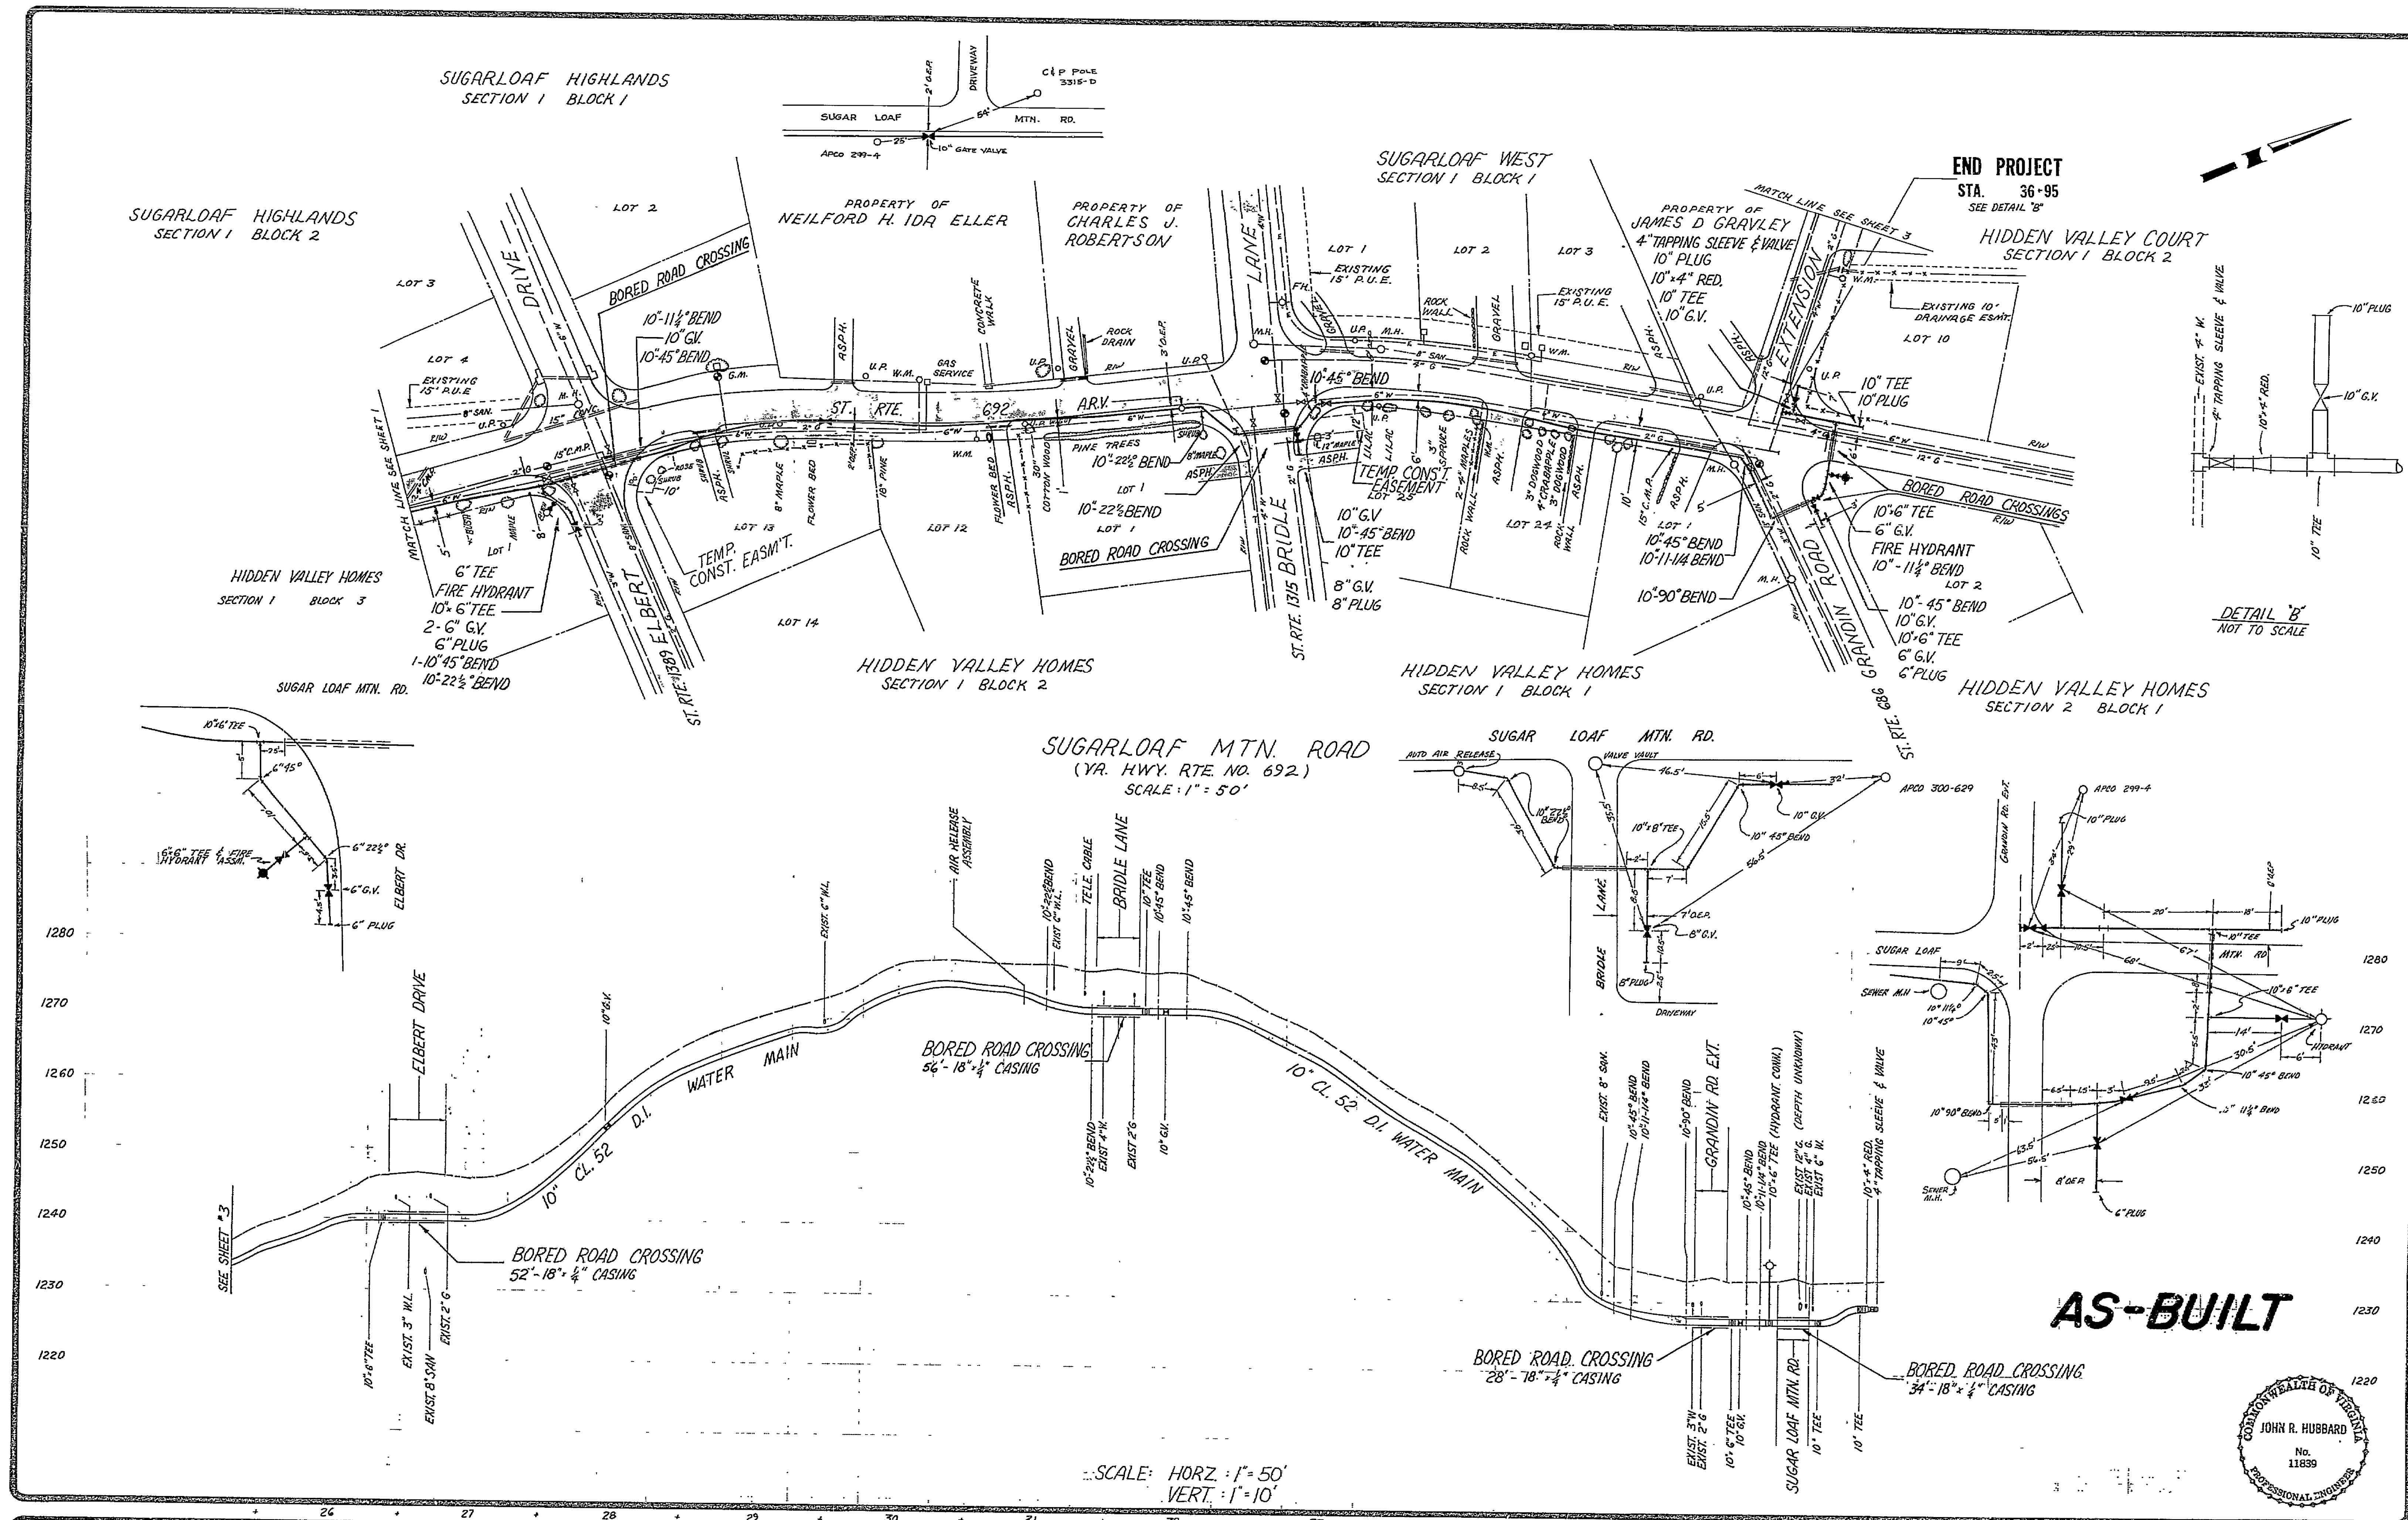

AS-BUILT

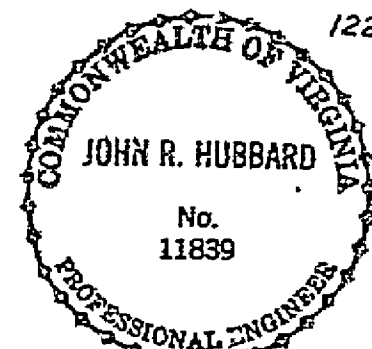

**ROANOKE COUNTY
UTILITY DEPARTMENT**

NO.	REVISIONS	DATE
1	CONST. EASEMENT DELETION	5/4/81

HIDDEN VALLEY TRANSMISSION MAIN

81-2-W

DATE:	MARCH 1, 1981
SCALE: HORZ.:	1" = 50'
SCALE: VERT.:	1" = 10'
DRAWING BY:	M.A.G.
DESIGNED BY:	M.S.W.
APPROVED BY:	J.R.H.

PLAN & PROFILE

SHEET
5
OF
6

