


CURVE DATA


CURVE "C"	CURVE "D"	CURVE "E"
Δ=44°31'27"	Δ=44°15'23"	Δ=42°30'23"
R=342.00'	R=221.33'	R=257.11'
A=265.77'	A=170.96'	A=190.74'
T=140.00'	T=90.00'	T=100.00'
PC=9+85.11	PC=13+50.88	PC=16+83.60
PT=11+25.11	PT=14+40.88	PT=17+83.60
RT=12+50.88	RT=15+21.84	RT=18+74.34

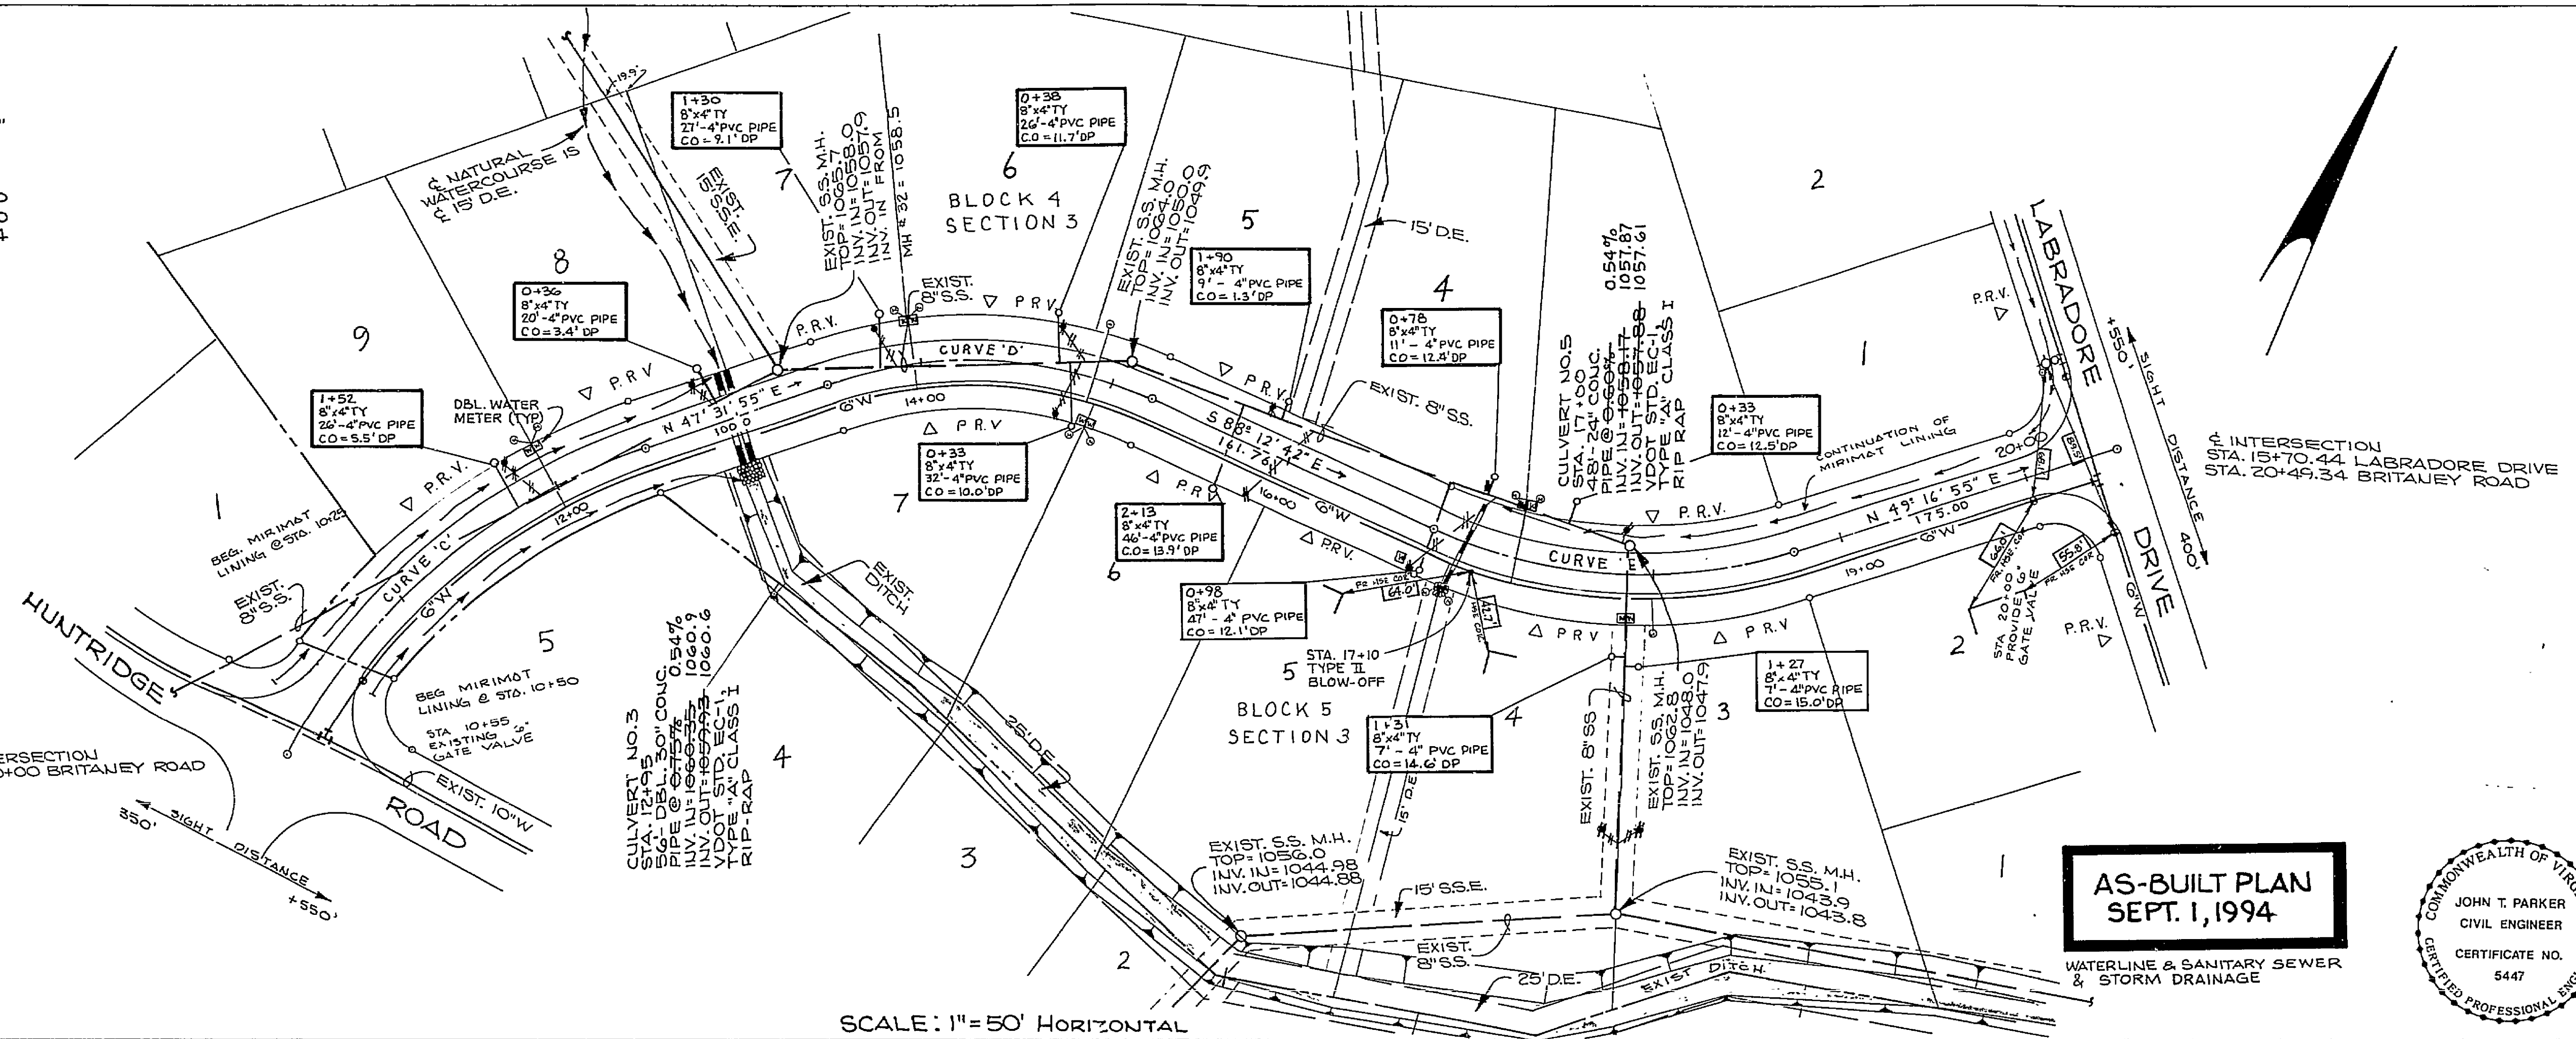

WATERLINES SHALL BE CONSTRUCTED UNDER THE NEW "DESIGN AND CONSTRUCTION STANDARDS FOR WATER FACILITIES" ADOPTED APRIL 28, 1987.


NOTE: ALL LOTS HAVING 80 PSI OR GREATER AT THE METER SHALL HAVE A P.R.V. (PRESSURE REDUCING VALVE) TO BE INSTALLED BY THE DEVELOPER.

AS-BUILT PLAN
SEPT. 1, 1994

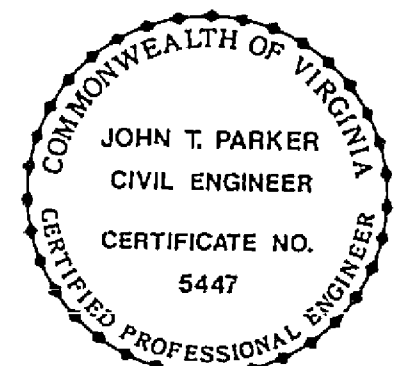

SCALE: 1"=50' HORIZONTAL
1"=10' VERTICAL

BRITANEY ROAD

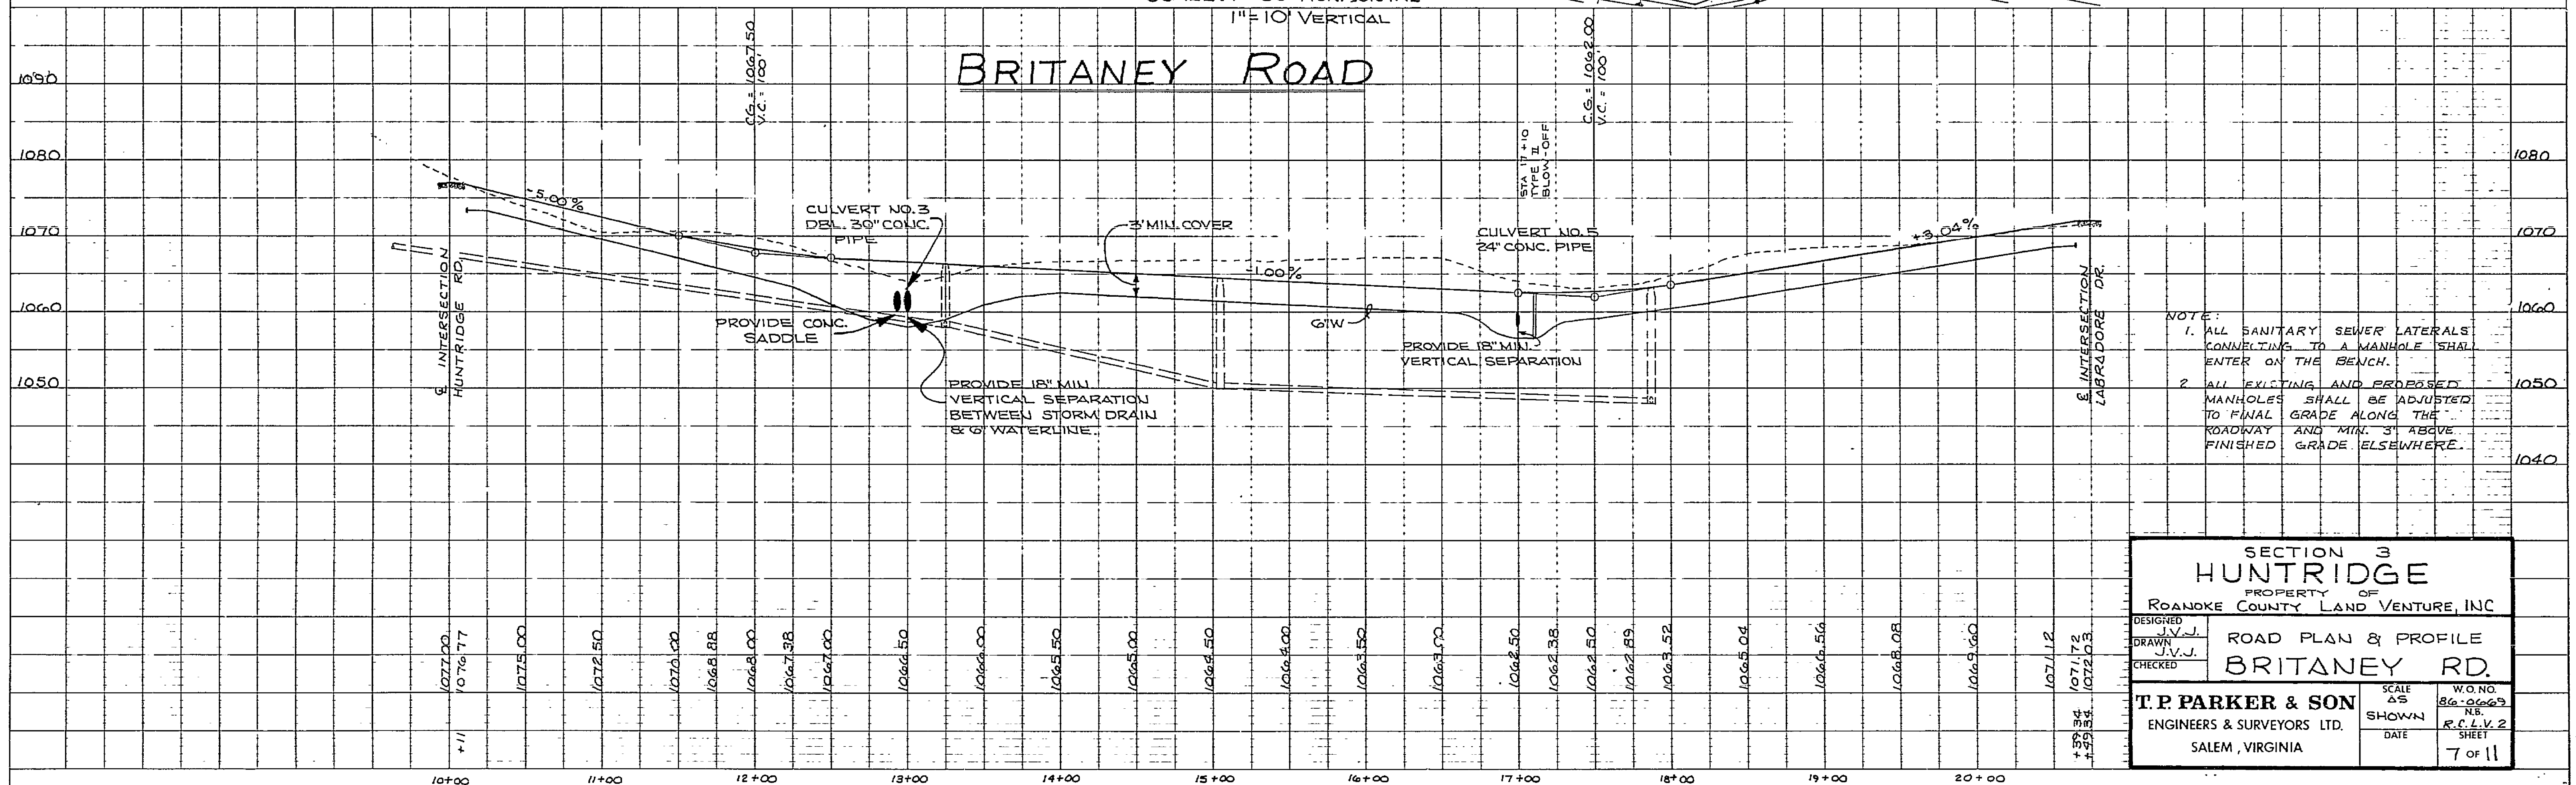

NOTE:
1. ALL SANITARY SEWER LATERALS CONNECTING TO A MANHOLE SHALL ENTER ON THE BENCH.
2. ALL EXISTING AND PROPOSED MANHOLES SHALL BE ADJUSTED TO FINAL GRADE ALONG THE ROADWAY AND MIN. 3" ABOVE FINISHED GRADE ELSEWHERE.

SECTION 3 HUNTRIDGE	
PROPERTY OF ROANOKE COUNTY LAND VENTURE, INC.	
DESIGNED V.J.J.	ROAD PLAN & PROFILE
DRAWN V.J.J.	BRITANEY RD.
CHECKED V.J.J.	
T.P. PARKER & SON	
ENGINEERS & SURVEYORS LTD.	SALEM, VIRGINIA
SCALE AS SHOWN	W.O. NO. 86-0669
DATE	R.C.L.V. 2
	SHEET 7 of 11

PLATE 1: PLAN/PROFILE OF P.R. & S.E. STANDARD
DETROIT CORPORATION
PRINTED IN U.S.A.

RC-2146