






**ENGINEERING
CONCEPTS, INC.**
84 GREENFIELD STREET
CHARLOTTE, VIRGINIA 24603
540.473.1235

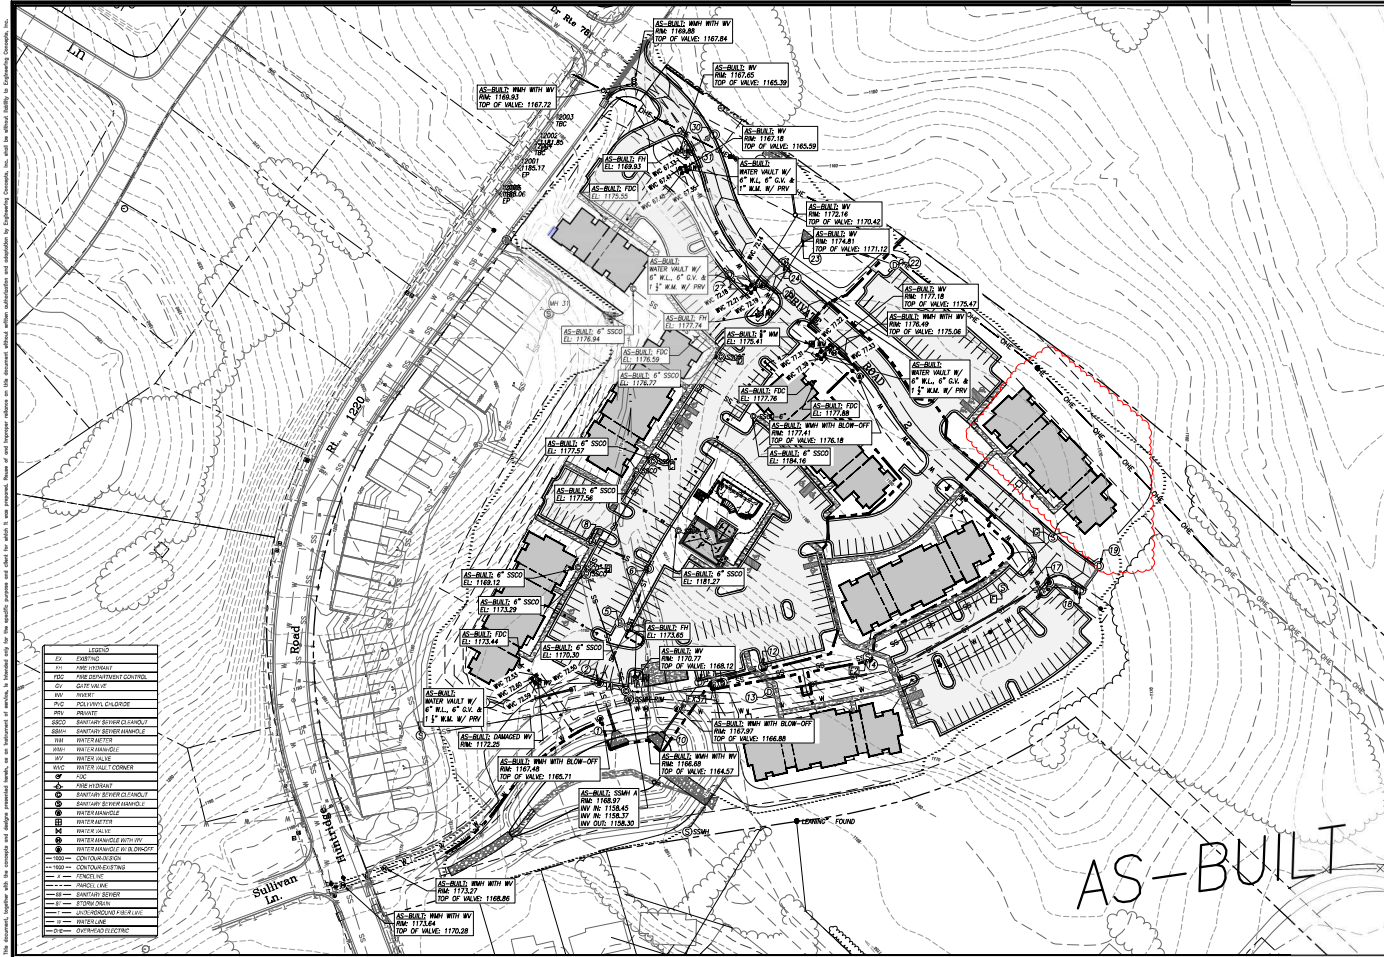

North Arrow

No.	Description	Date
1	AS-BUILT	12/27/24

**HUNTRIDGE MULTIFAMILY
ROANOKE COUNTY, VA
PHASE 2 AS-BUILT**



James Scott Calhoun
No. 908713
12/27/24
Professional Engineer
State of Virginia

GRAPHIC SCALE
PROJECT: 20007
C-000

This document, together with the associated and related information, is the property of Engineering Concepts, Inc. and is loaned to the client for the specific project and shall not be used for any other project without the written consent of Engineering Concepts, Inc. and shall be returned to Engineering Concepts, Inc. upon completion of the project. Engineering Concepts, Inc. shall be held harmless for any and all claims, damages, losses, and expenses, including reasonable attorneys' fees, incurred by the client or any third party as a result of the use of this document for any purpose other than that for which it was prepared. Please refer to all project information and specifications for Engineering Concepts, Inc. and all project information and specifications for Engineering Concepts, Inc. shall be held harmless for any and all claims, damages, losses, and expenses, including reasonable attorneys' fees, incurred by the client or any third party as a result of the use of this document for any purpose other than that for which it was prepared.