



This document, together with the associated and related information, is provided only for the specific project and shall not be used for any other project without the written consent of Engineering Concepts, Inc. and shall not be used for any other project without the written consent of Engineering Concepts, Inc.

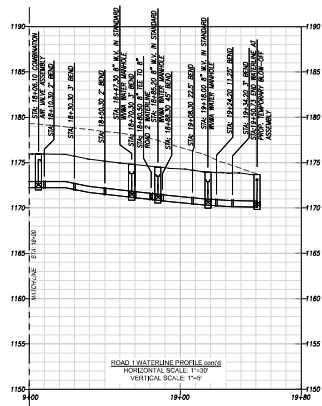


AS-BUILT

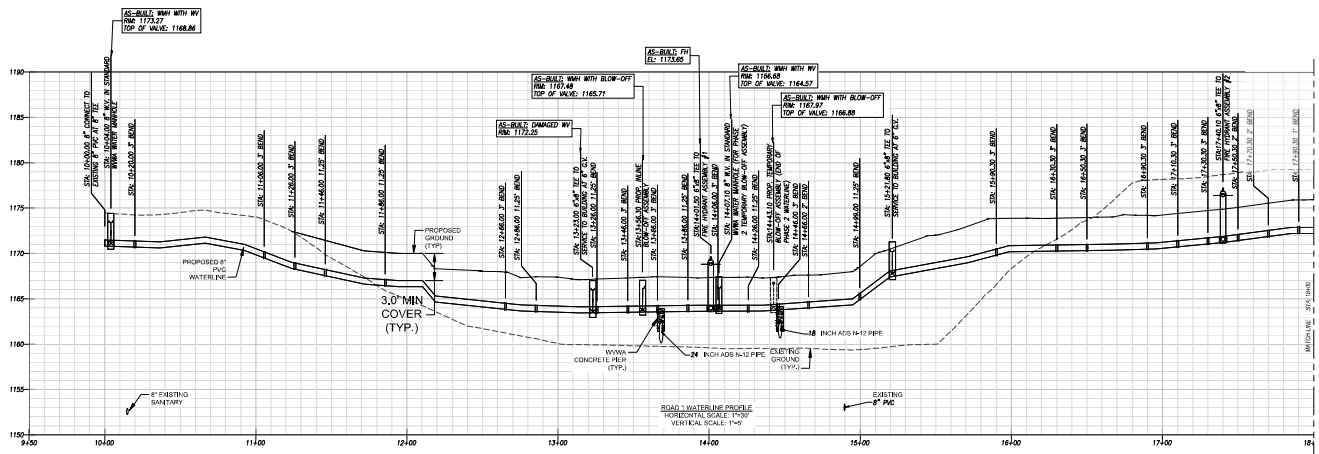

No.	Description	Date
1	AS-BUILT	12/27/24

HUNTRIDGE MULTIFAMILY
ROANOKE COUNTY, VA
PHASE 2 SANITARY &
WATER PROFILES AS-BUILT

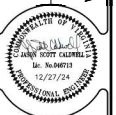

GRAPHIC SCALE
PROJECT: 20007
C-000