


This document, together with the associated and/or related project information, is the property of Engineering Concepts, Inc. and shall remain confidential. It is to be used only for the specific project and shall not be used for any other purpose without the written consent of Engineering Concepts, Inc. If it is determined that this document is to be used for any other purpose, the user must first obtain the written consent of Engineering Concepts, Inc.



AS-BUILT

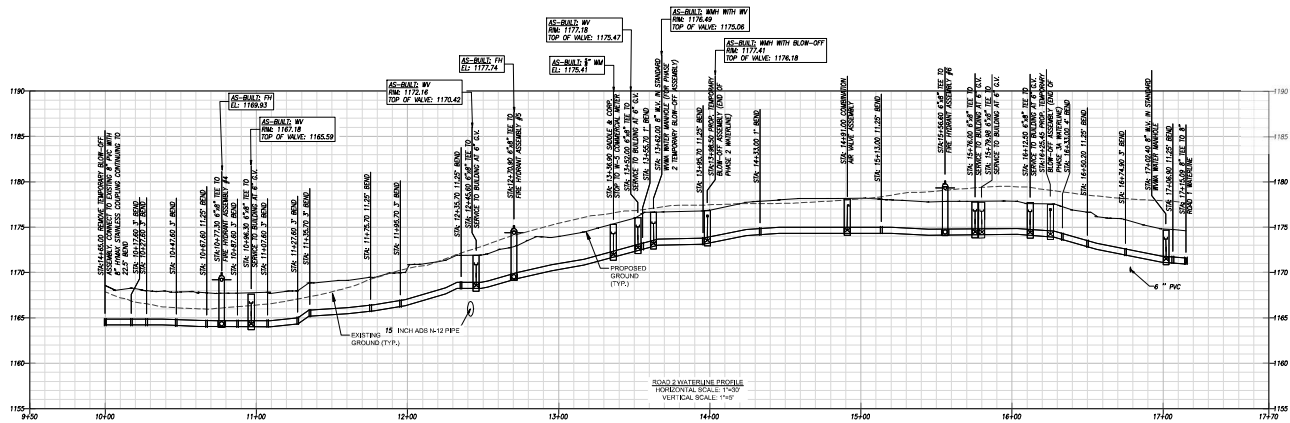

No.	Description	Date
1	AS-BUILT	12/27/24
2	AS-BUILT	12/27/24
HUNTRIDGE MULTIFAMILY
ROANOKE COUNTY, VA
PHASE 2 SANITARY & WATER PROFILES AS-BUILT



GRAPHIC SCALE
PROJECT: 20007
C-000