
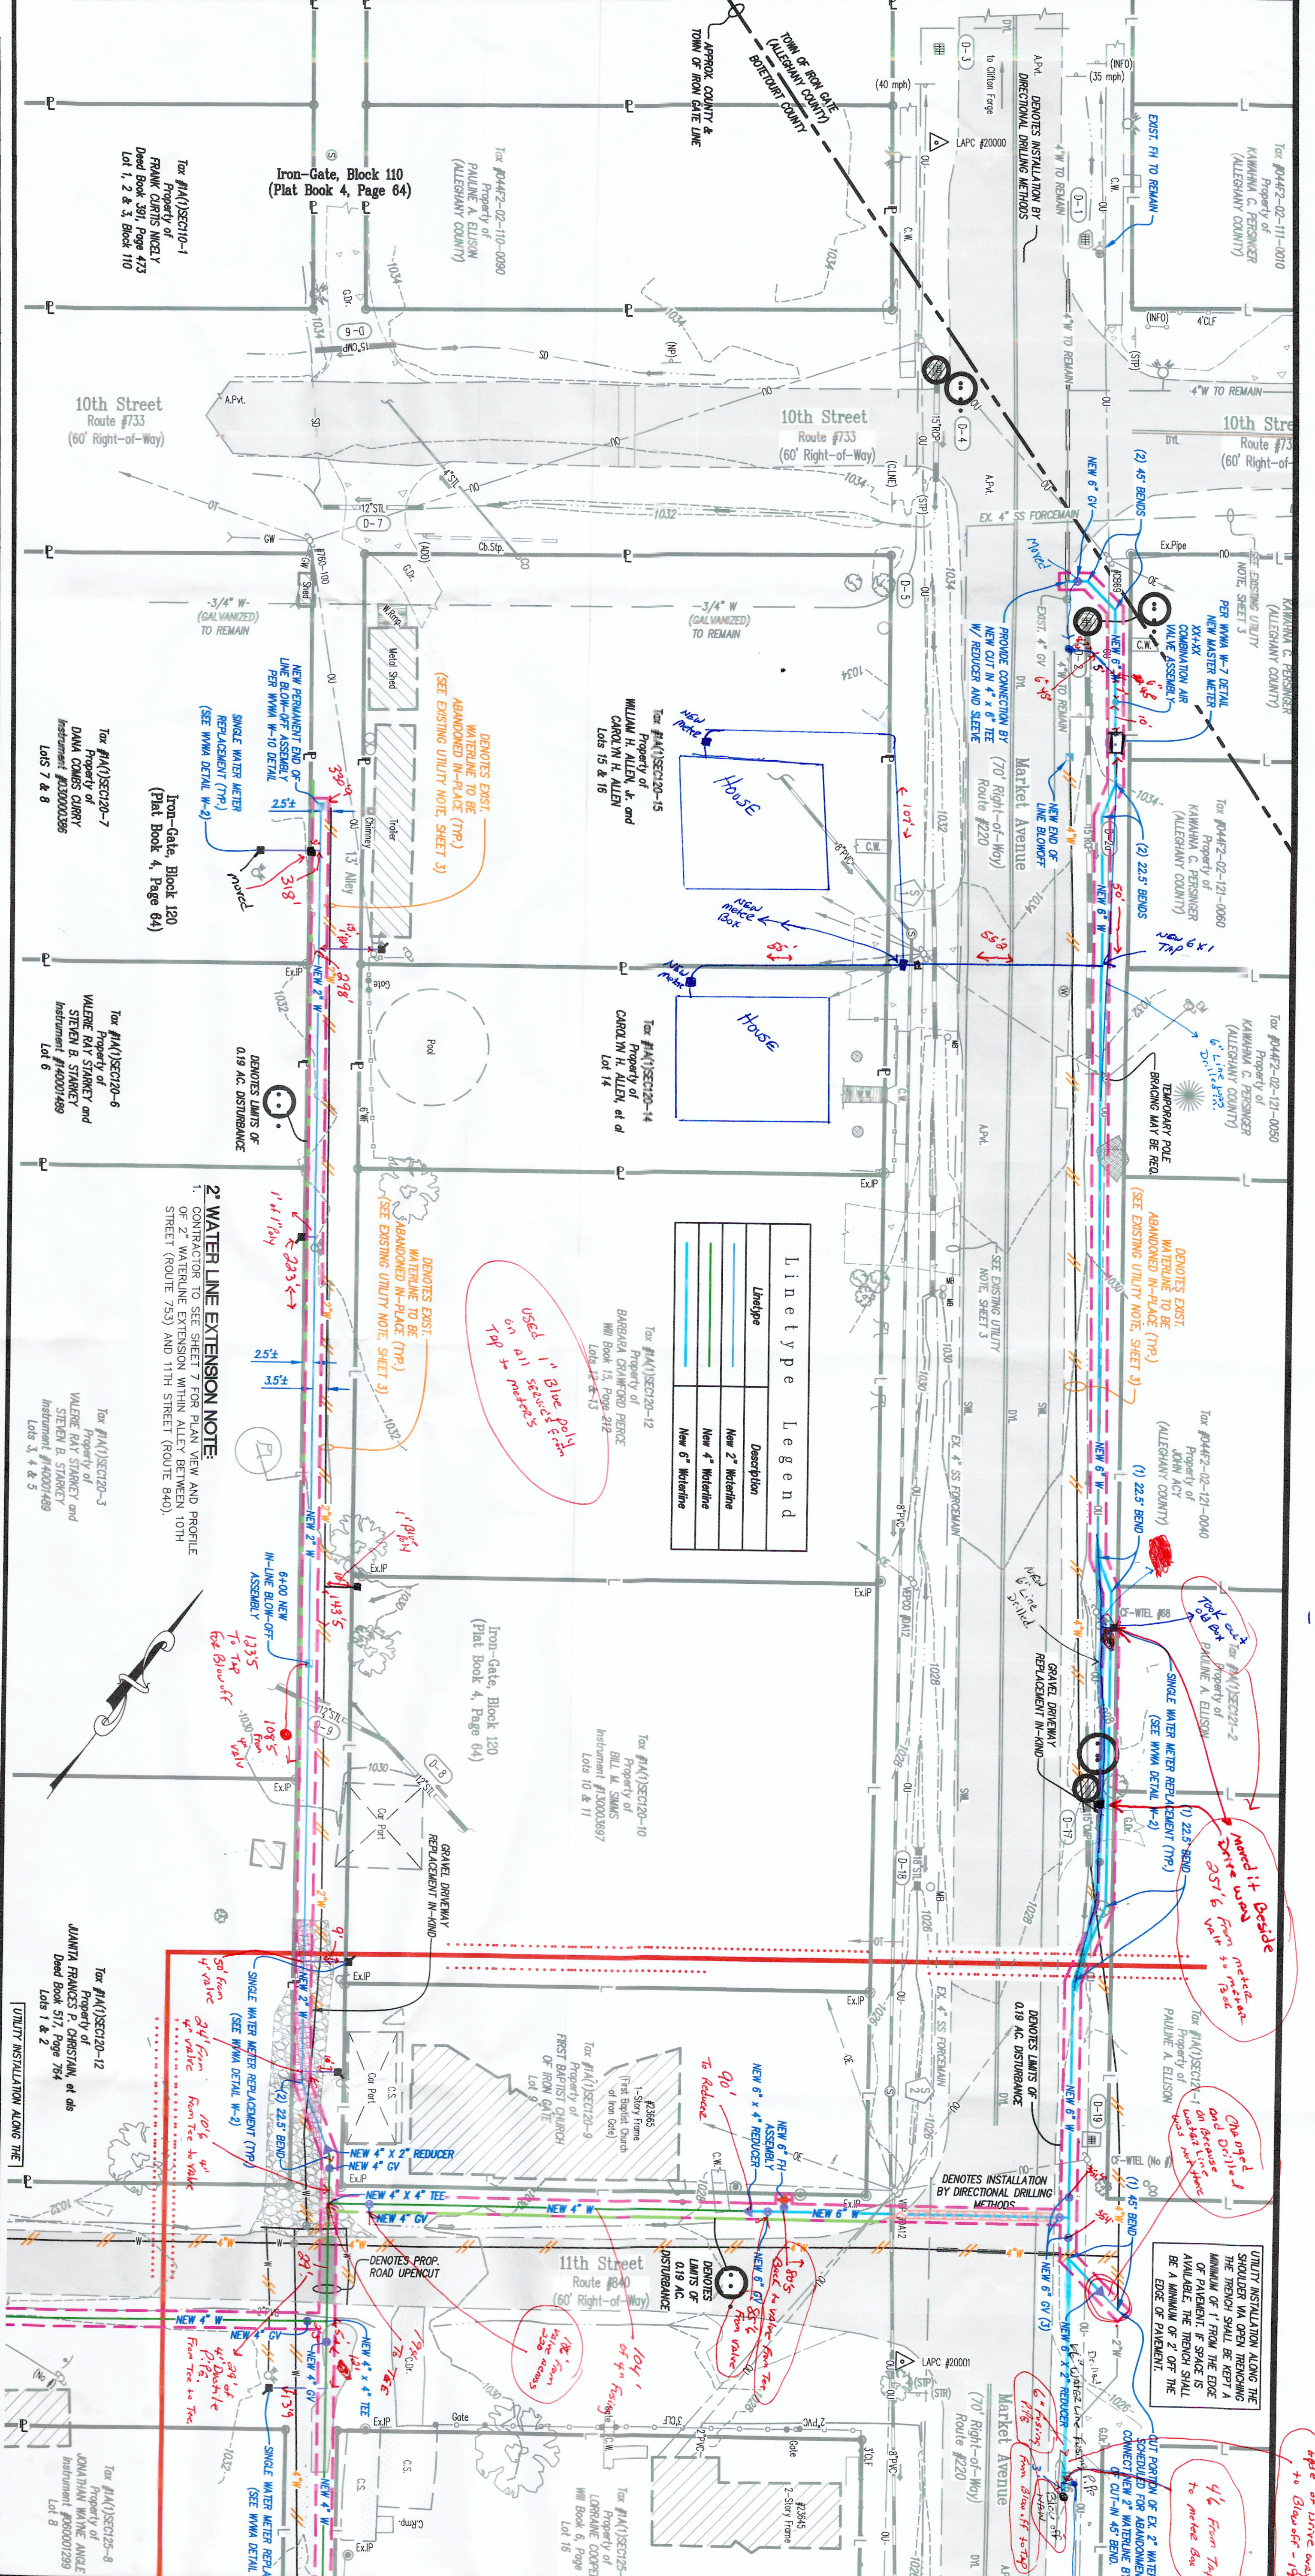


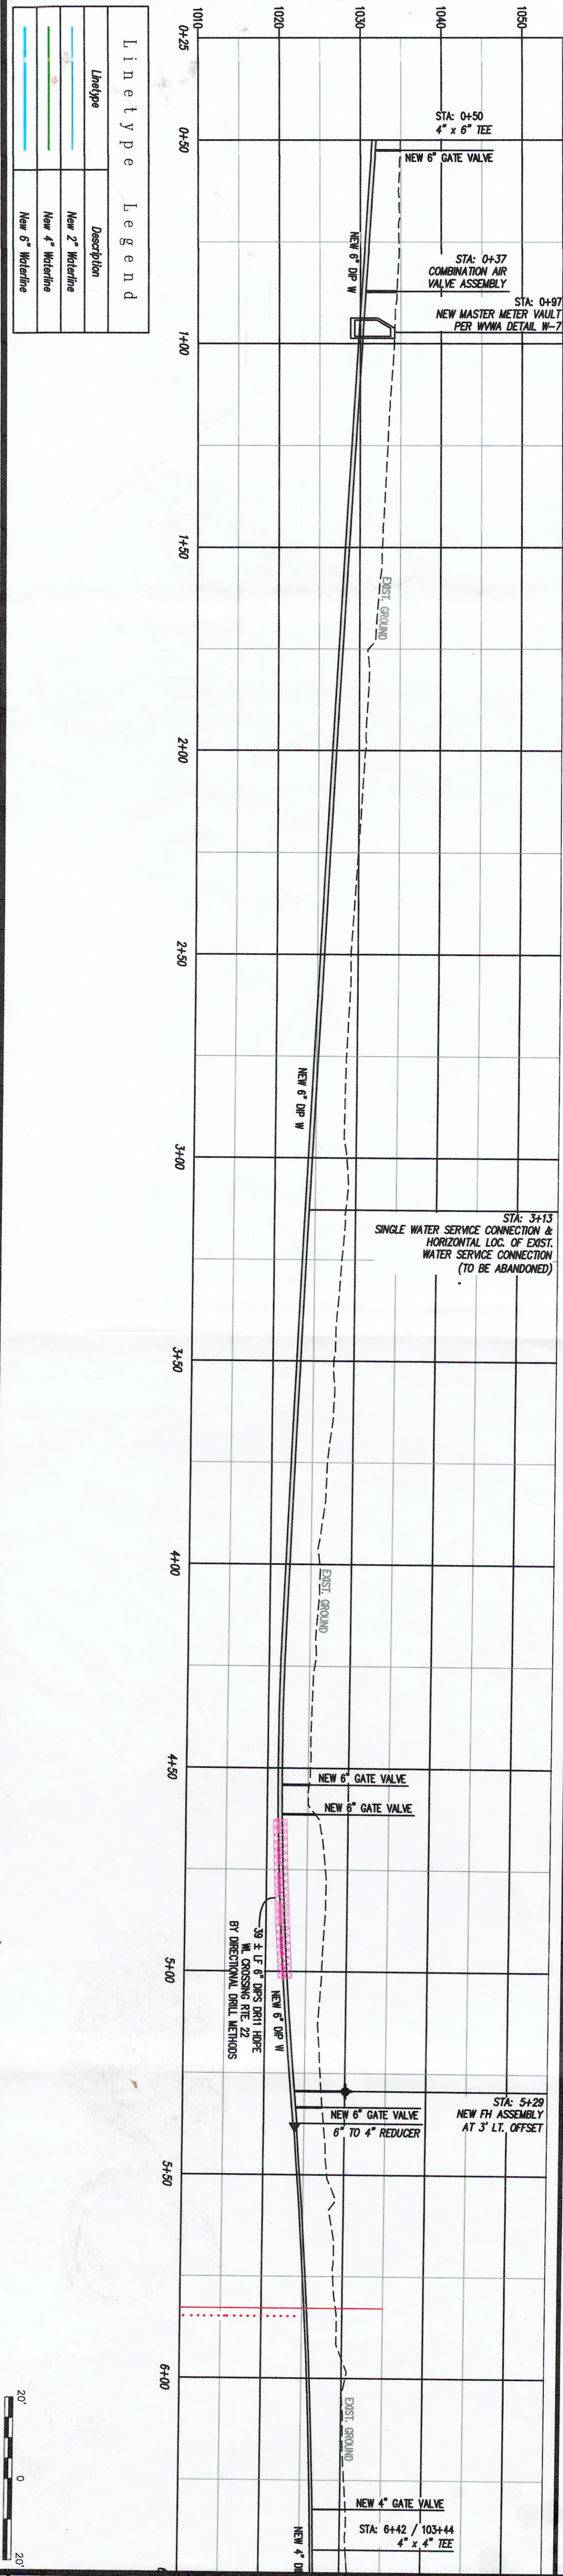


REVISIONS	
NO.	DESCRIPTION
1	
2	
3	
4	
5	

DATE	JUNE 26, 2023
SCALE	1" = 20'
COMPL. NO.	2022-104
SHEET	4 OF 11

NORTH BOTETOURT
UTILITY SYSTEM
WATERLINE REPLACEMENT
PREPARED FOR
WESTERN VIRGINIA WATER AUTHORITY
SITUATED IN
BOTETOURT COUNTY, VIRGINIA

10TH, 11TH STREET &
ALLEY PLAN & PROFILE
(STA. 0+50 - 3+97)

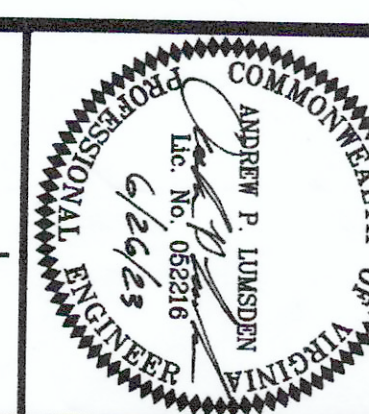

Lumsden Associates, P.C.
ENGINEERS | SURVEYORS | PLANNERS

4664 BRAMBLETON AVENUE
P.O. BOX 20669
ROANOKE, VIRGINIA 24018

PHONE: (540) 774-4411
FAX: (540) 772-9445
EMAIL: MAIL@LUMSDENPC.COM