


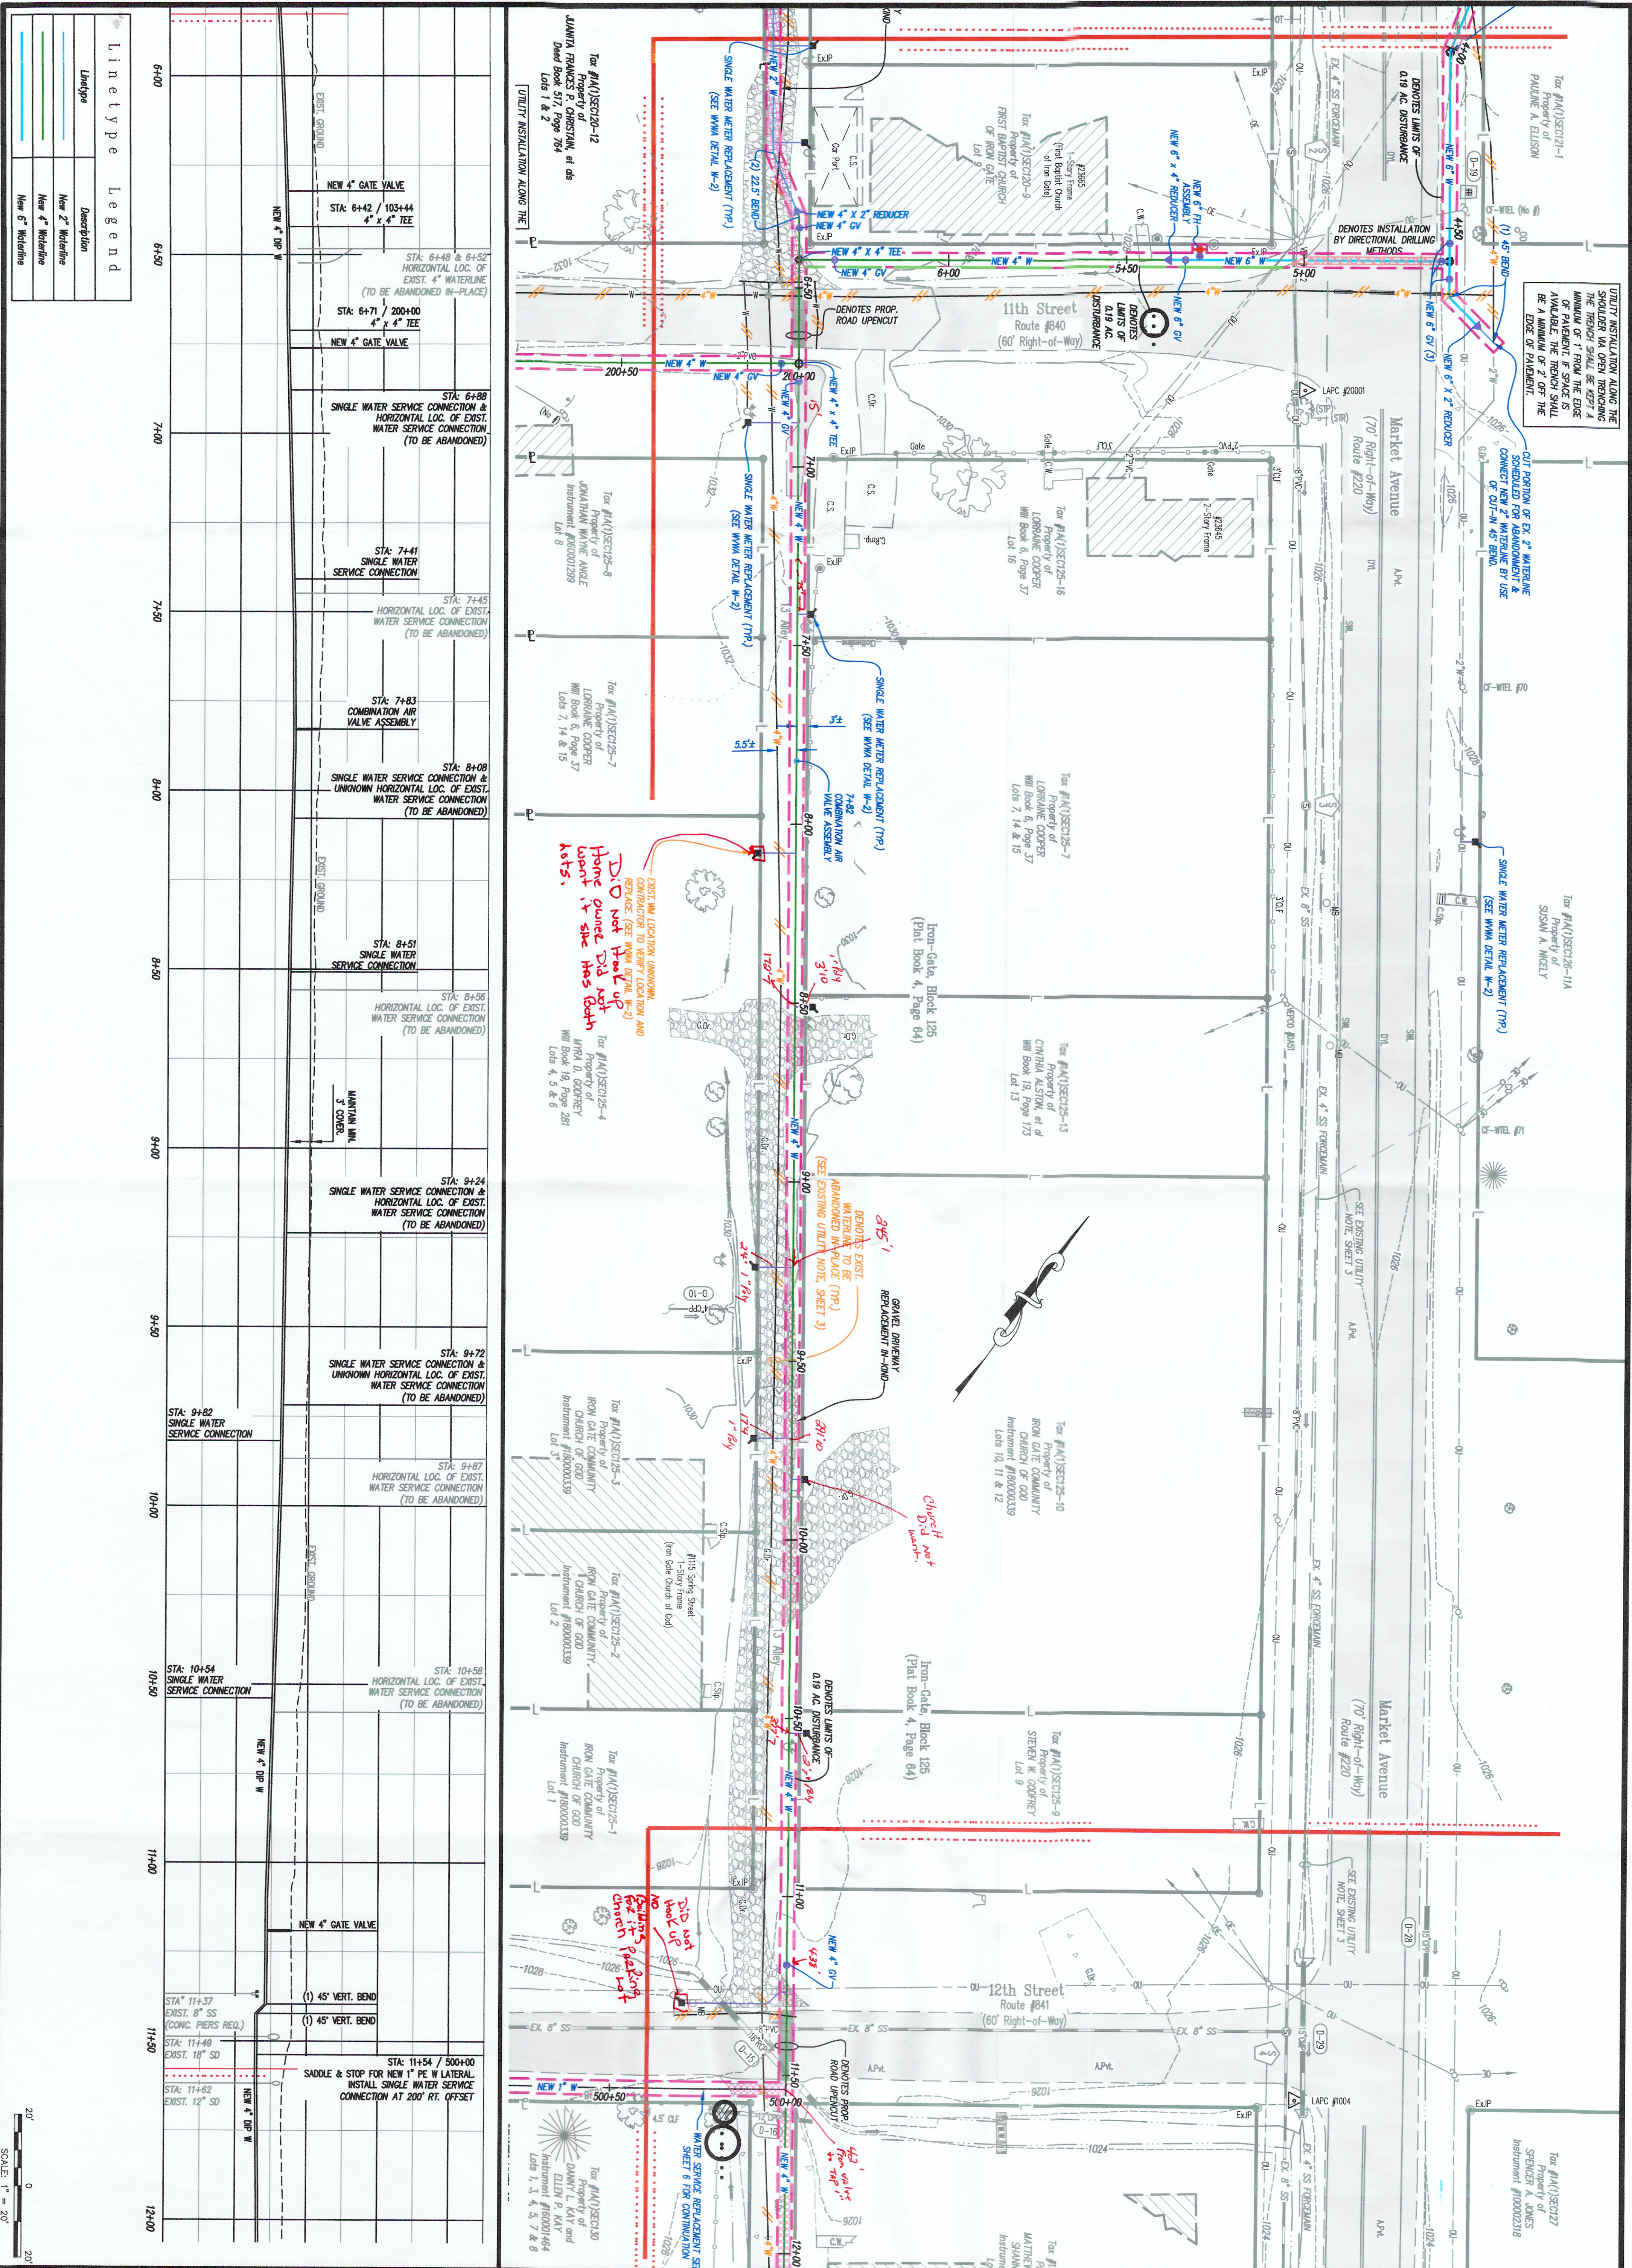

REVISIONS		
NO.	DATE	DESCRIPTION
1		
2		
3		
4		
5		

DATE:	JUNE 26, 2023
SCALE:	1" = 20'
COMD. NO.:	2022-104
SHEET:	5 OF 11

NORTH BOTETOURT
UTILITY SYSTEM
WATERLINE REPLACEMENT
PREPARED FOR
WESTERN VIRGINIA WATER AUTHORITY
SITUATED IN
BOTETOURT COUNTY, VIRGINIA

11TH, 12TH STREET &
ALLEY PLAN & PROFILE
(STA. 3+97 - 10+81)





Lumsden Associates, P.C.
ENGINEERS | SURVEYORS | PLANNERS

4664 BRAMBLETON AVENUE
P.O. BOX 20669
ROANOKE, VIRGINIA 24018

PHONE: (540) 774-4411
FAX: (540) 772-9445
EMAIL: MAIL@LUMSDENPC.COM