




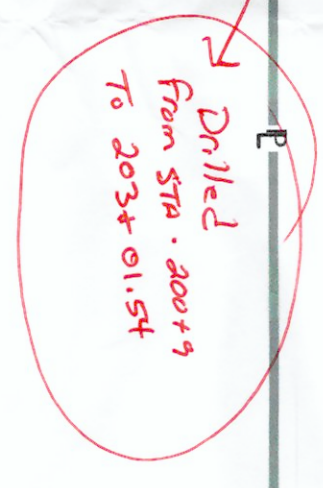

Line type Legend	
Line type	Description
	New 2" Waterline
	New 4" Waterline
	New 6" Waterline

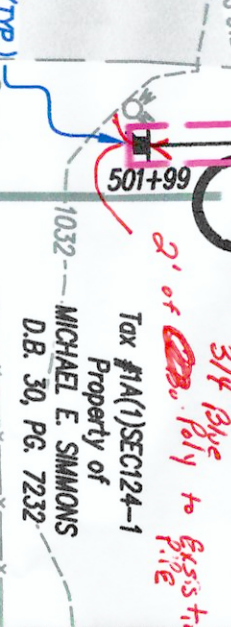

**NORTH BOTETOURT
UTILITY SYSTEM
WATERLINE REPLACEMENT
PREPARED FOR
WESTERN VIRGINIA WATER AUTHORITY
SITUATED IN
BOTETOURT COUNTY, VIRGINIA**

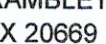

Lumsden Associates, P.C.
ENGINEERS | SURVEYORS | PLANNERS

4664 BRAMBLETON AVENUE
P.O. BOX 20689
ROANOKE, VIRGINIA 24018

PHONE: (540) 774-4411
FAX: (540) 772-9445
EMAIL: MAIL@LUMSDENPC.COM