
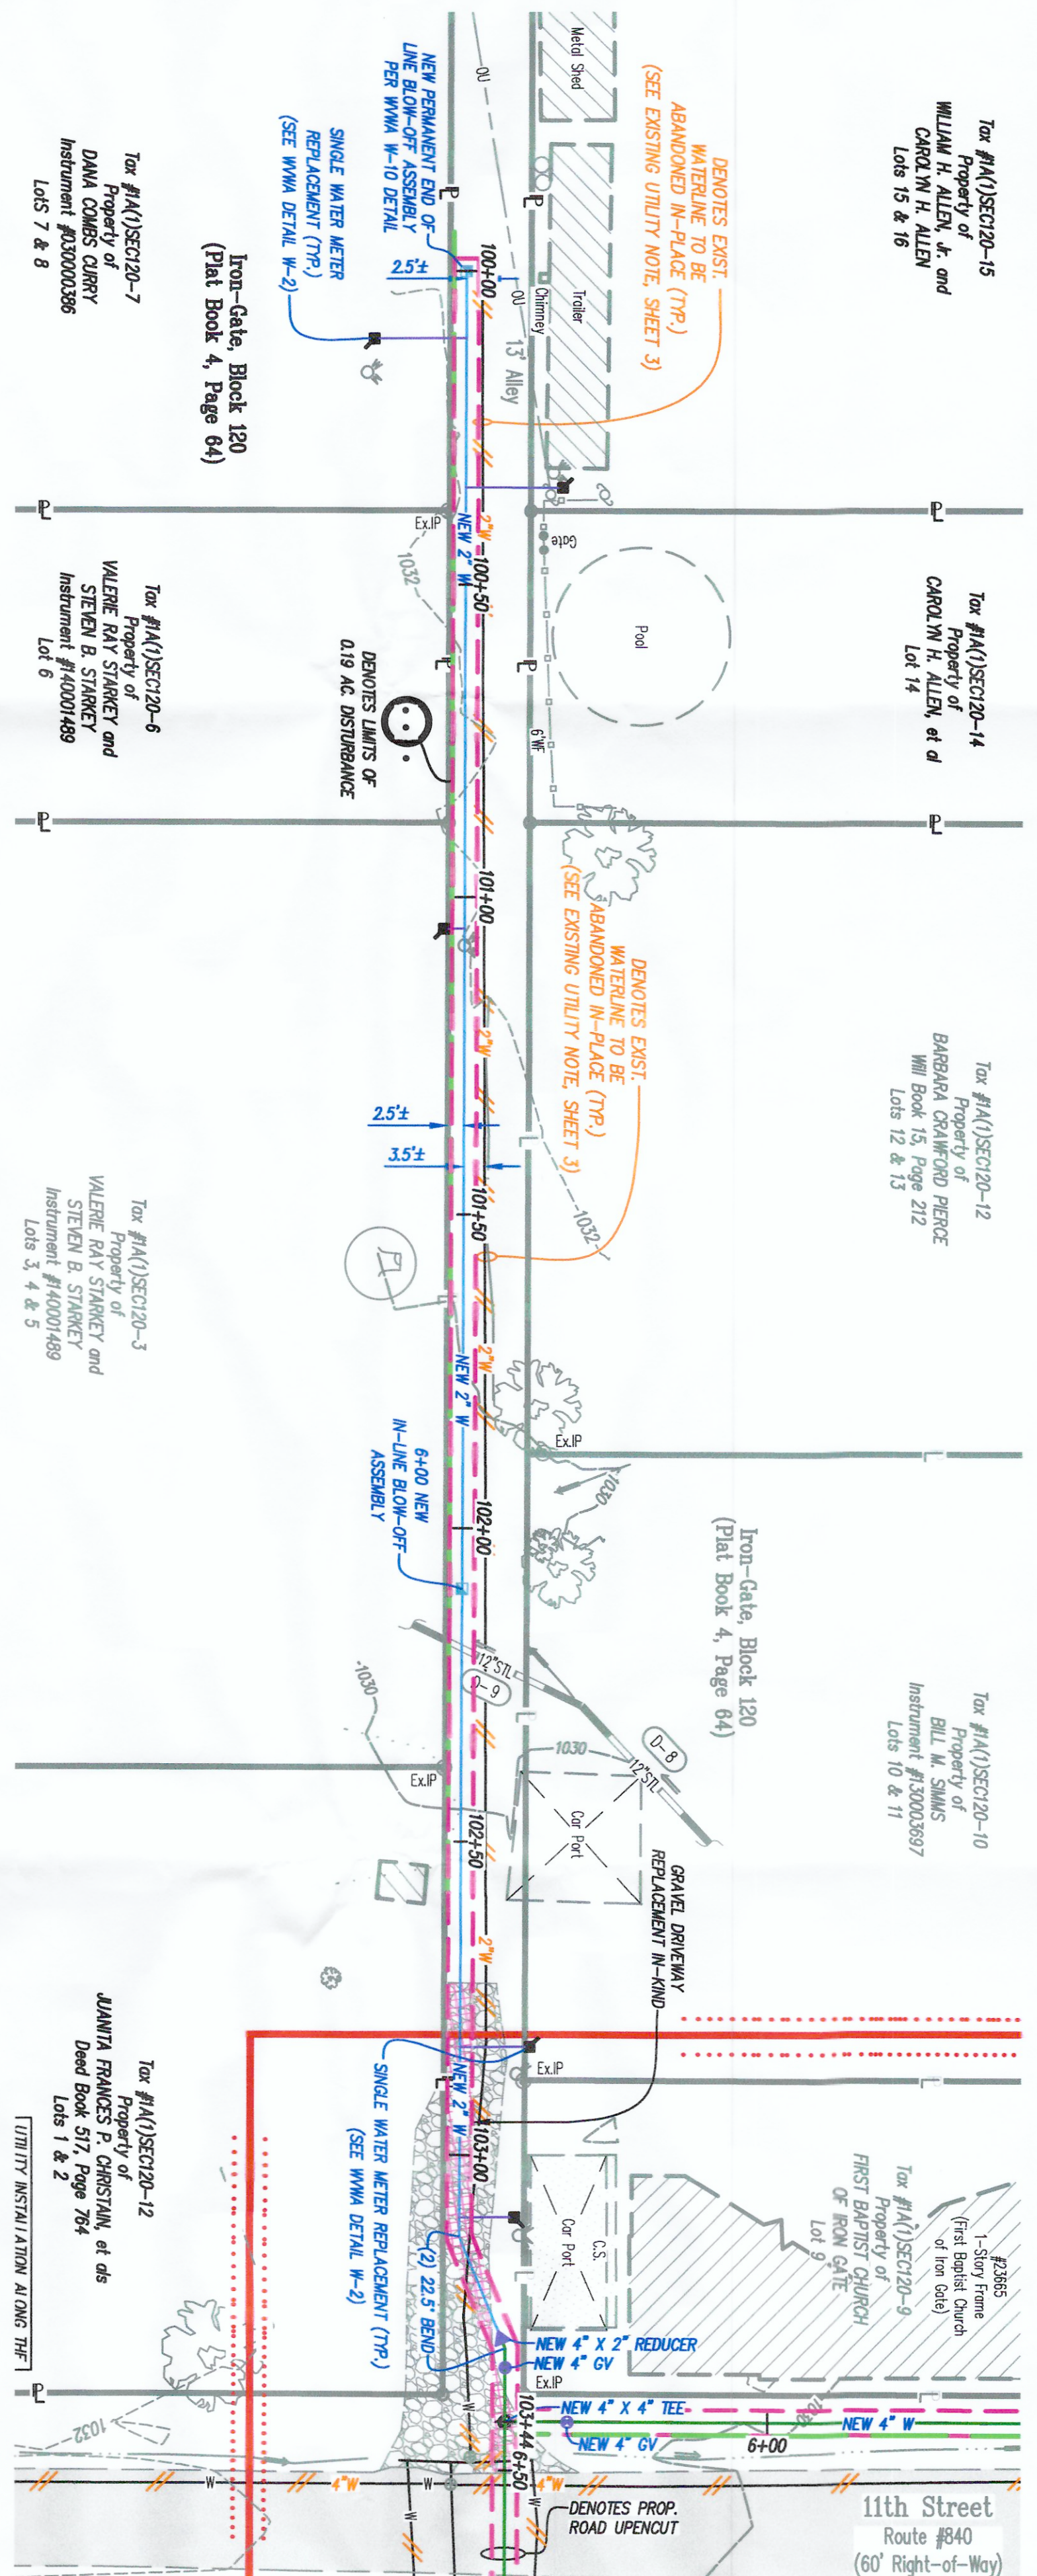


**NORTH BOTETOURT
UTILITY SYSTEM
WATERLINE REPLACEMENT
PREPARED FOR
WESTERN VIRGINIA WATER AUTHORITY
SITUATED IN
BOTETOURT COUNTY, VIRGINIA**

11TH STREET WM REPLACEMENT PLAN & ALLEY PLAN & PROFILE	
---	---

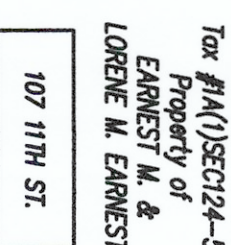