



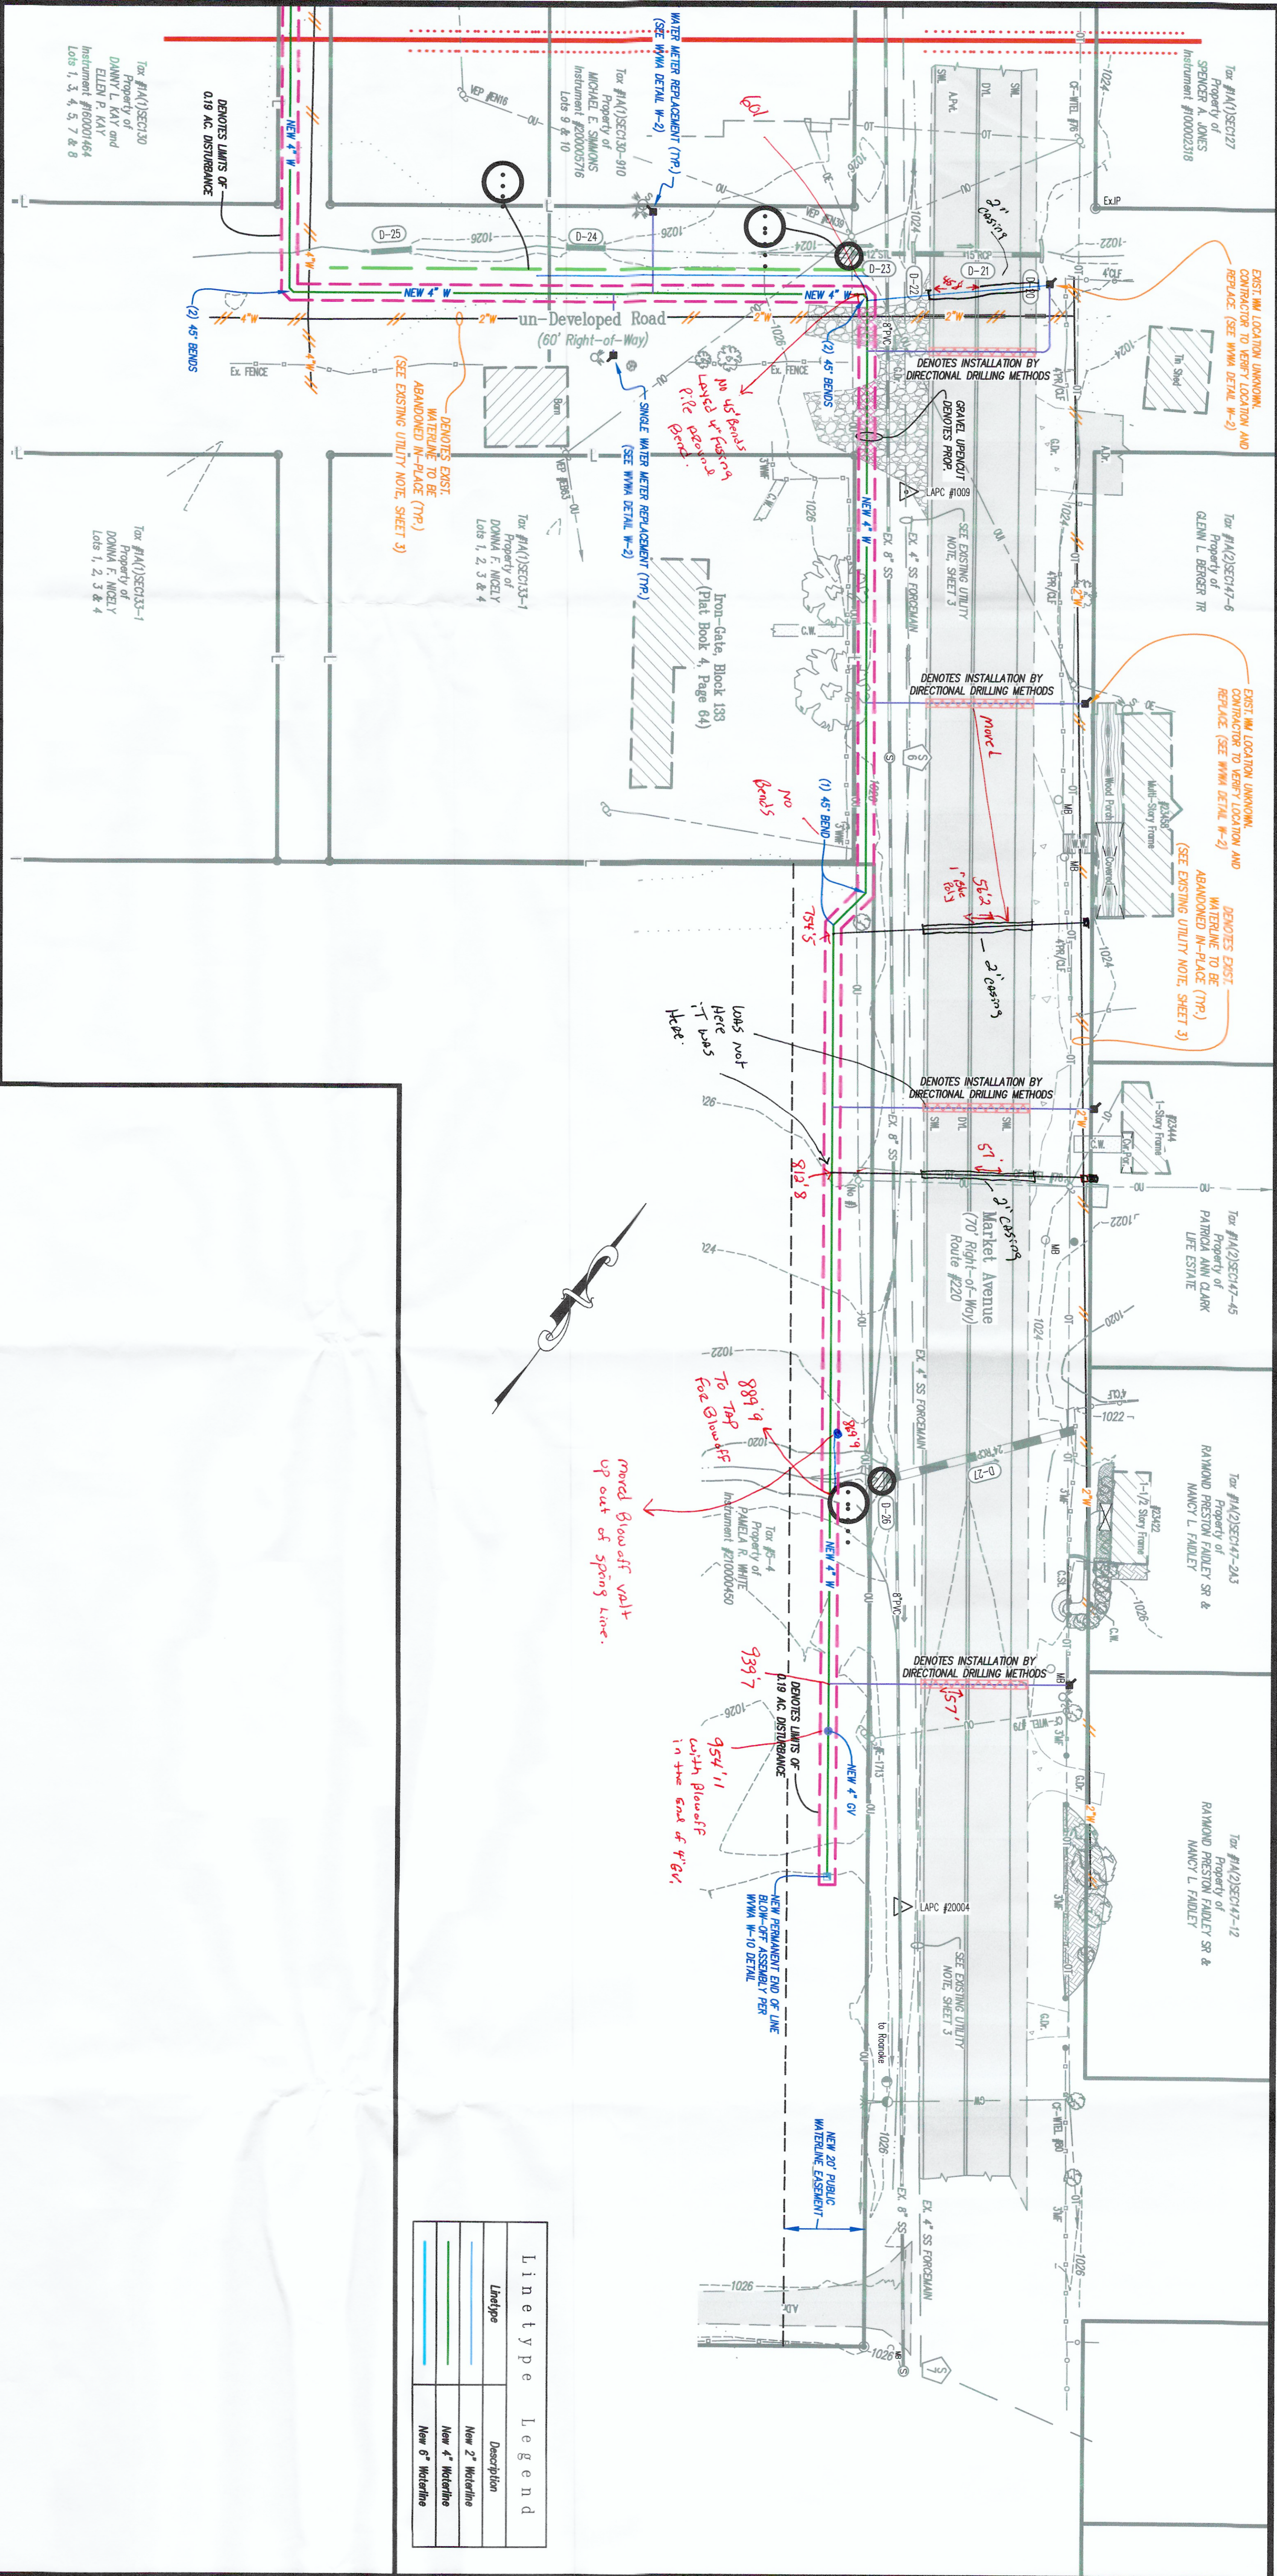

Linetype Legend	
Linetype	Description
---	New 2" Waterline
---	New 4" Waterline
---	New 6" Waterline

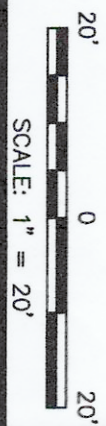

REVISIONS	
NO.	DATE
1	
2	
3	
4	
5	

DATE:	JUNE 26, 2023
SCALE:	1" = 20'
COMMA NO.:	2022-104
SHEET:	9 OF 11

NORTH BOTETOURT
UTILITY SYSTEM
WATERLINE REPLACEMENT
PREPARED FOR
WESTERN VIRGINIA WATER AUTHORITY
SITUATED IN
BOTETOURT COUNTY, VIRGINIA

MARKET AVENUE
PLAN & PROFILE
(STA. 15+20 - 21+17)





Lumsden Associates, P.C.
ENGINEERS | SURVEYORS | PLANNERS

4664 BRAMBLETON AVENUE
P.O. BOX 20669
ROANKE, VIRGINIA 24018

PHONE: (540) 774-4411
FAX: (540) 772-9445
EMAIL: MAIL@LUMSDENPC.COM