


REV 2-8-77

DATE	REV.	DESCRIPTION	BY
CITY ENGINEER			
DRAWN <i>J.B.C.</i>			
CHECKED <i>M.K.</i>			
APPROVED			
DATE 3-23-76			
JOB NO.			
76-24			
SHEET			
4			
CONTRACTOR MUST VERIFY ALL DIMENSIONS AT PROJECT BEFORE PROCEEDING WITH WORK			

SCALE: 1"=25'

<i>W.B. Jr.</i>	3-29-76
DIRECTOR UTILITIES & OPERATIONS	DATE
<i>Thomas J. Bush</i>	3-26-76
CITY ENGINEER OF ROANOKE, VA.	DATE
<i>Ralph B. Jones</i>	3-30-76
DIRECTOR OF PUBLIC WORKS	DATE
<i>Laura M. M. M.</i>	3-29-76
AGENT FOR ROANOKE PLANNING COMM.	DATE

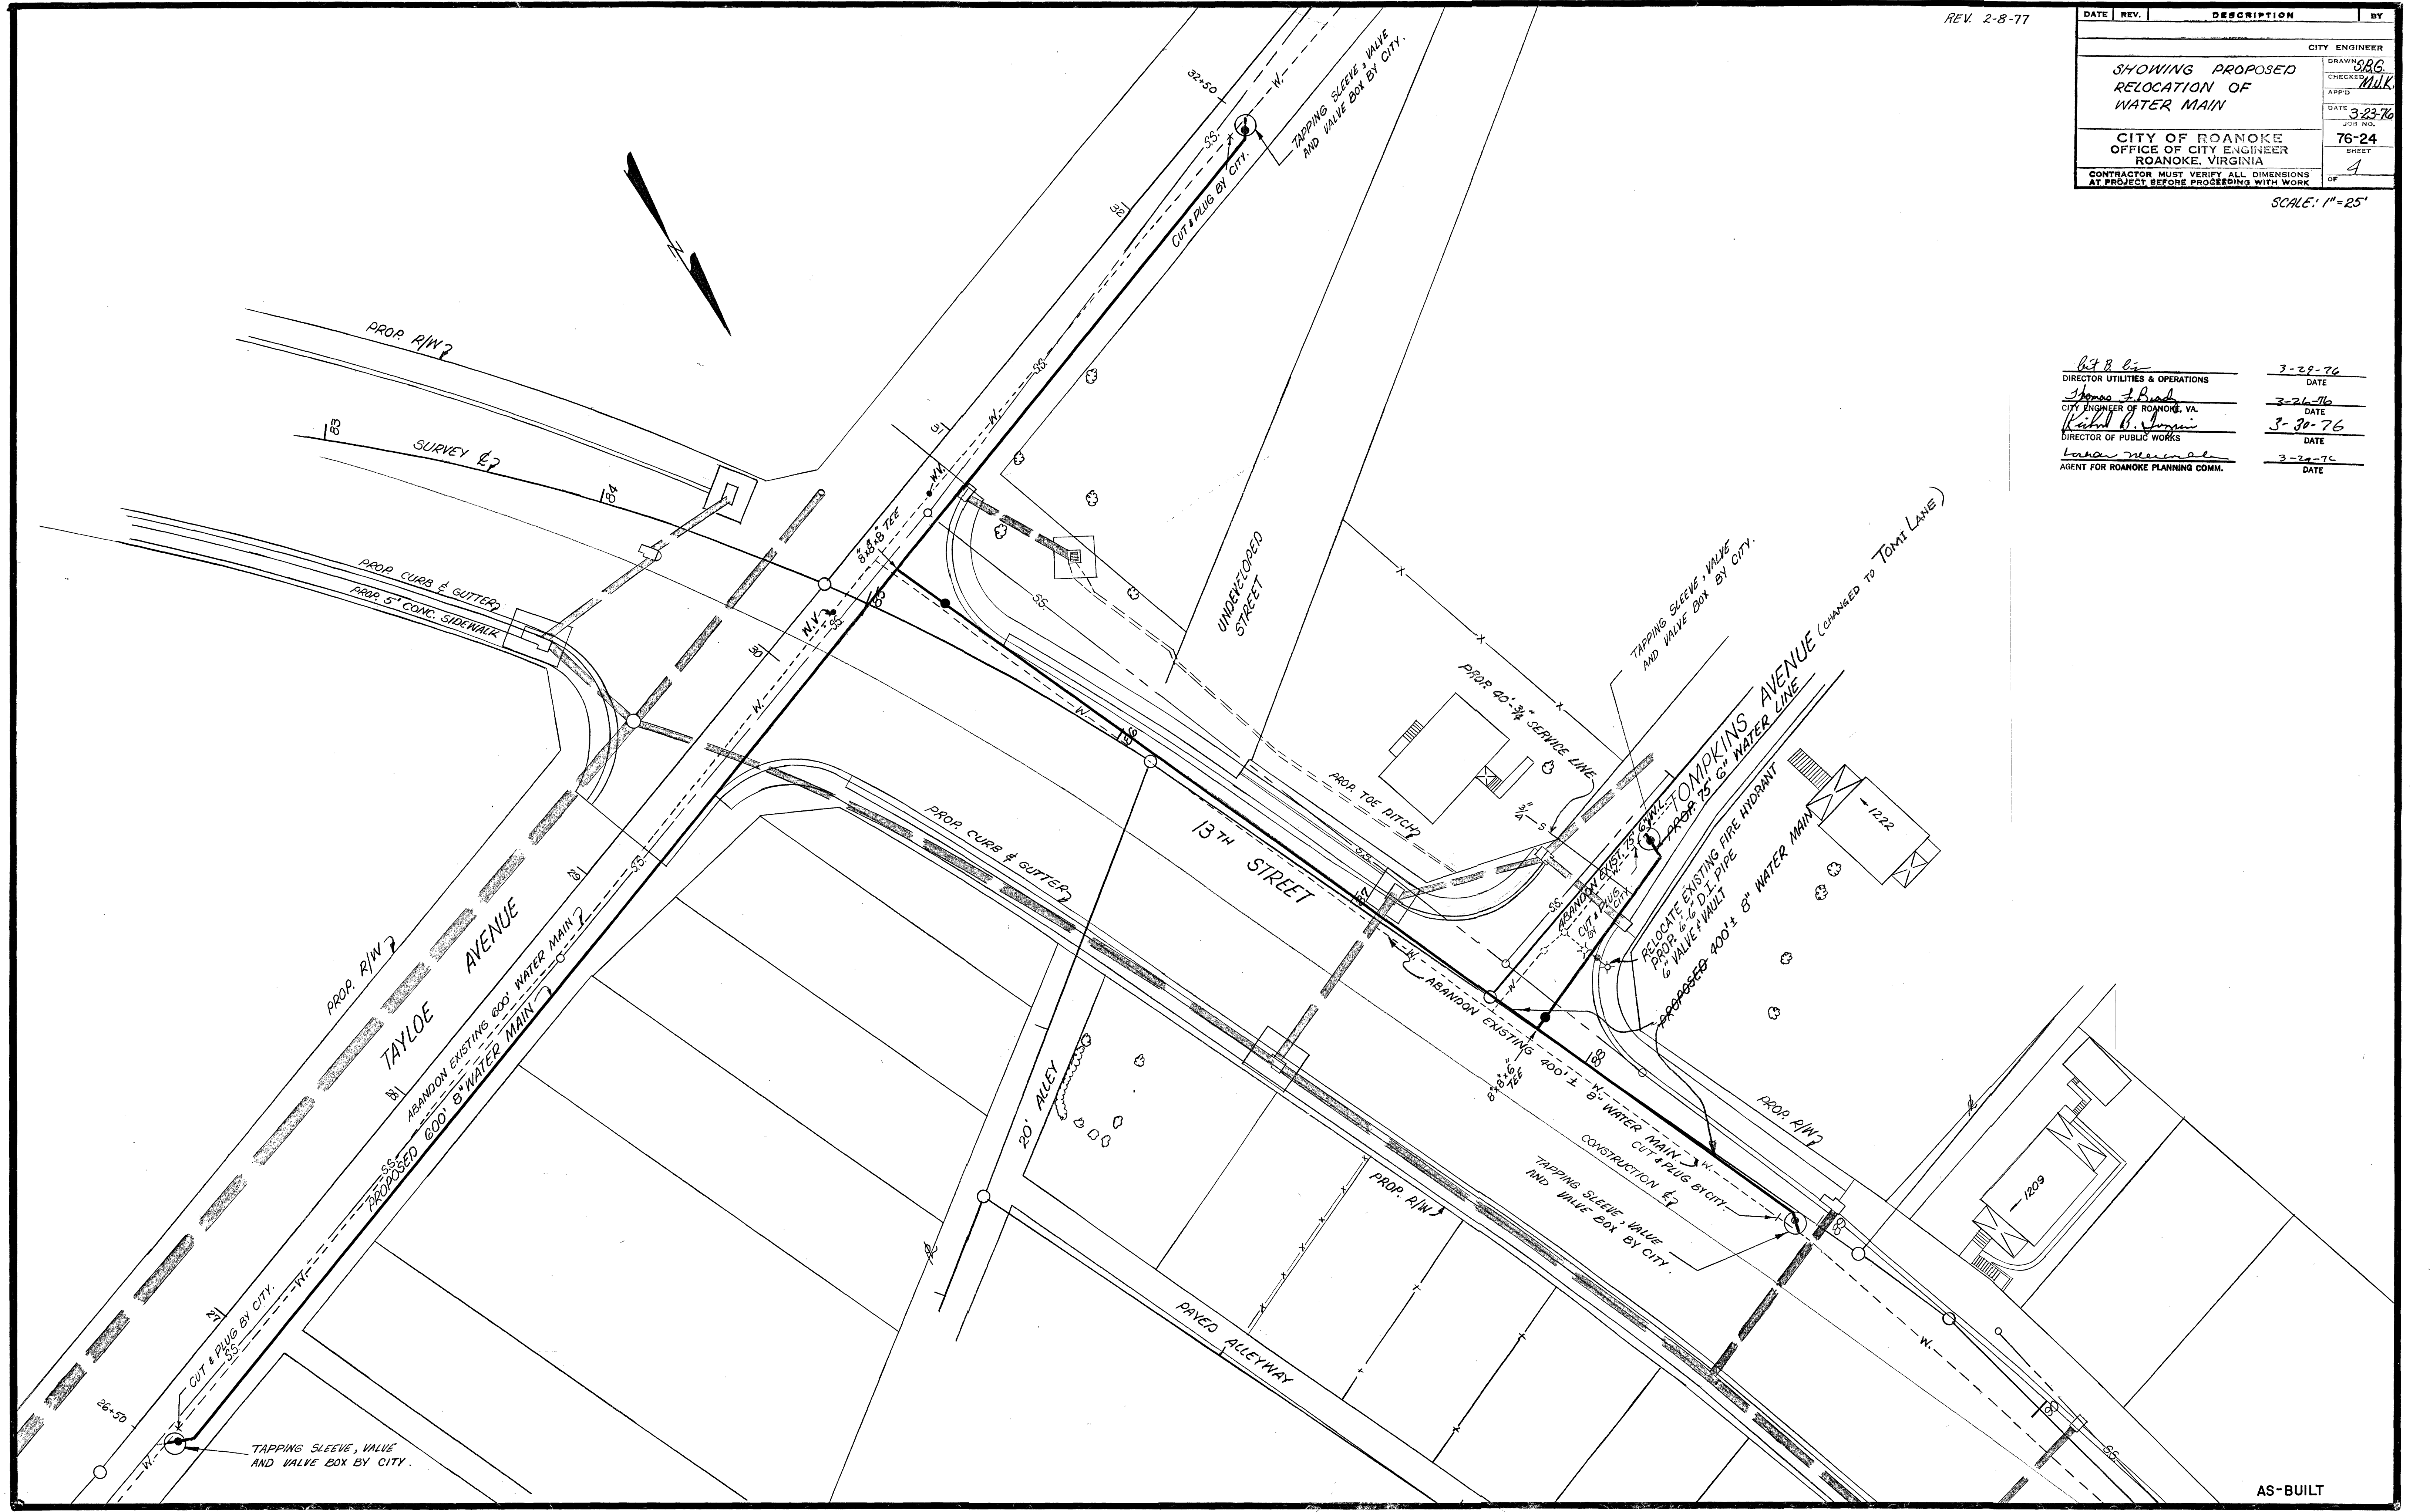

AS-BUILT