


DEVELOPMENT PLANS
FOR
SECTION #1, OFF-SITE WATER & SANITARY SEWER
"KING'S CHASE"
CAVE SPRING MAGISTERIAL DISTRICT
ROANOKE COUNTY, VIRGINIA

DATE: 15 FEBRUARY 1989
AS-BUILT: 29 DECEMBER 1989
PROPERTY OF

FRALIN & WALDRON, INC.

INDEX OF DRAWINGS

SHEET	DESCRIPTION
1	BTL&A COVER SHEET
2	ROANOKE COUNTY COVER SHEET
3	RECORD PLAT (2 SHEETS)
4	NOTES & DETAILS
5	PLAN & PROFILES SECTION # 1
6	PLAN & PROFILES SECTION # 1
7	PLAN & PROFILES FUTURE SECTION
8	PLAN & PROFILES FUTURE SECTION
9	SANITARY SEWER PROFILES (SECTION # 1)
9A	SANITARY SEWER PROFILES
10	STORM DRAIN PROFILES
11	OFFSITE WATER PLAN & PROFILES
12	OFFSITE WATER PLAN & PROFILES
13	OFFSITE SANITARY SEWER PLAN & PROFILES
14	OFFSITE SANITARY SEWER PLAN & PROFILES
15	EROSION CONTROL & DRAINAGE DIVIDES
16	ROANOKE COUNTY EROSION CONTROL DETAIL
17	ROANOKE COUNTY WATER DETAIL
18	ROANOKE COUNTY SANITARY SEWER DETAIL

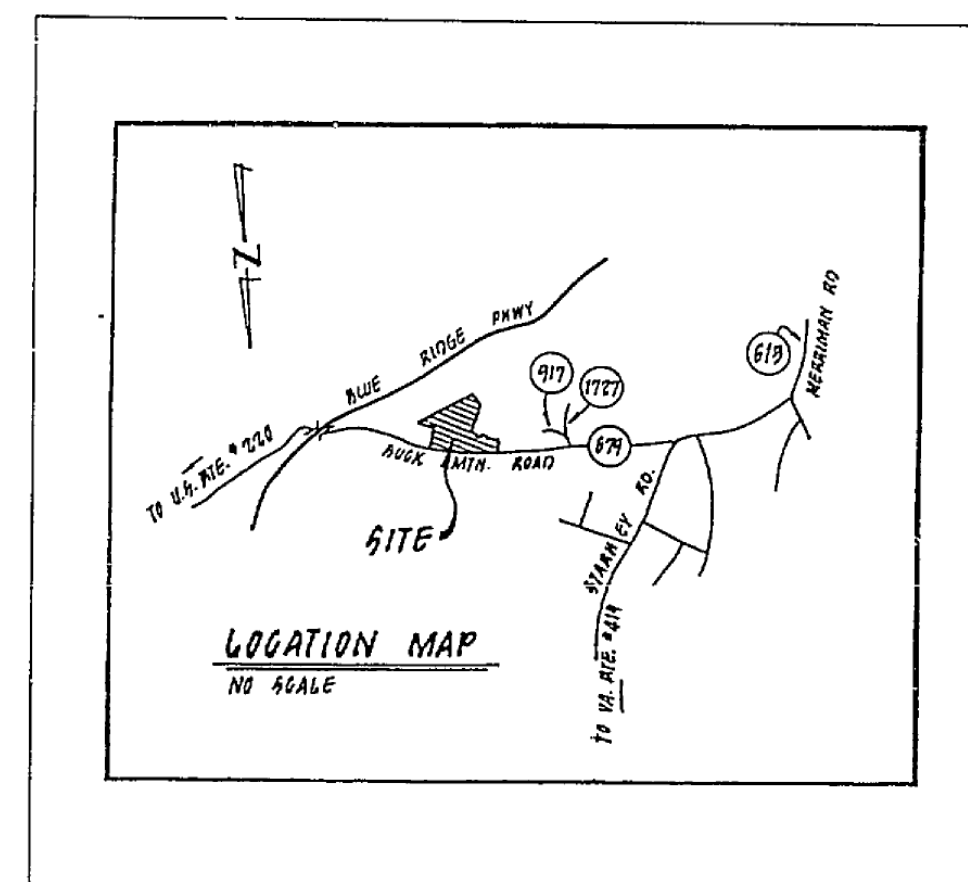

APPROVE "AS-BUILT"
PLANS DATE 12-29-89



Review Number: AS-BUILT
Development Name: Kings Chase - Section 1
Off-site Water and Sewer
Project No: 88-SB-00724

BUFORD T. LUMSDEN & ASSOCIATES, P.C.
ENGINEERS - SURVEYORS
ROANOKE, VIRGINIA

RC-0420 SHEET #1 OF 1