


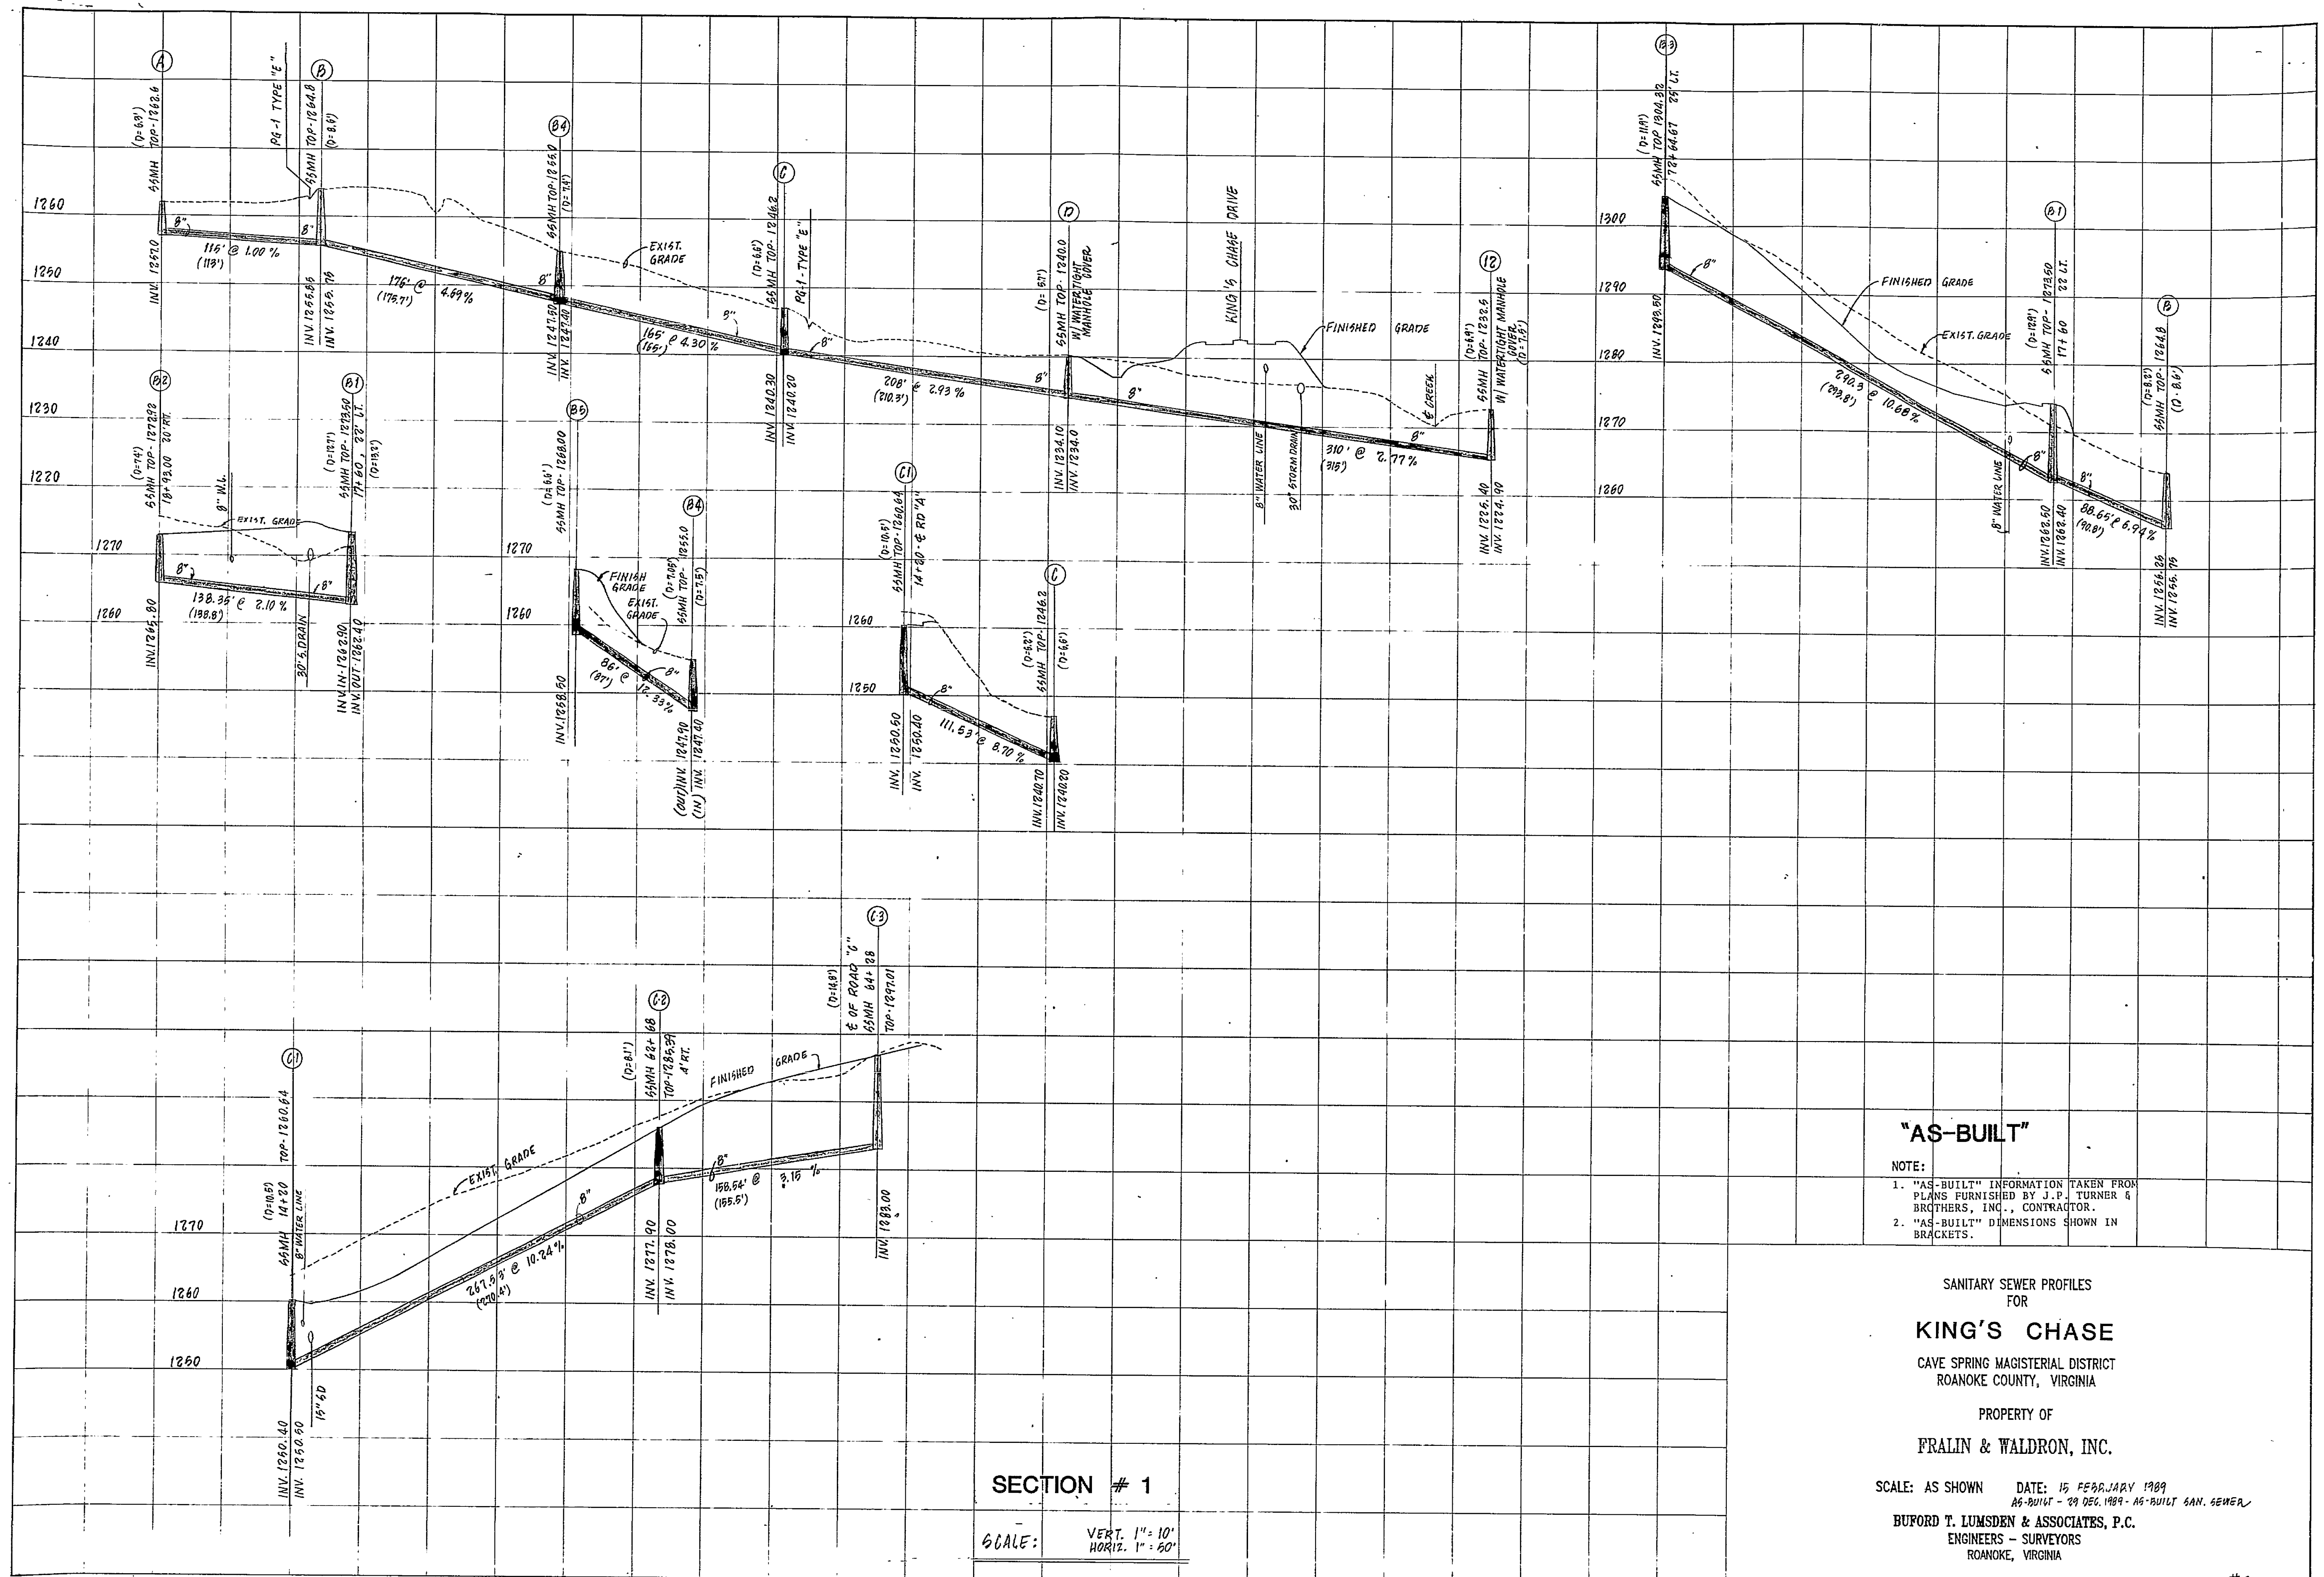

"AS-BUILT"

- NOTE:
1. "AS-BUILT" INFORMATION TAKEN FROM PLANS FURNISHED BY J.P. TURNER & BROTHERS, INC., CONTRACTOR.
 2. "AS-BUILT" DIMENSIONS SHOWN IN BRACKETS.

SANITARY SEWER PROFILES
FOR
KING'S CHASE
CAVE SPRING MAGISTERIAL DISTRICT
ROANOKE COUNTY, VIRGINIA

PROPERTY OF
FRALIN & WALDRON, INC.

SCALE: AS SHOWN DATE: 15 FEBRUARY 1989
AS-BUILT - 29 DEC. 1989 - AS-BUILT SAN. SEWER
BUFORD T. LUMSDEN & ASSOCIATES, P.C.
ENGINEERS - SURVEYORS
ROANOKE, VIRGINIA

SECTION # 1

SCALE: VERT. 1" = 10'
HORIZ. 1" = 60'

