



25+75 MATCH LINE  
FOR SHEET 11 OF 18

PLAN  
SUBMITTED  
NOTE BOOK ASSIGNMENT CHECKED  
No. 1  
DATE

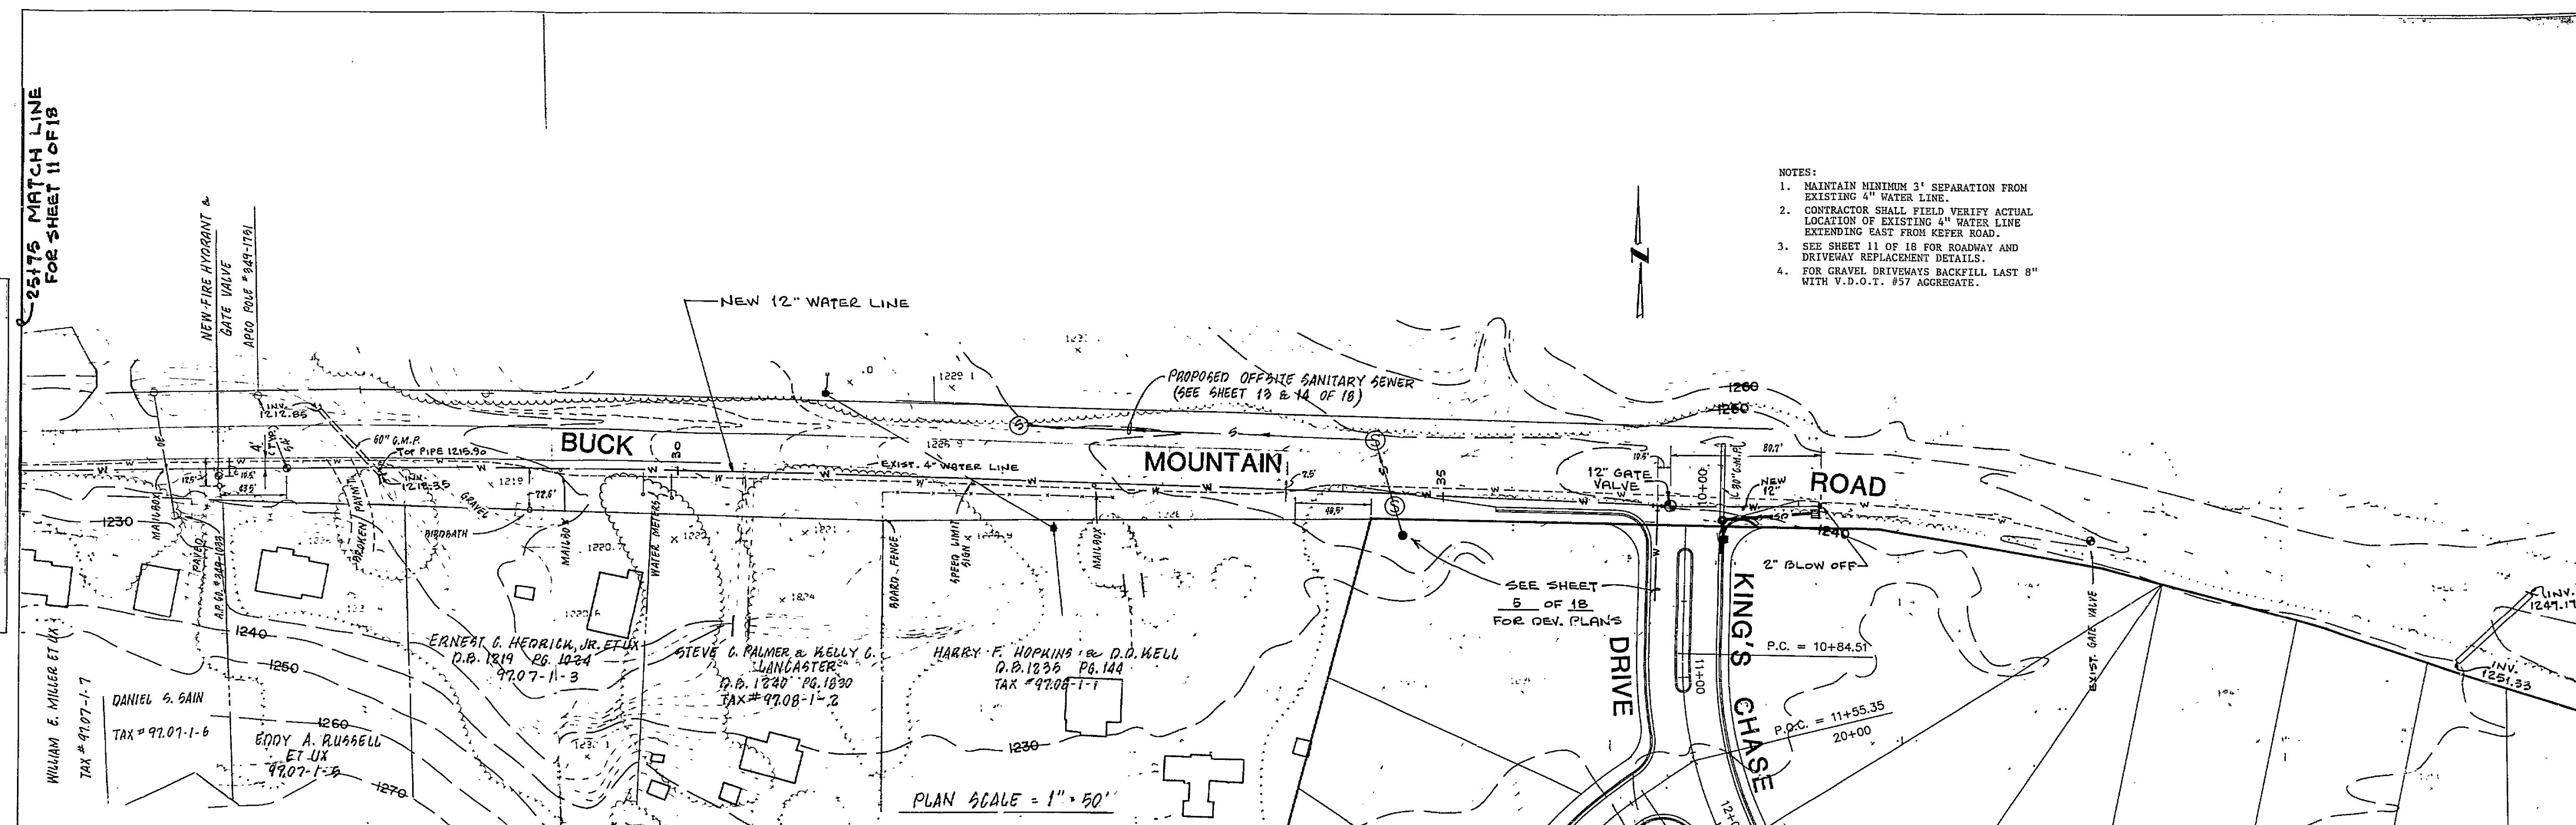

PROFILE  
SUBMITTED  
NOTE BOOK  
No. 1  
DATE

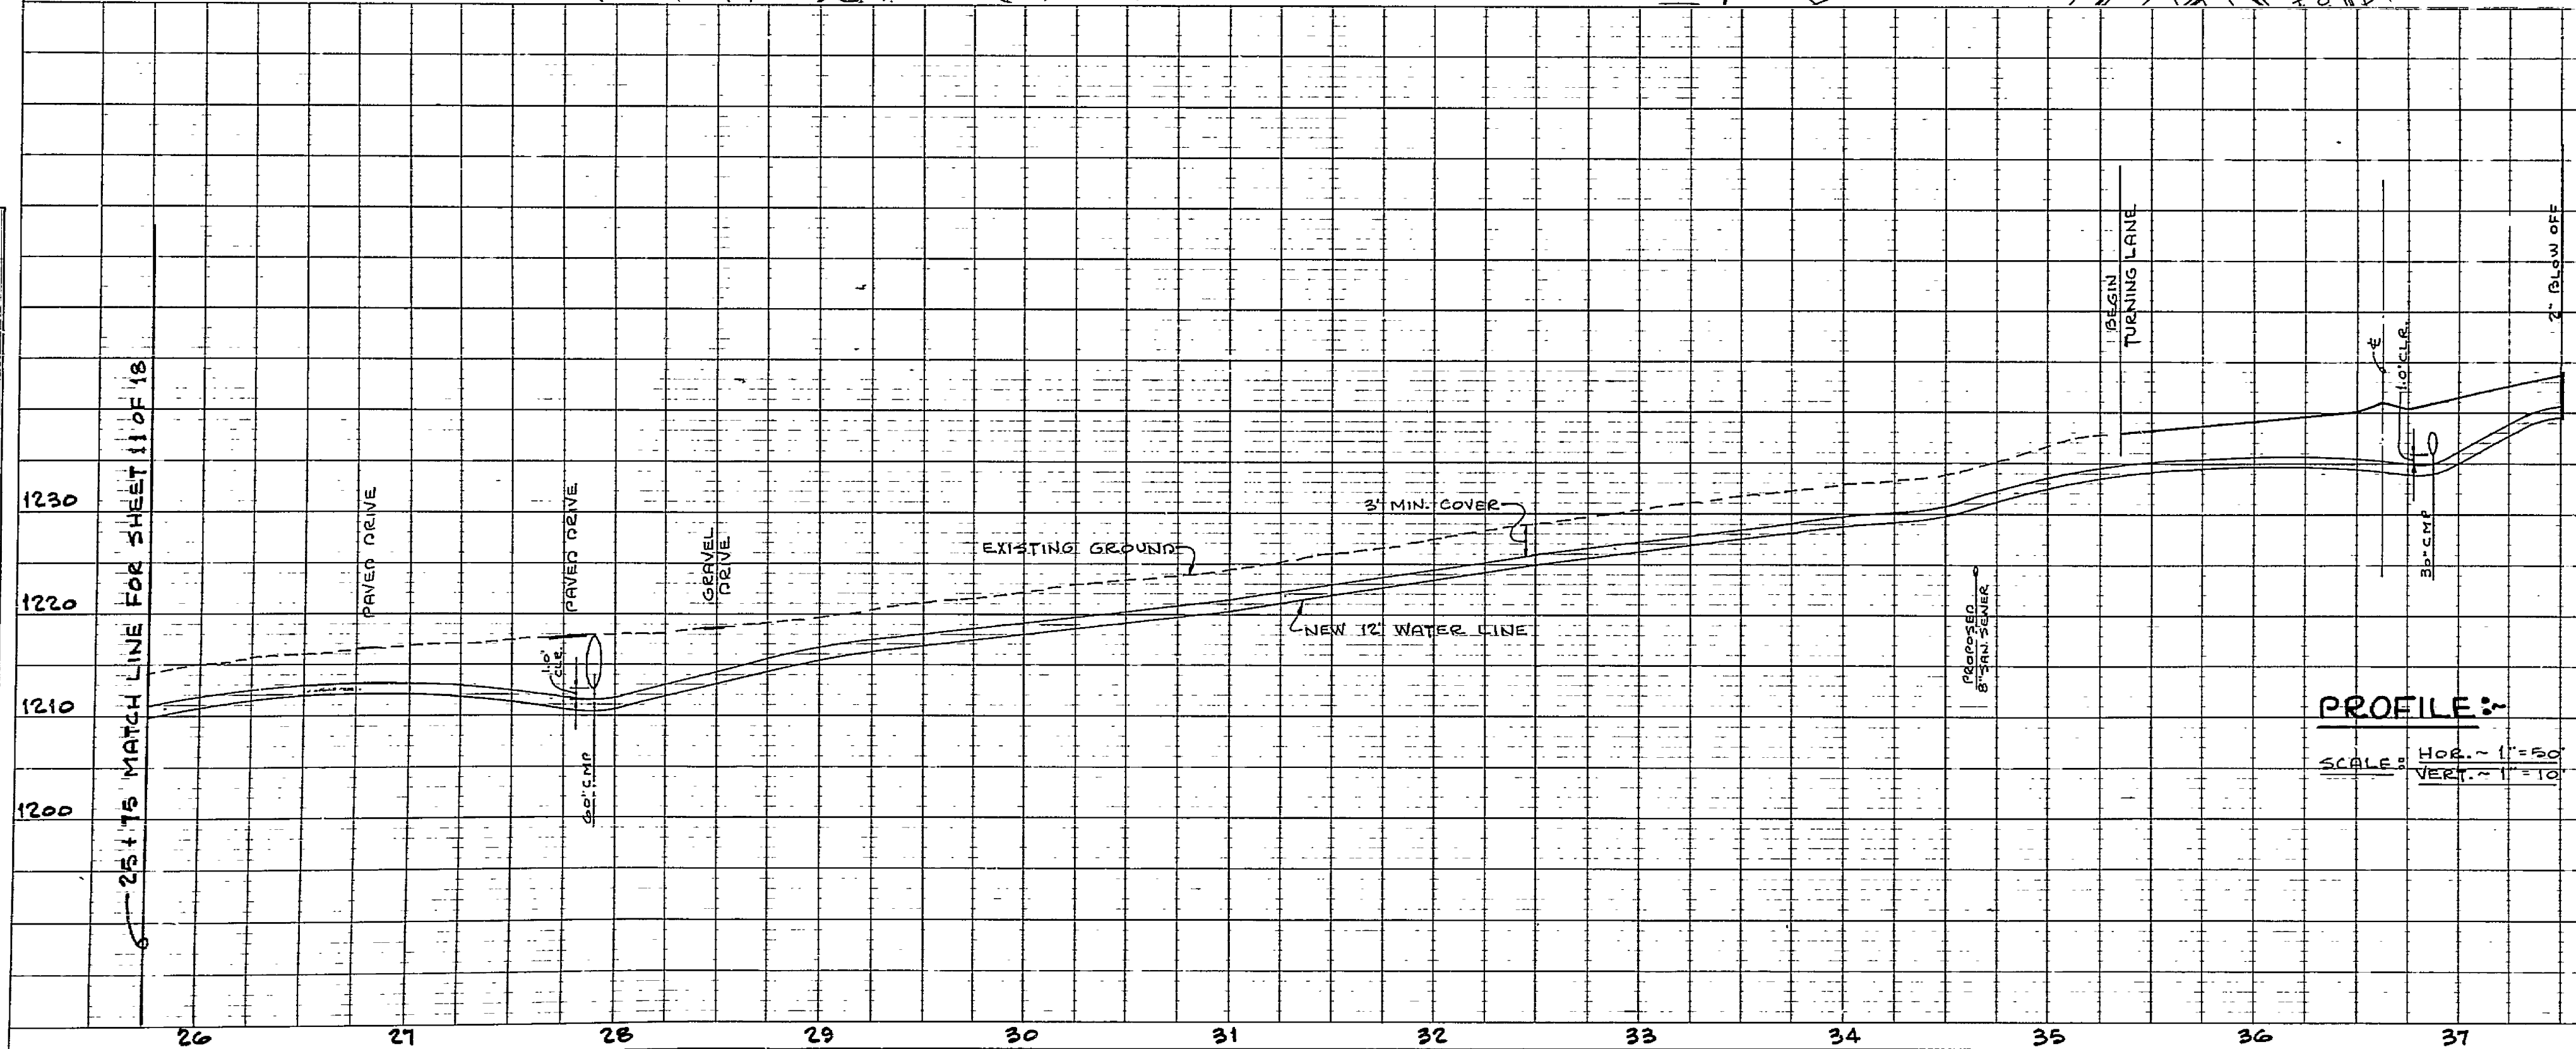

**"AS-BUILT"**

NOTE:  
1. "AS-BUILT" INFORMATION TAKEN FROM PLANS FURNISHED BY J. P. TURNER & BROTHERS, INC., CONTRACTOR.  
2. "AS-BUILT" DIMENSIONS SHOWN IN BRACKETS.

PLAN & PROFILE  
OFFSITE  
WATER LINE EXTENSION  
FOR

**KING'S CHASE**

CAVE SPRING MAGISTERIAL DISTRICT  
ROANOKE COUNTY, VIRGINIA

PROPERTY OF

**FRALIN & WALDRON, INC.**

SCALE AS SHOWN

DATE: 15 FEBRUARY 1989

AS-BUILT: 23 DEC 1989 - AS-BUILT  
WATER LINE  
BUFORD T. LUMSDEN & ASSOCIATES, P.C.  
ENGINEERS - SURVEYORS  
ROANOKE, VIRGINIA

# 83-208

SHEET 12 OF 18

PLATE 1-SINGLE PLAN AND PROFILE-FULL LINE  
PRINTED IN U.S.A.

RC-0433

