
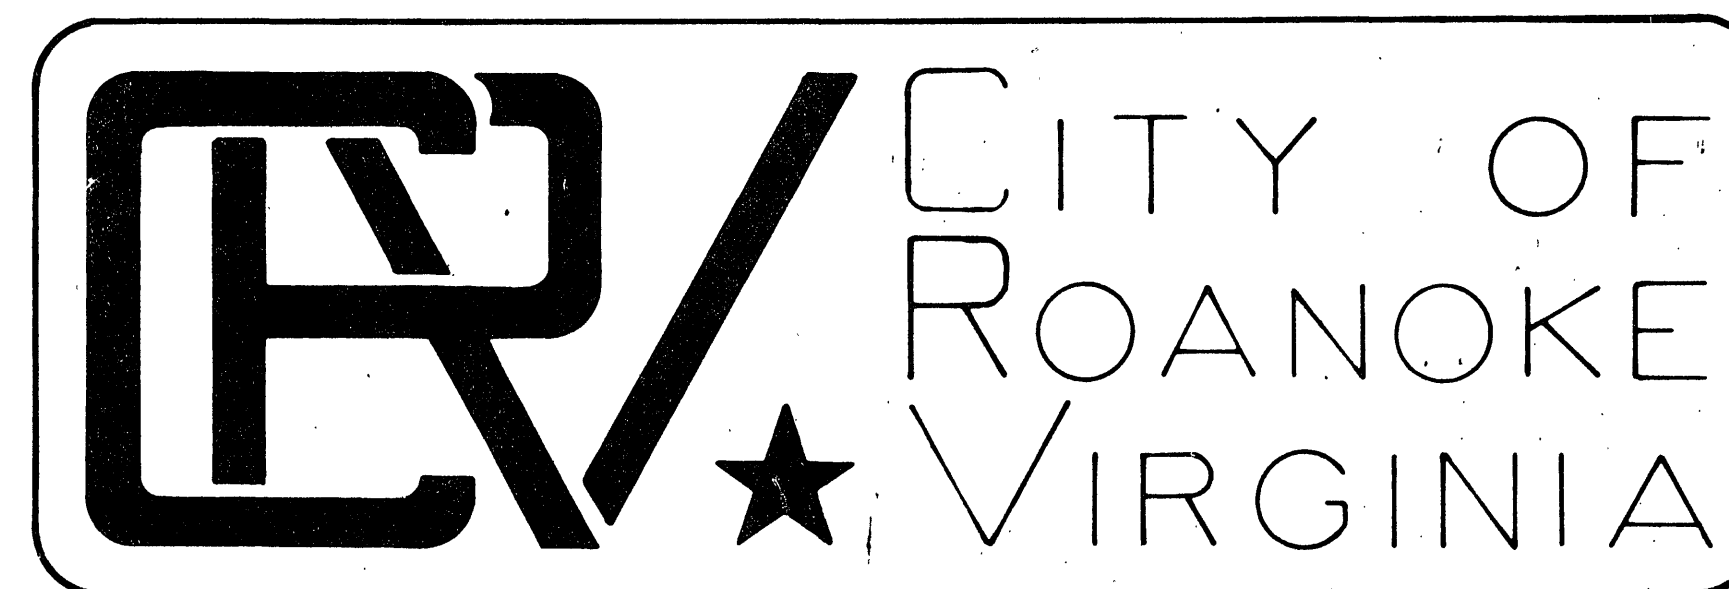


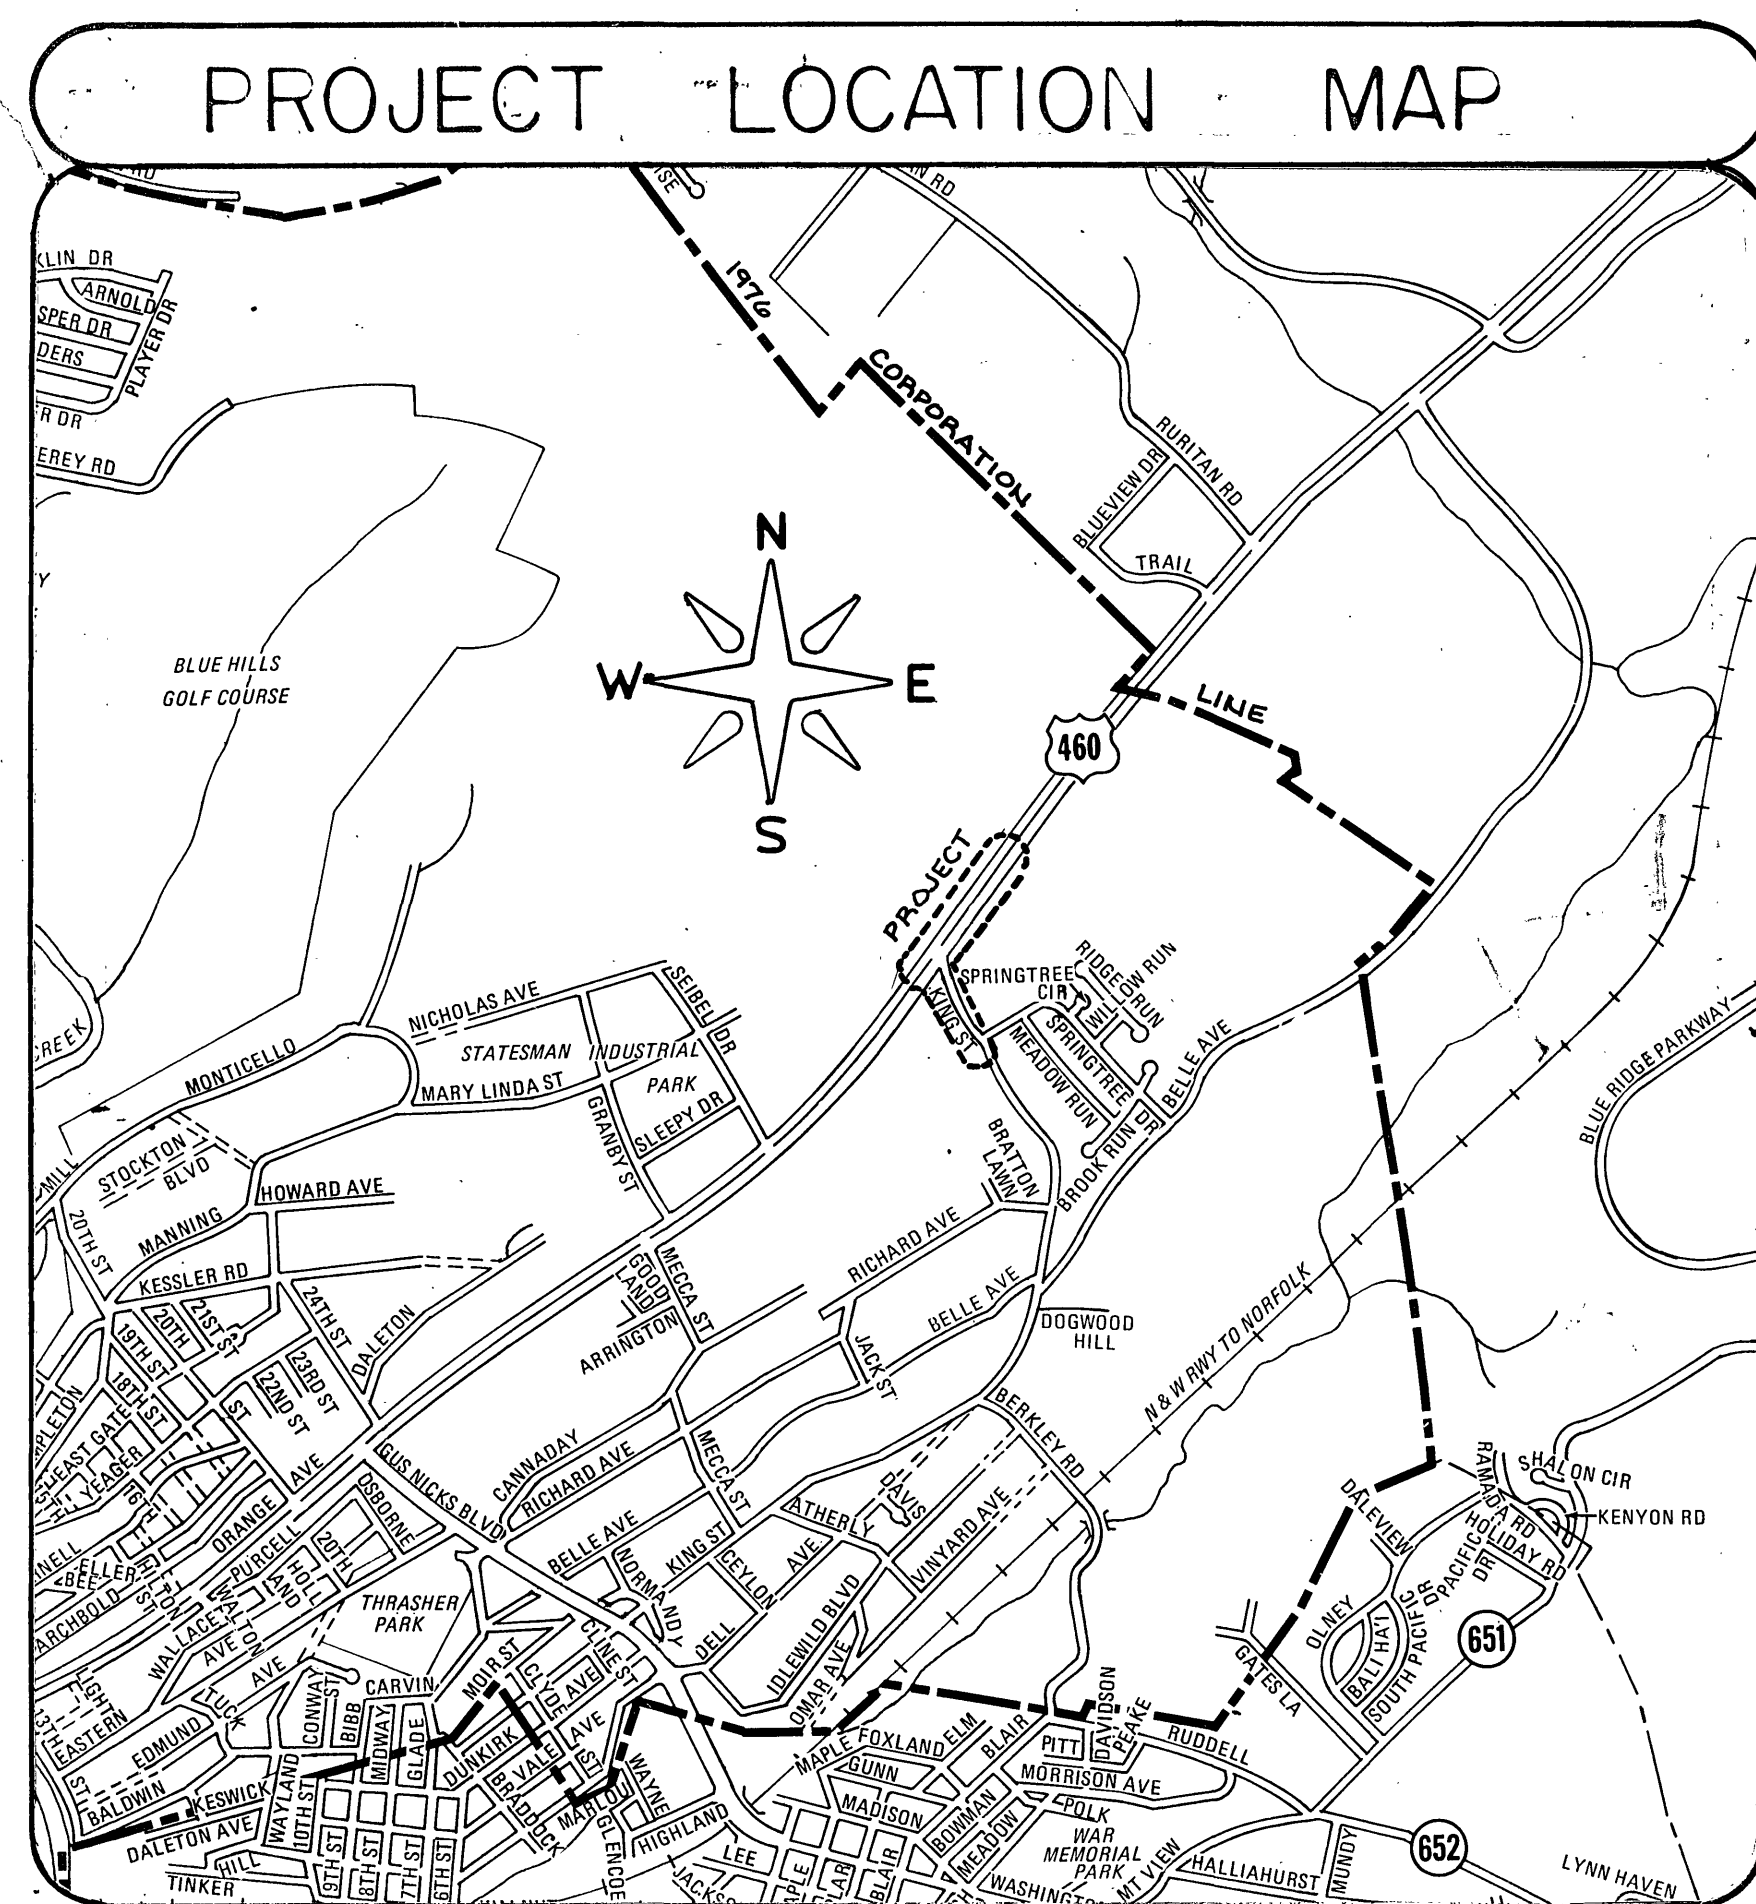

OFFICE OF CITY ENGINEER
ROOM 350
MUNICIPAL BUILDING
215 CHURCH AVENUE, S.W.
ROANOKE, VIRGINIA 24011

INDEX OF SHEETS	
SHEET NUMBER	DESCRIPTION
1	COVER SHEET WITH LOCATION MAP
2	ABBREVIATIONS, LEGEND & QUANTITIES
3	PLAN & PROFILE, STA. 10+00 to STA. 15+00
4	PLAN & PROFILE, STA. 15+00 to STA 20+46.5

CONSULTING ENGINEERS

Plans Prepared By :

CITY OF ROANOKE

ENGINEERING DEPARTMENT

215 CHURCH AVENUE

ROANOKE, VIRGINIA 24011

COMMISSION NUMBER: _____

PROJECT NAME

KING STREET — ROUTE 460

SANITARY SEWER MAIN EXTENSION

SPRINGTREE DRIVE to North side ORANGE AVENUE (ROUTE 460)

PROJECT NUMBER: **5896**

REVISION	BY	DESCRIPTION	DATE
REVISION	BY	DESCRIPTION	DATE
REVISION	BY	DESCRIPTION	DATE
REVISION	BY	DESCRIPTION	DATE

APPROVED FOR CONSTRUCTION

ROANOKE CITY ENGINEER	DATE
DIRECTOR OF PUBLIC WORKS	DATE
DIRECTOR OF UTILITIES AND OPERATIONS	DATE
	DATE
	DATE

ADVERTISED DATE :

SET NUMBER: _____

SHEET NUMBER: **1** OF **4**

AS BUILT 11/8/82