



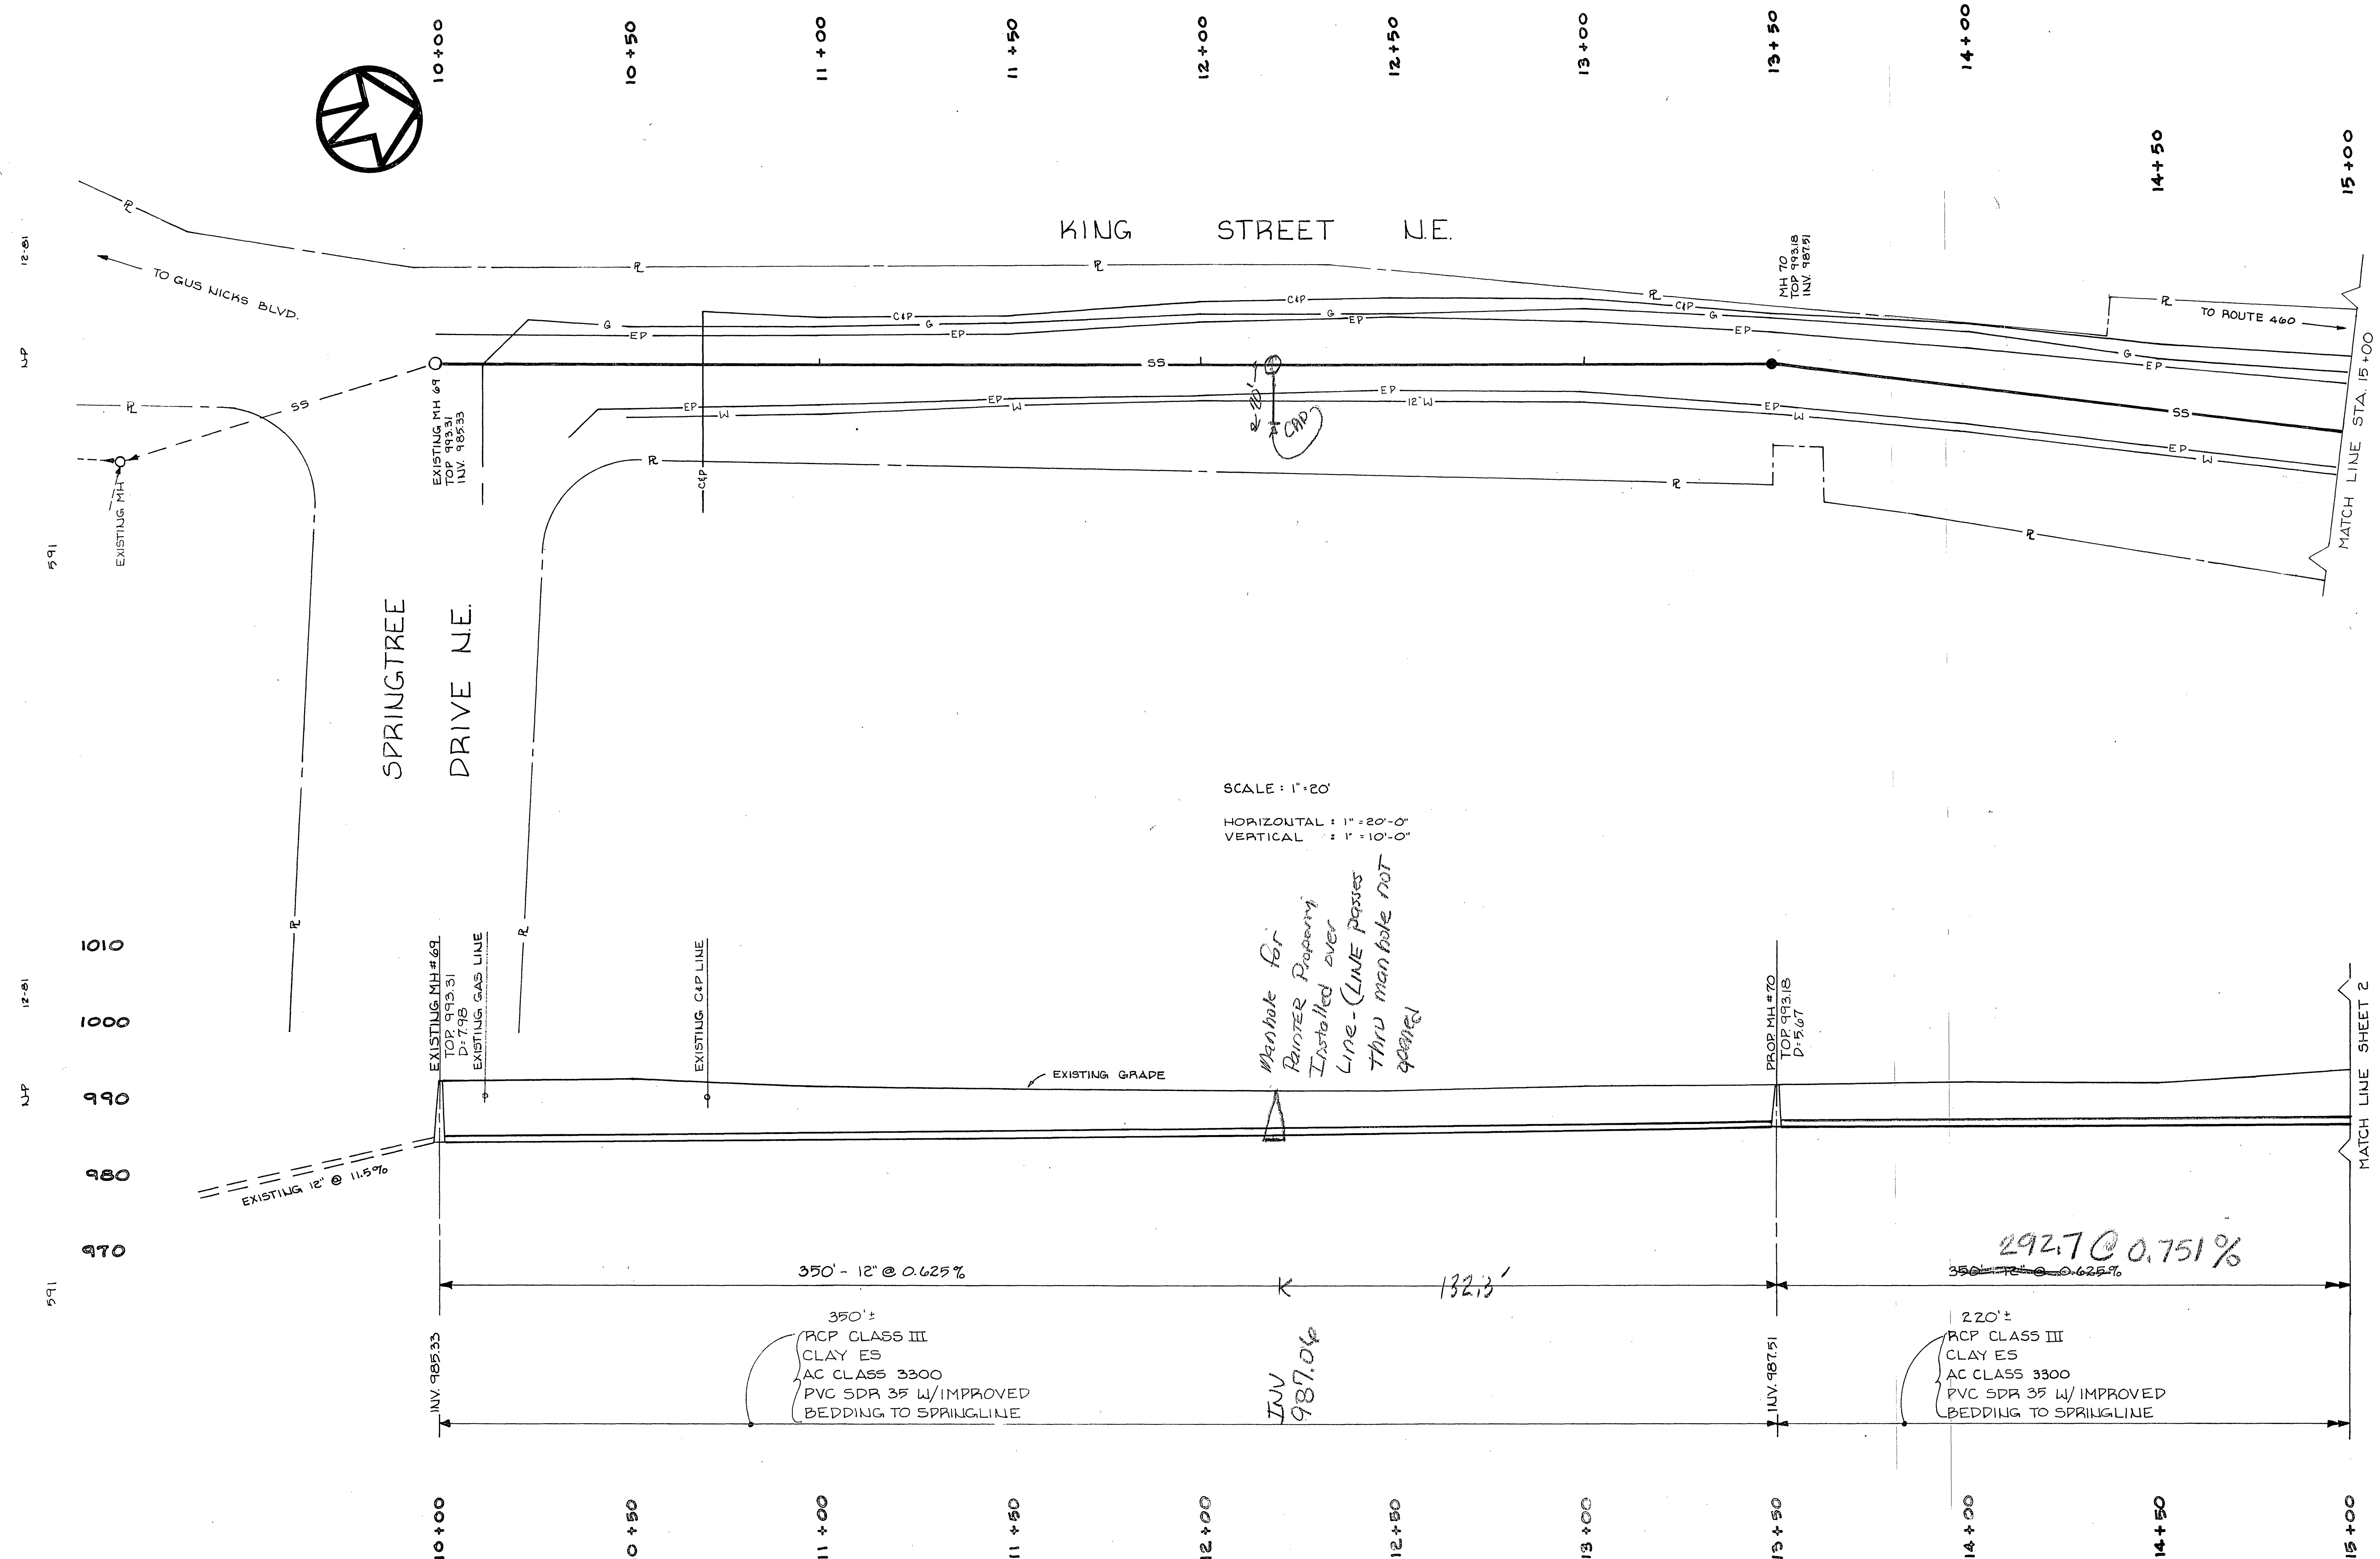

SCALE: 1"=20'
 HORIZONTAL: 1"=20'-0"
 VERTICAL: 1"=10'-0"

*Manhole for
 Rainwater Property
 Installed over
 Line - (LINE PASSES
 Thru manhole not
 shown)*

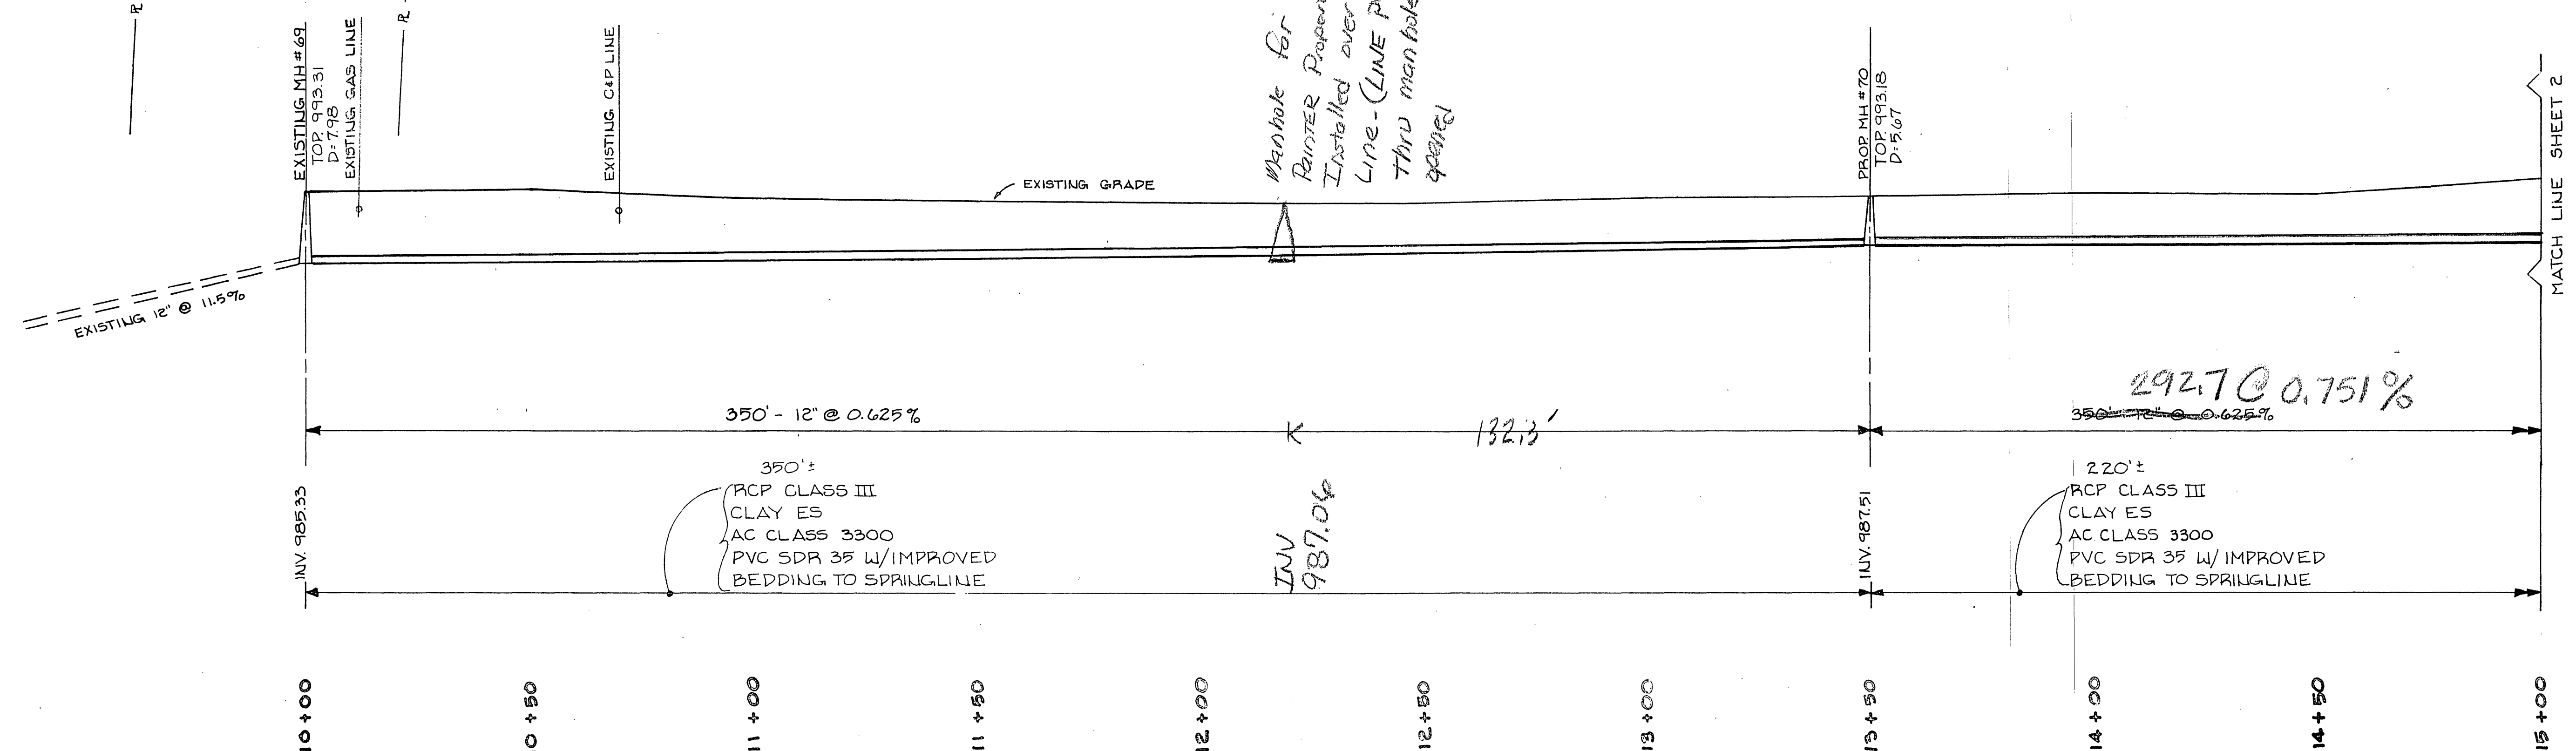

350'±
 PCP CLASS III
 CLAY ES
 AC CLASS 3300
 PVC SDR 35 W/IMPROVED
 BEDDING TO SPRINGLINE

220'±
 PCP CLASS III
 CLAY ES
 AC CLASS 3300
 PVC SDR 35 W/IMPROVED
 BEDDING TO SPRINGLINE

*As built by 4/9/82
 S.C. Rossi & Co. Inc.
 John C. Rossi
 Pres.*

5896