


9/4/87 1505

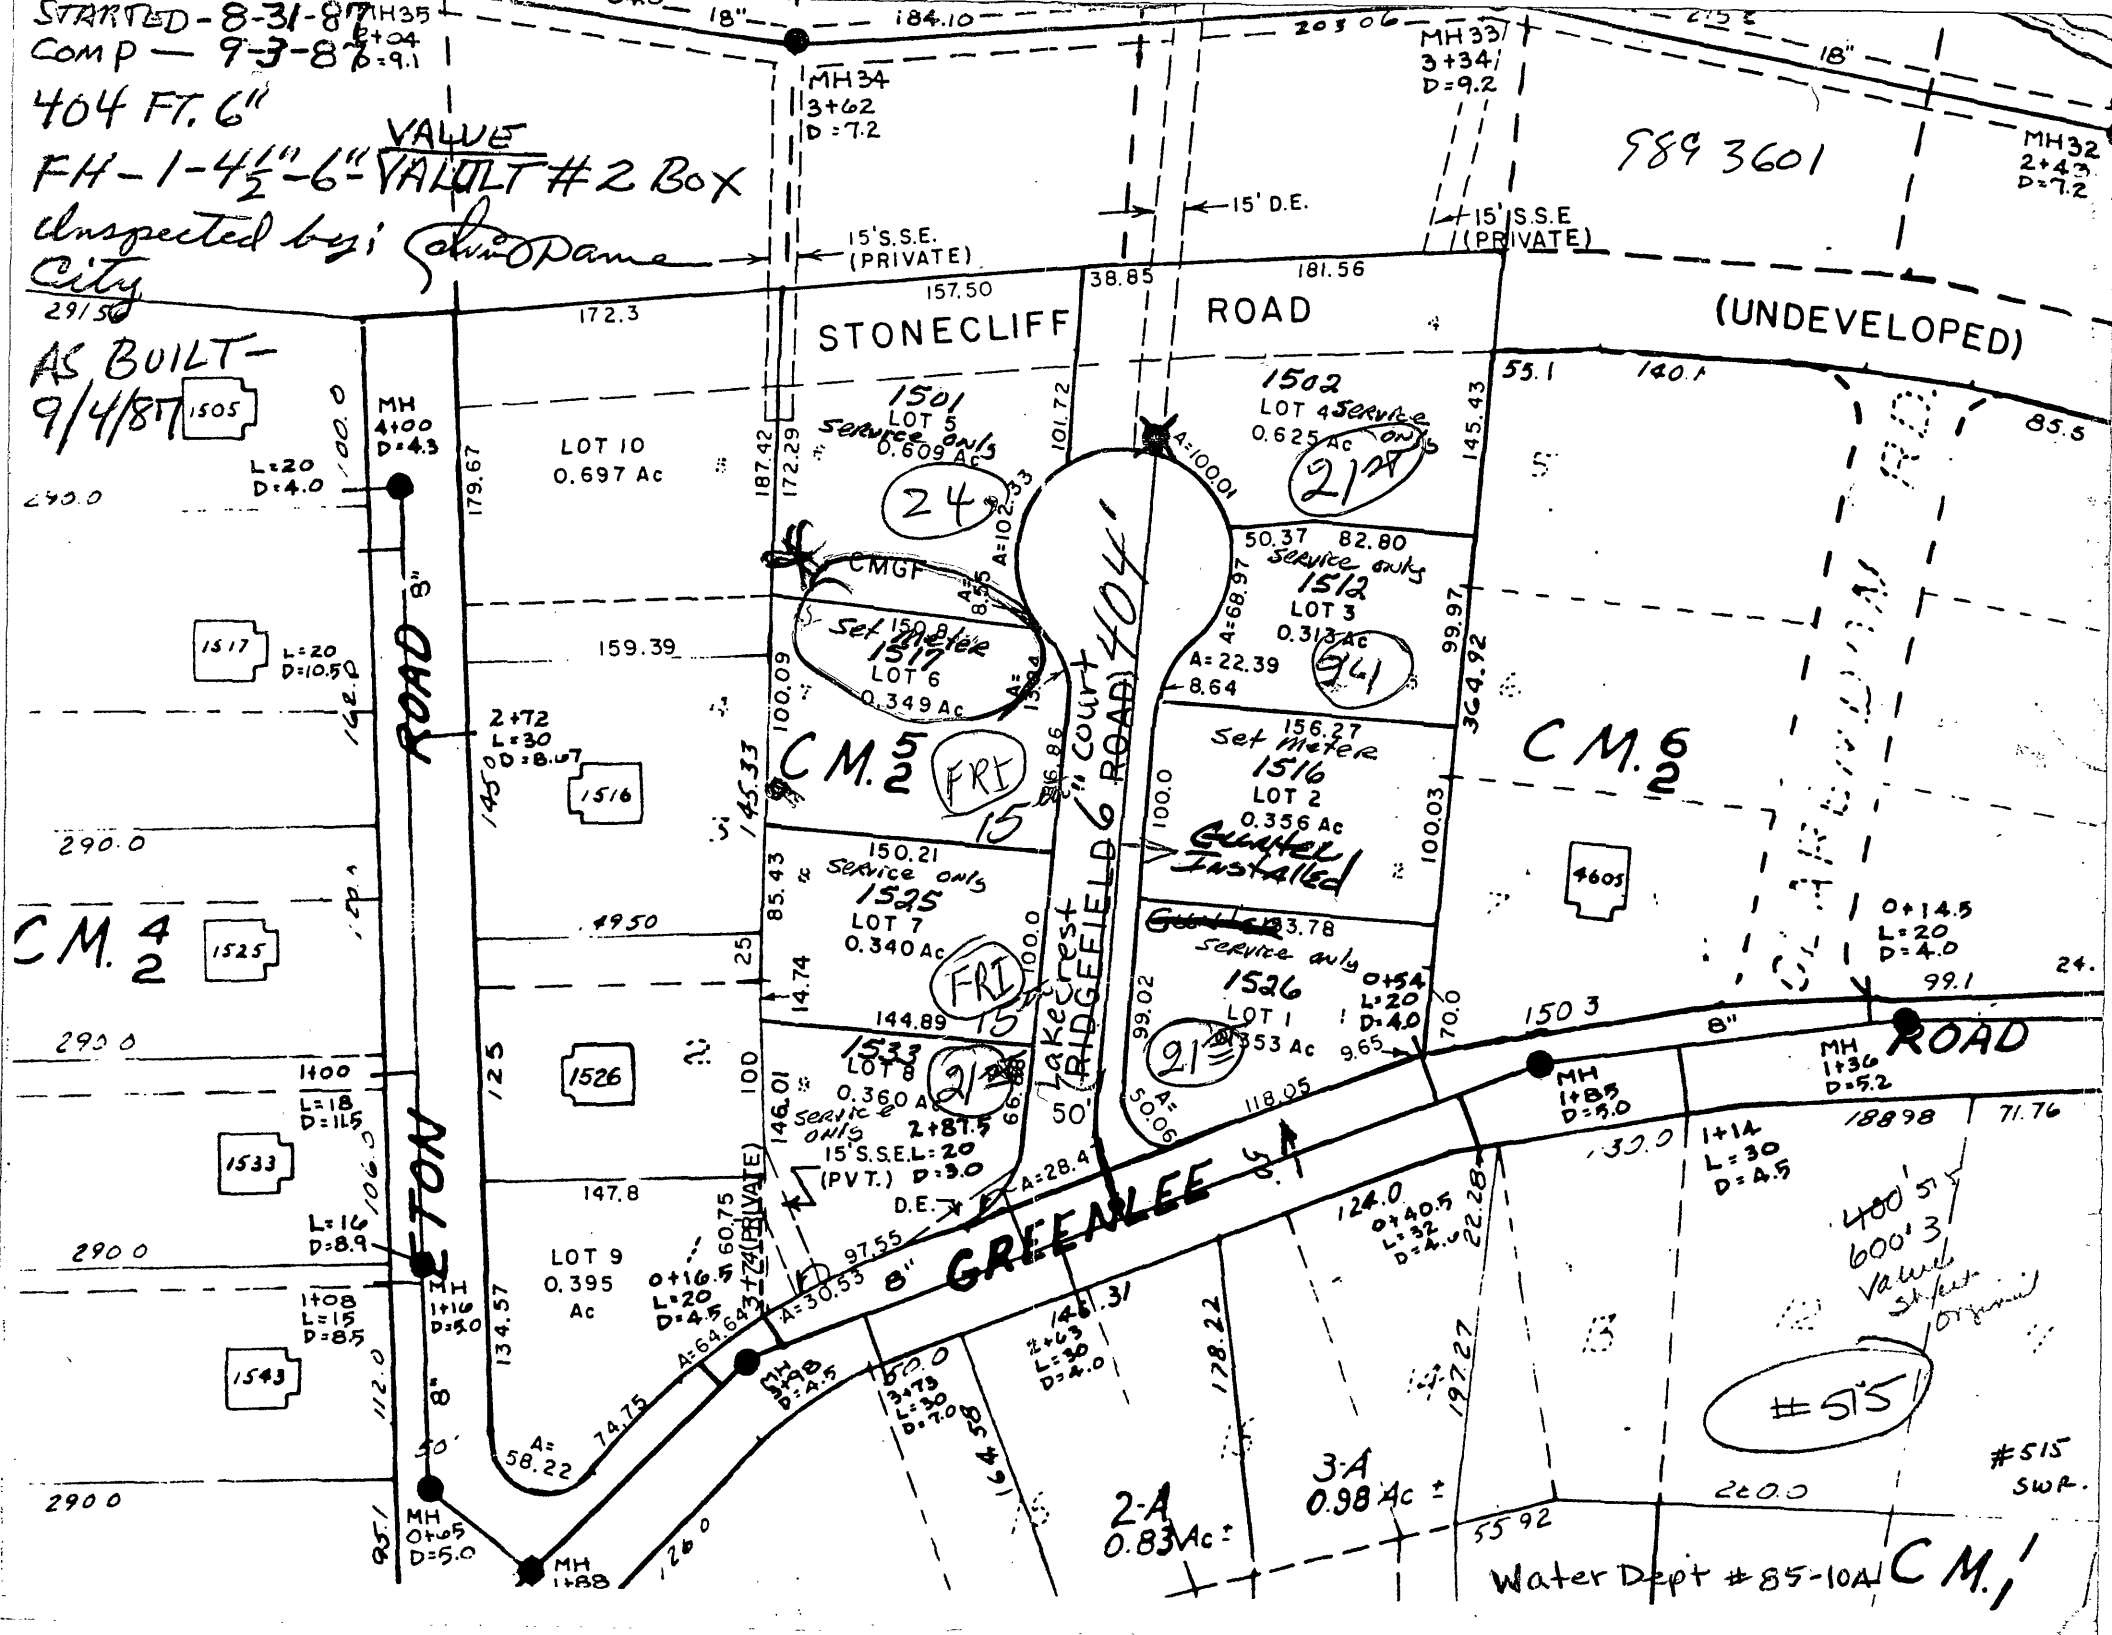

Water Dept #85-10A C.M.,