
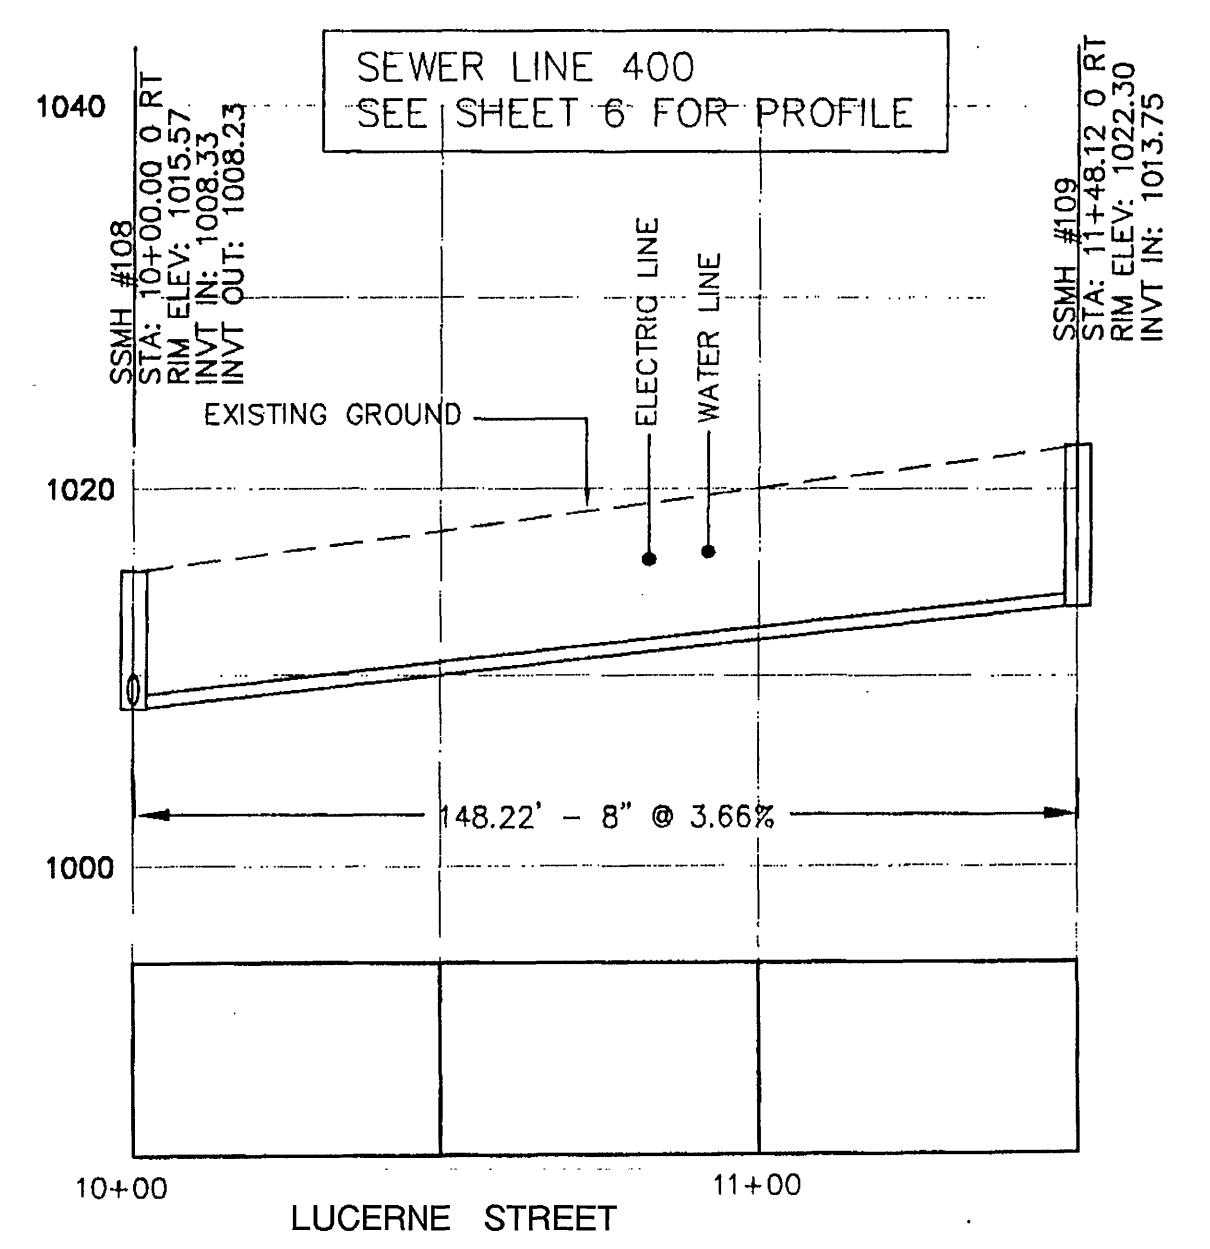
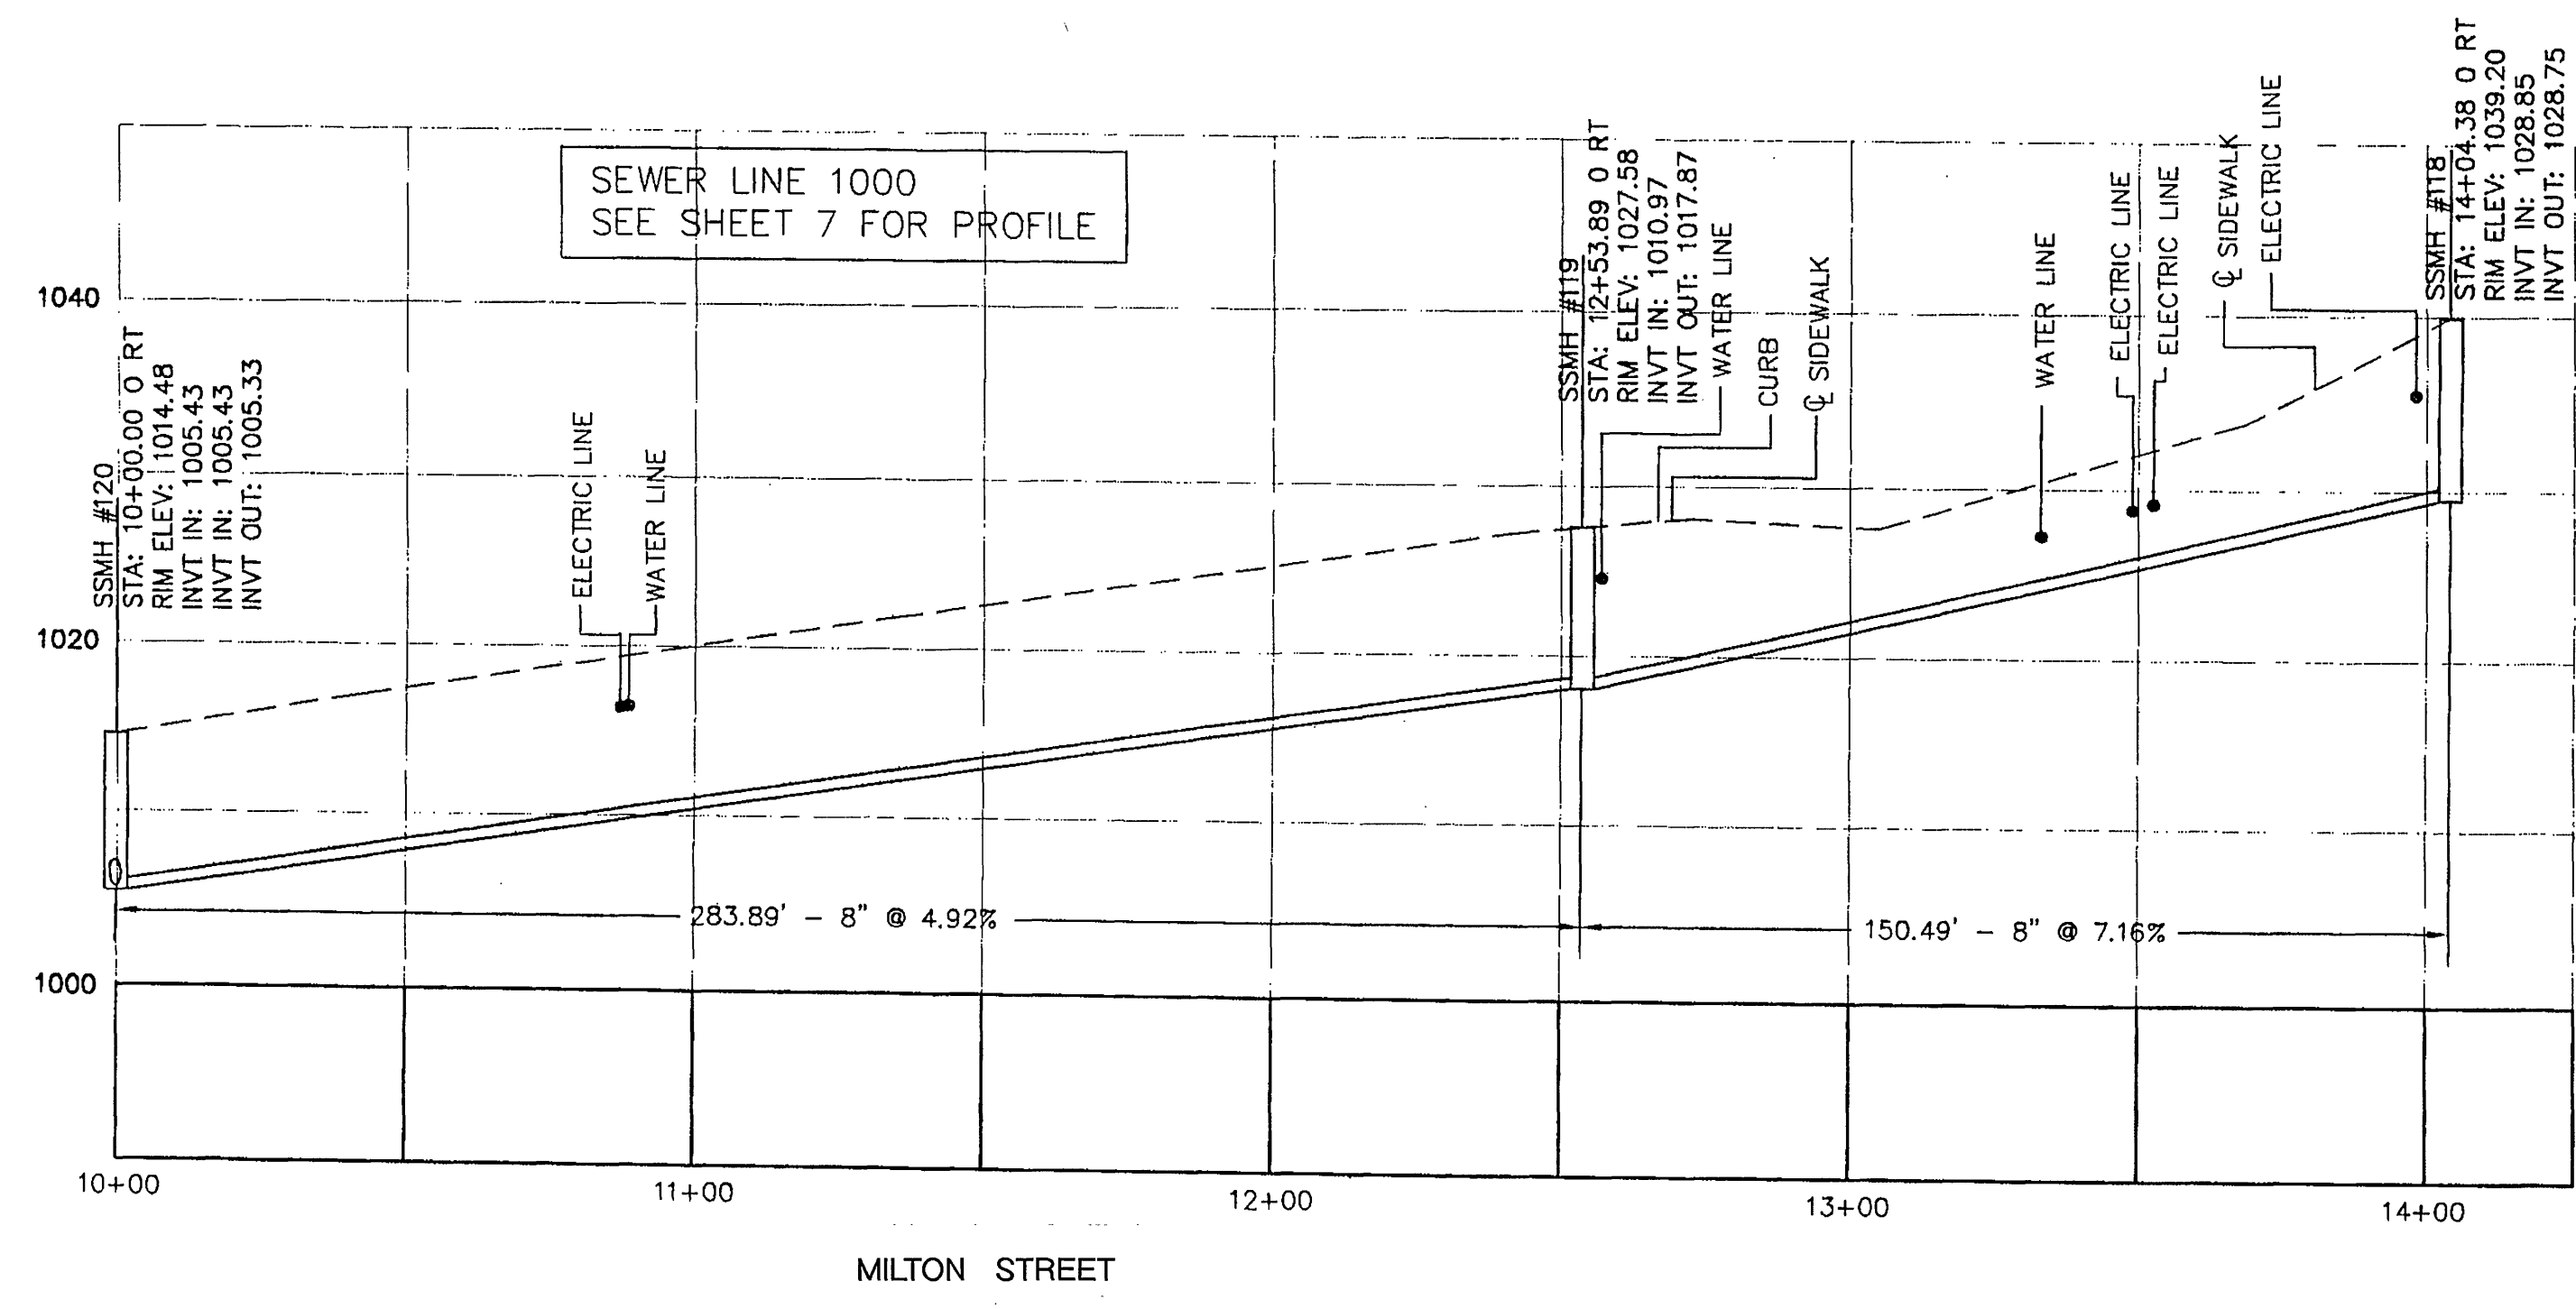
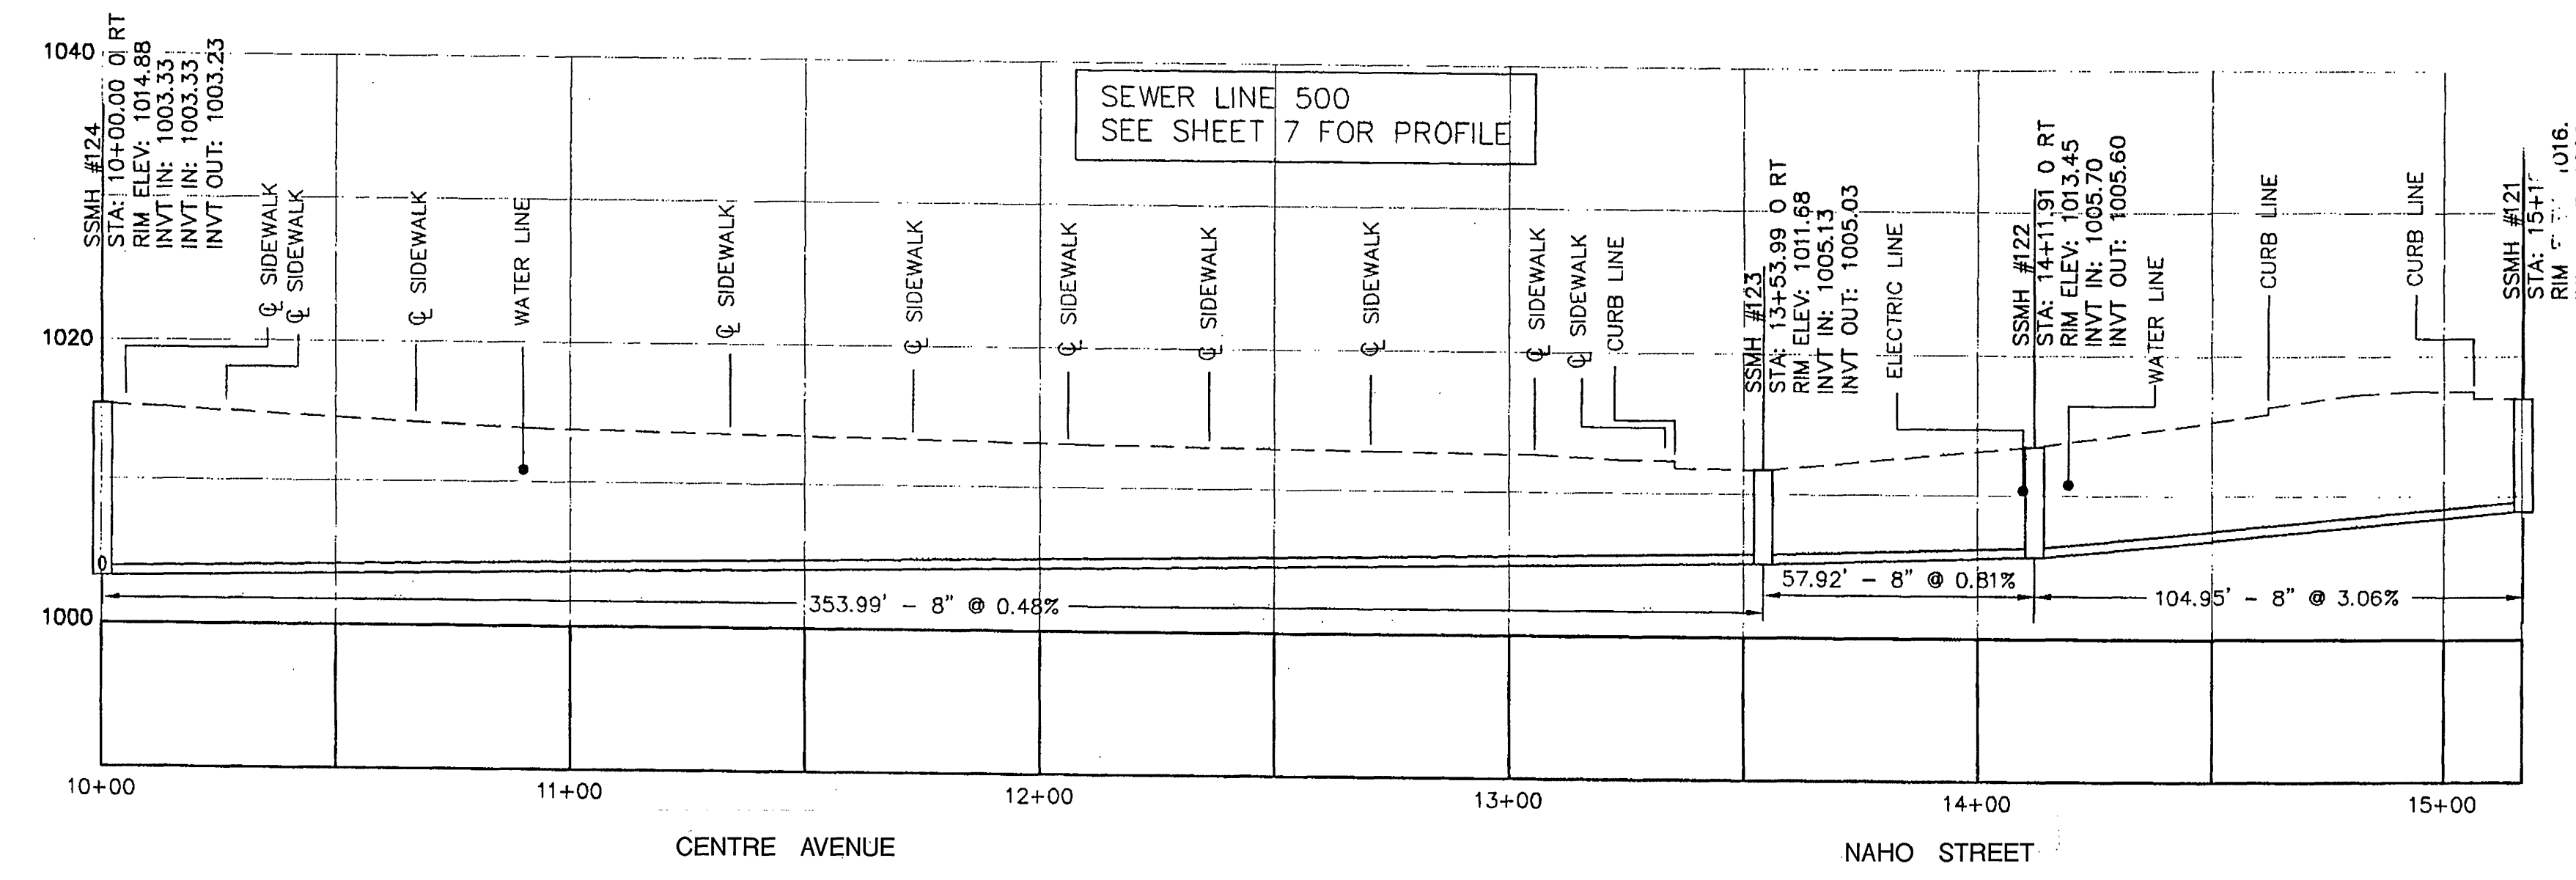



C:\DWG5\1136\1136PROL.DWG DATE: 5/2/97

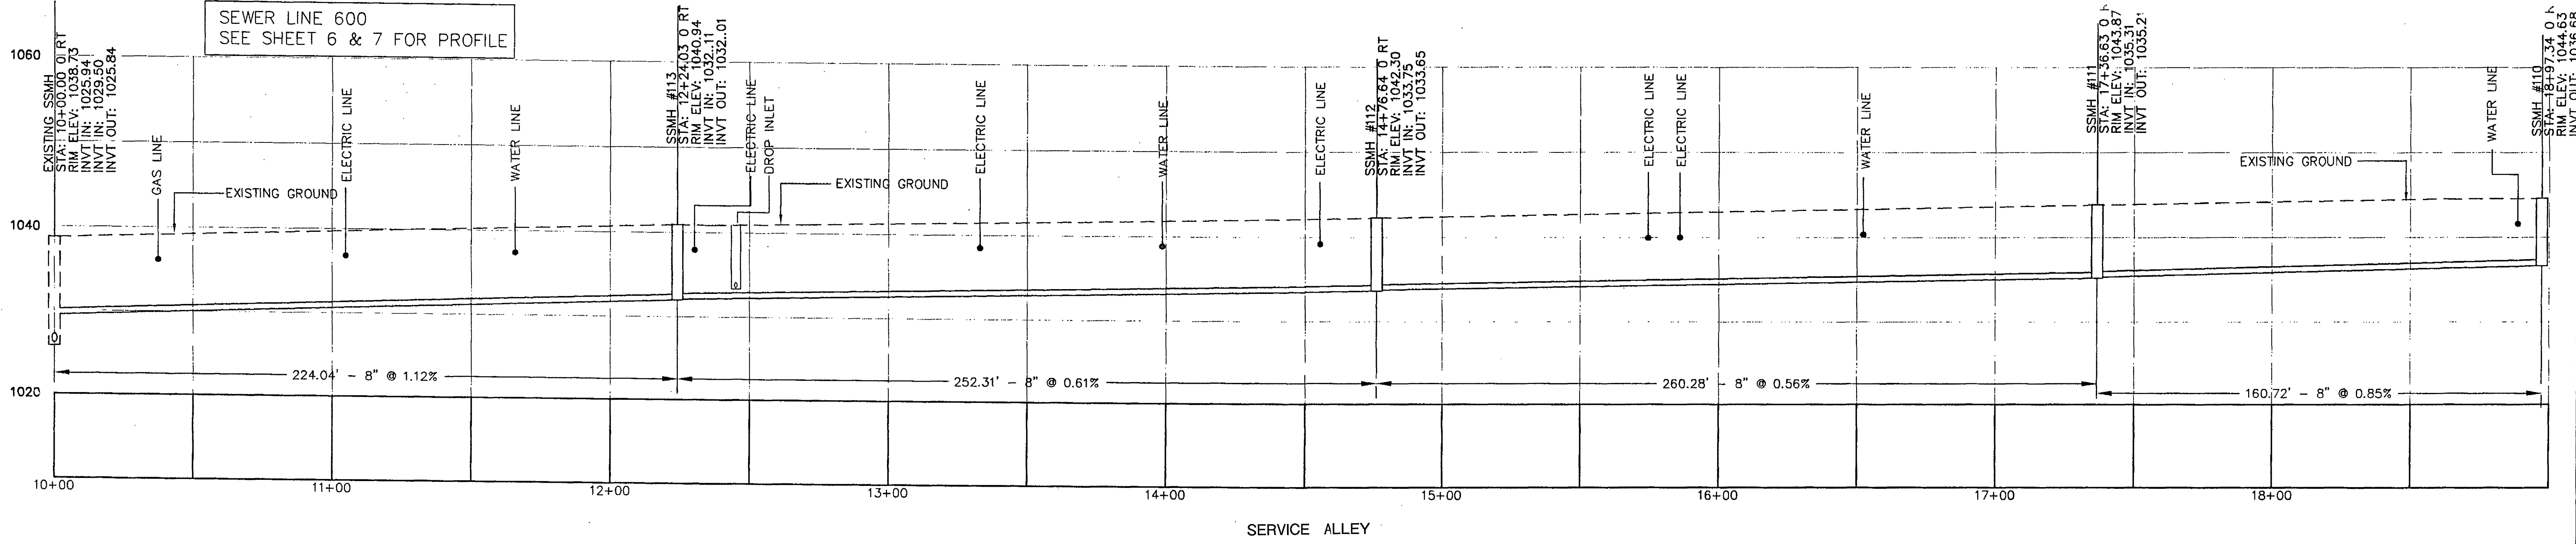

**L M W P.C.**  
 ENGINEERING • SURVEYING • ARCHITECTURE  
 102 ALBEMARLE AVENUE  
 ROANOKE, VIRGINIA 24011  
 (540) 345-0675  
 FAX (540) 342-4456

CITY OF ROANOKE  
 REDEVELOPMENT & HOUSING AUTHORITY  
 LANSDOWNE PARK  
 SANITARY SEWER REPLACEMENT  
 CITY OF ROANOKE, VIRGINIA

NO.	DATE	DESCRIPTION	DRM	BY
1	11/25/98	RECORD DRAWING		

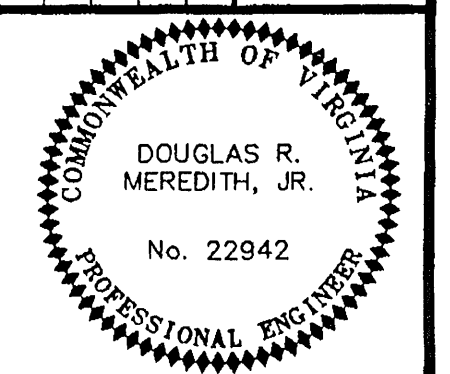

Designed By	DME/MJG
Drawn By	DME
Checked By	RCW
Approved By	DRM
Submitted By	DRM
Drawing	1136PRL.DWG
Date:	5/2/97
Scale	V: 1" = 10' H: 1" = 30'
Commission No.	1136
Sheet	10 of 13

RECORD DRAWING

WWW.ID# 6Q8LD3