


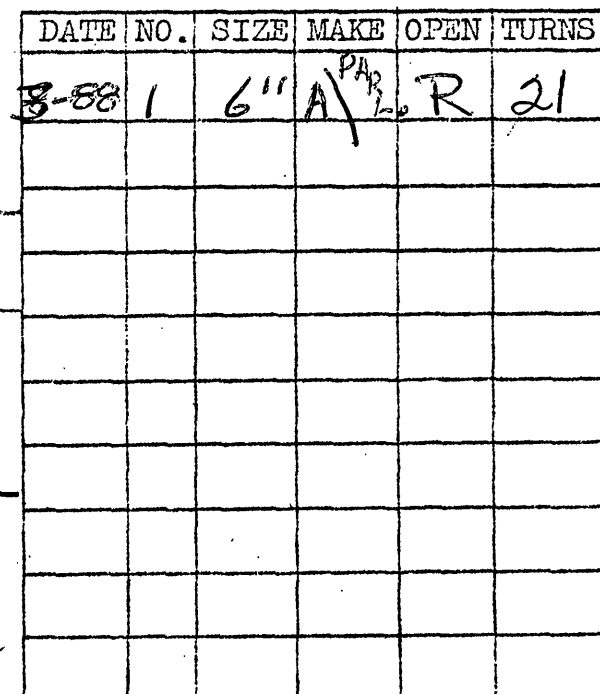

CITY OF ROANOKE - WATER DEPT.	
VALVE DIAGRAM	
2041 LEE AVE RD	
SW -	
Sec. Map	
Date	Page No.