


PROJECT LOCATION MAP

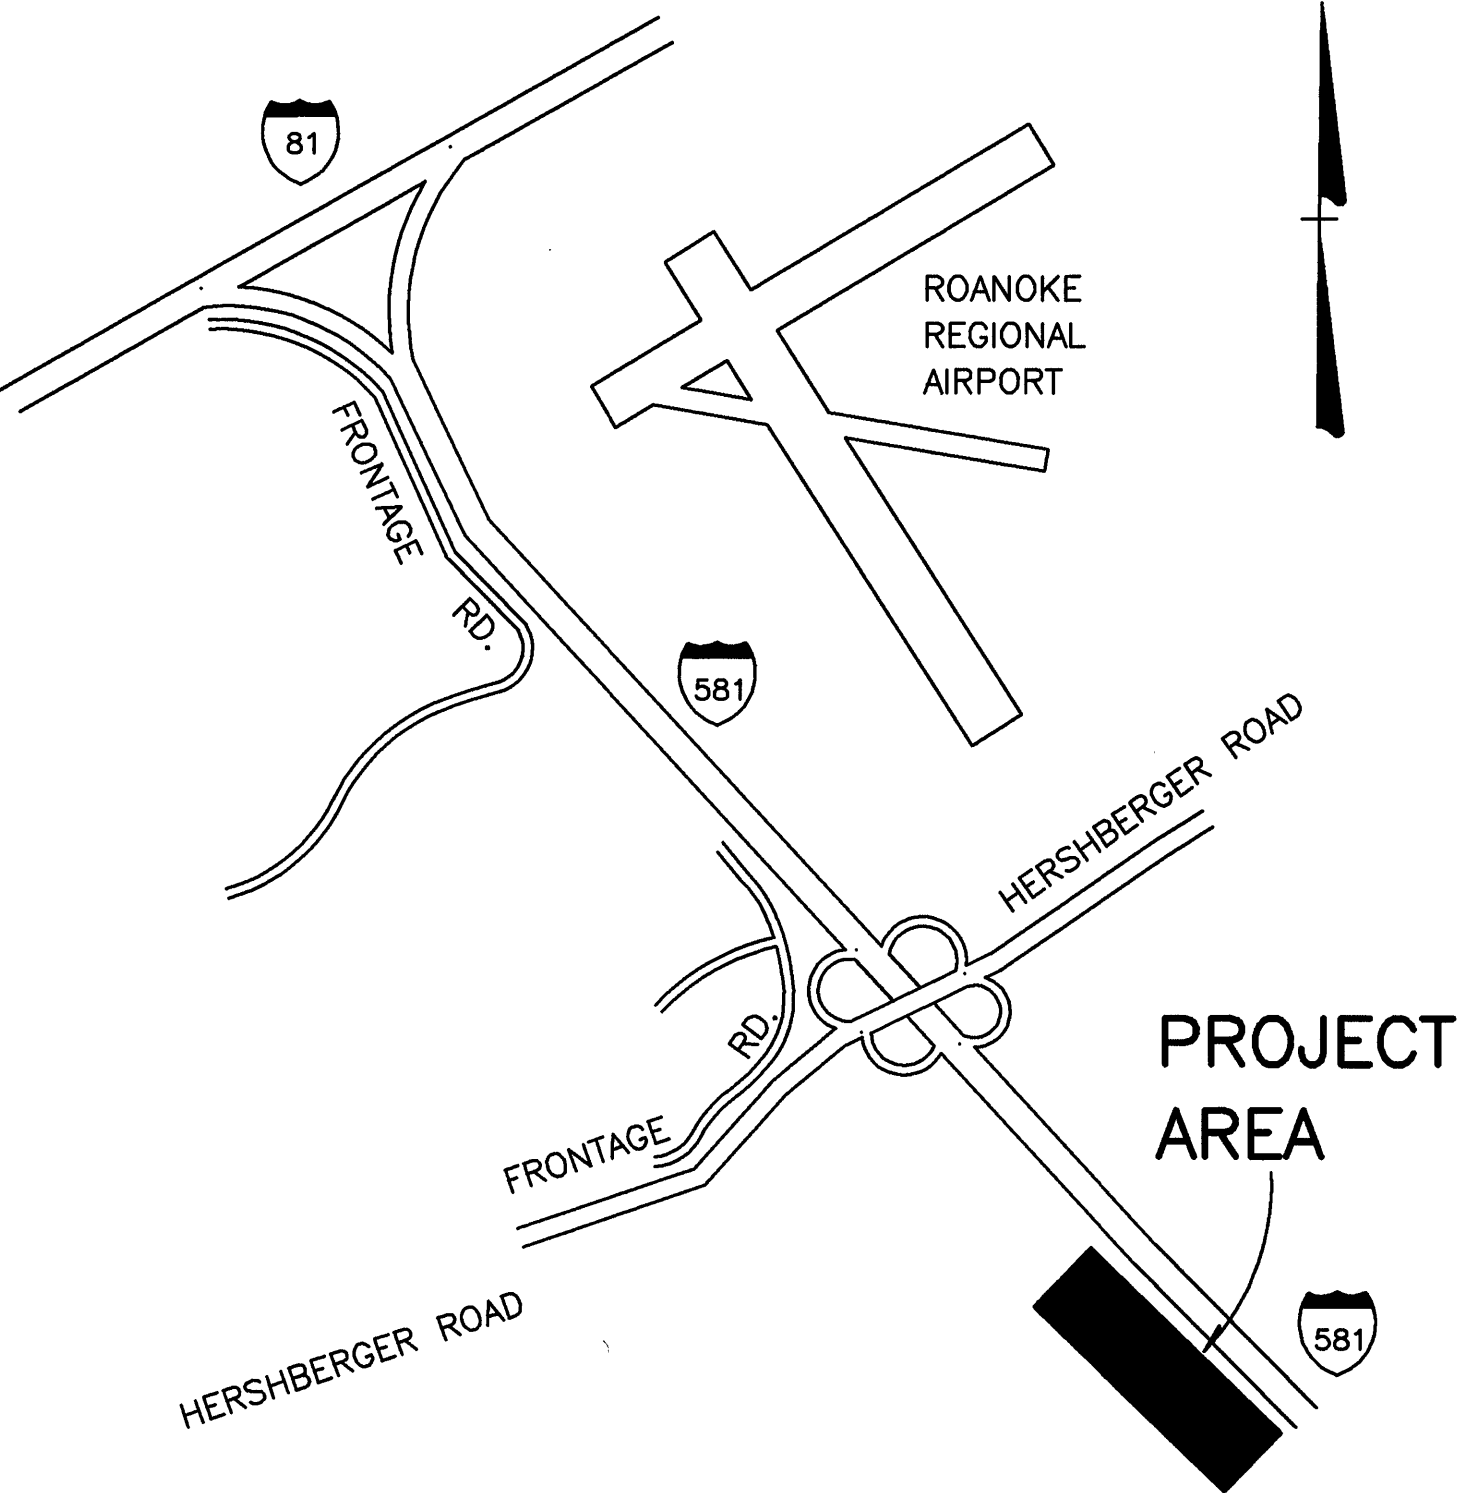

OFFICE OF CITY ENGINEER
ROOM 350
MUNICIPAL BUILDING
215 CHURCH AVENUE, S.W.
ROANOKE, VIRGINIA 24011

INDEX OF SHEETS


- 1 TITLE
- 2 SUMMARY OF QUANTITIES
- 3 GENERAL ABBREVIATIONS & LEGEND
- 4 SHEET INDEX & GENERAL NOTES
- 5 PLAN & PROFILE
- 6 PLAN & PROFILE
- 7 PLAN & PROFILE
- 8 PLAN & PROFILE
- 9 PLAN & PROFILE
- 10 PROFILE

CONSULTING ENGINEERS



CONSULTING ENGINEERS
SURVEYORS
701 FIRST STREET
ROANOKE, VIRGINIA

COMMISSION NUMBER: 1245H

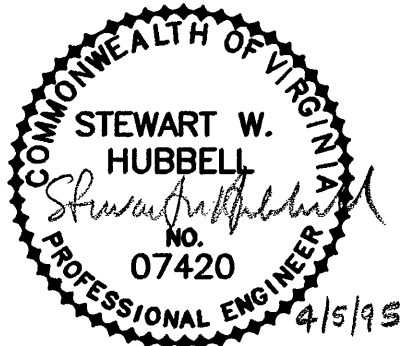

PROJECT NAME

LICK RUN SEWER REPLACEMENT
PROJECT LR-5
CITY OF ROANOKE, VIRGINIA

PROJECT NUMBER: 6245H

REVISION BY	DESCRIPTION:	DATE
REVISION BY	DESCRIPTION:	DATE
REVISION BY	DESCRIPTION:	DATE
REVISION BY	DESCRIPTION:	DATE

APPROVED FOR CONSTRUCTION

Charles M. Huffine
ROANOKE CITY ENGINEER

4/5/95
DATE

William F. Clark
DIRECTOR OF PUBLIC WORKS

4/5/95
DATE

Pat B. Lee
DIRECTOR OF PUBLIC UTILITIES AND OPERATIONS

4/5/95
DATE

DATE

DATE

ADVERTISED DATE: _____

SET NUMBER: _____

SHEET NUMBER: 1 OF 10

RECORD DRAWINGS
9-29-95