


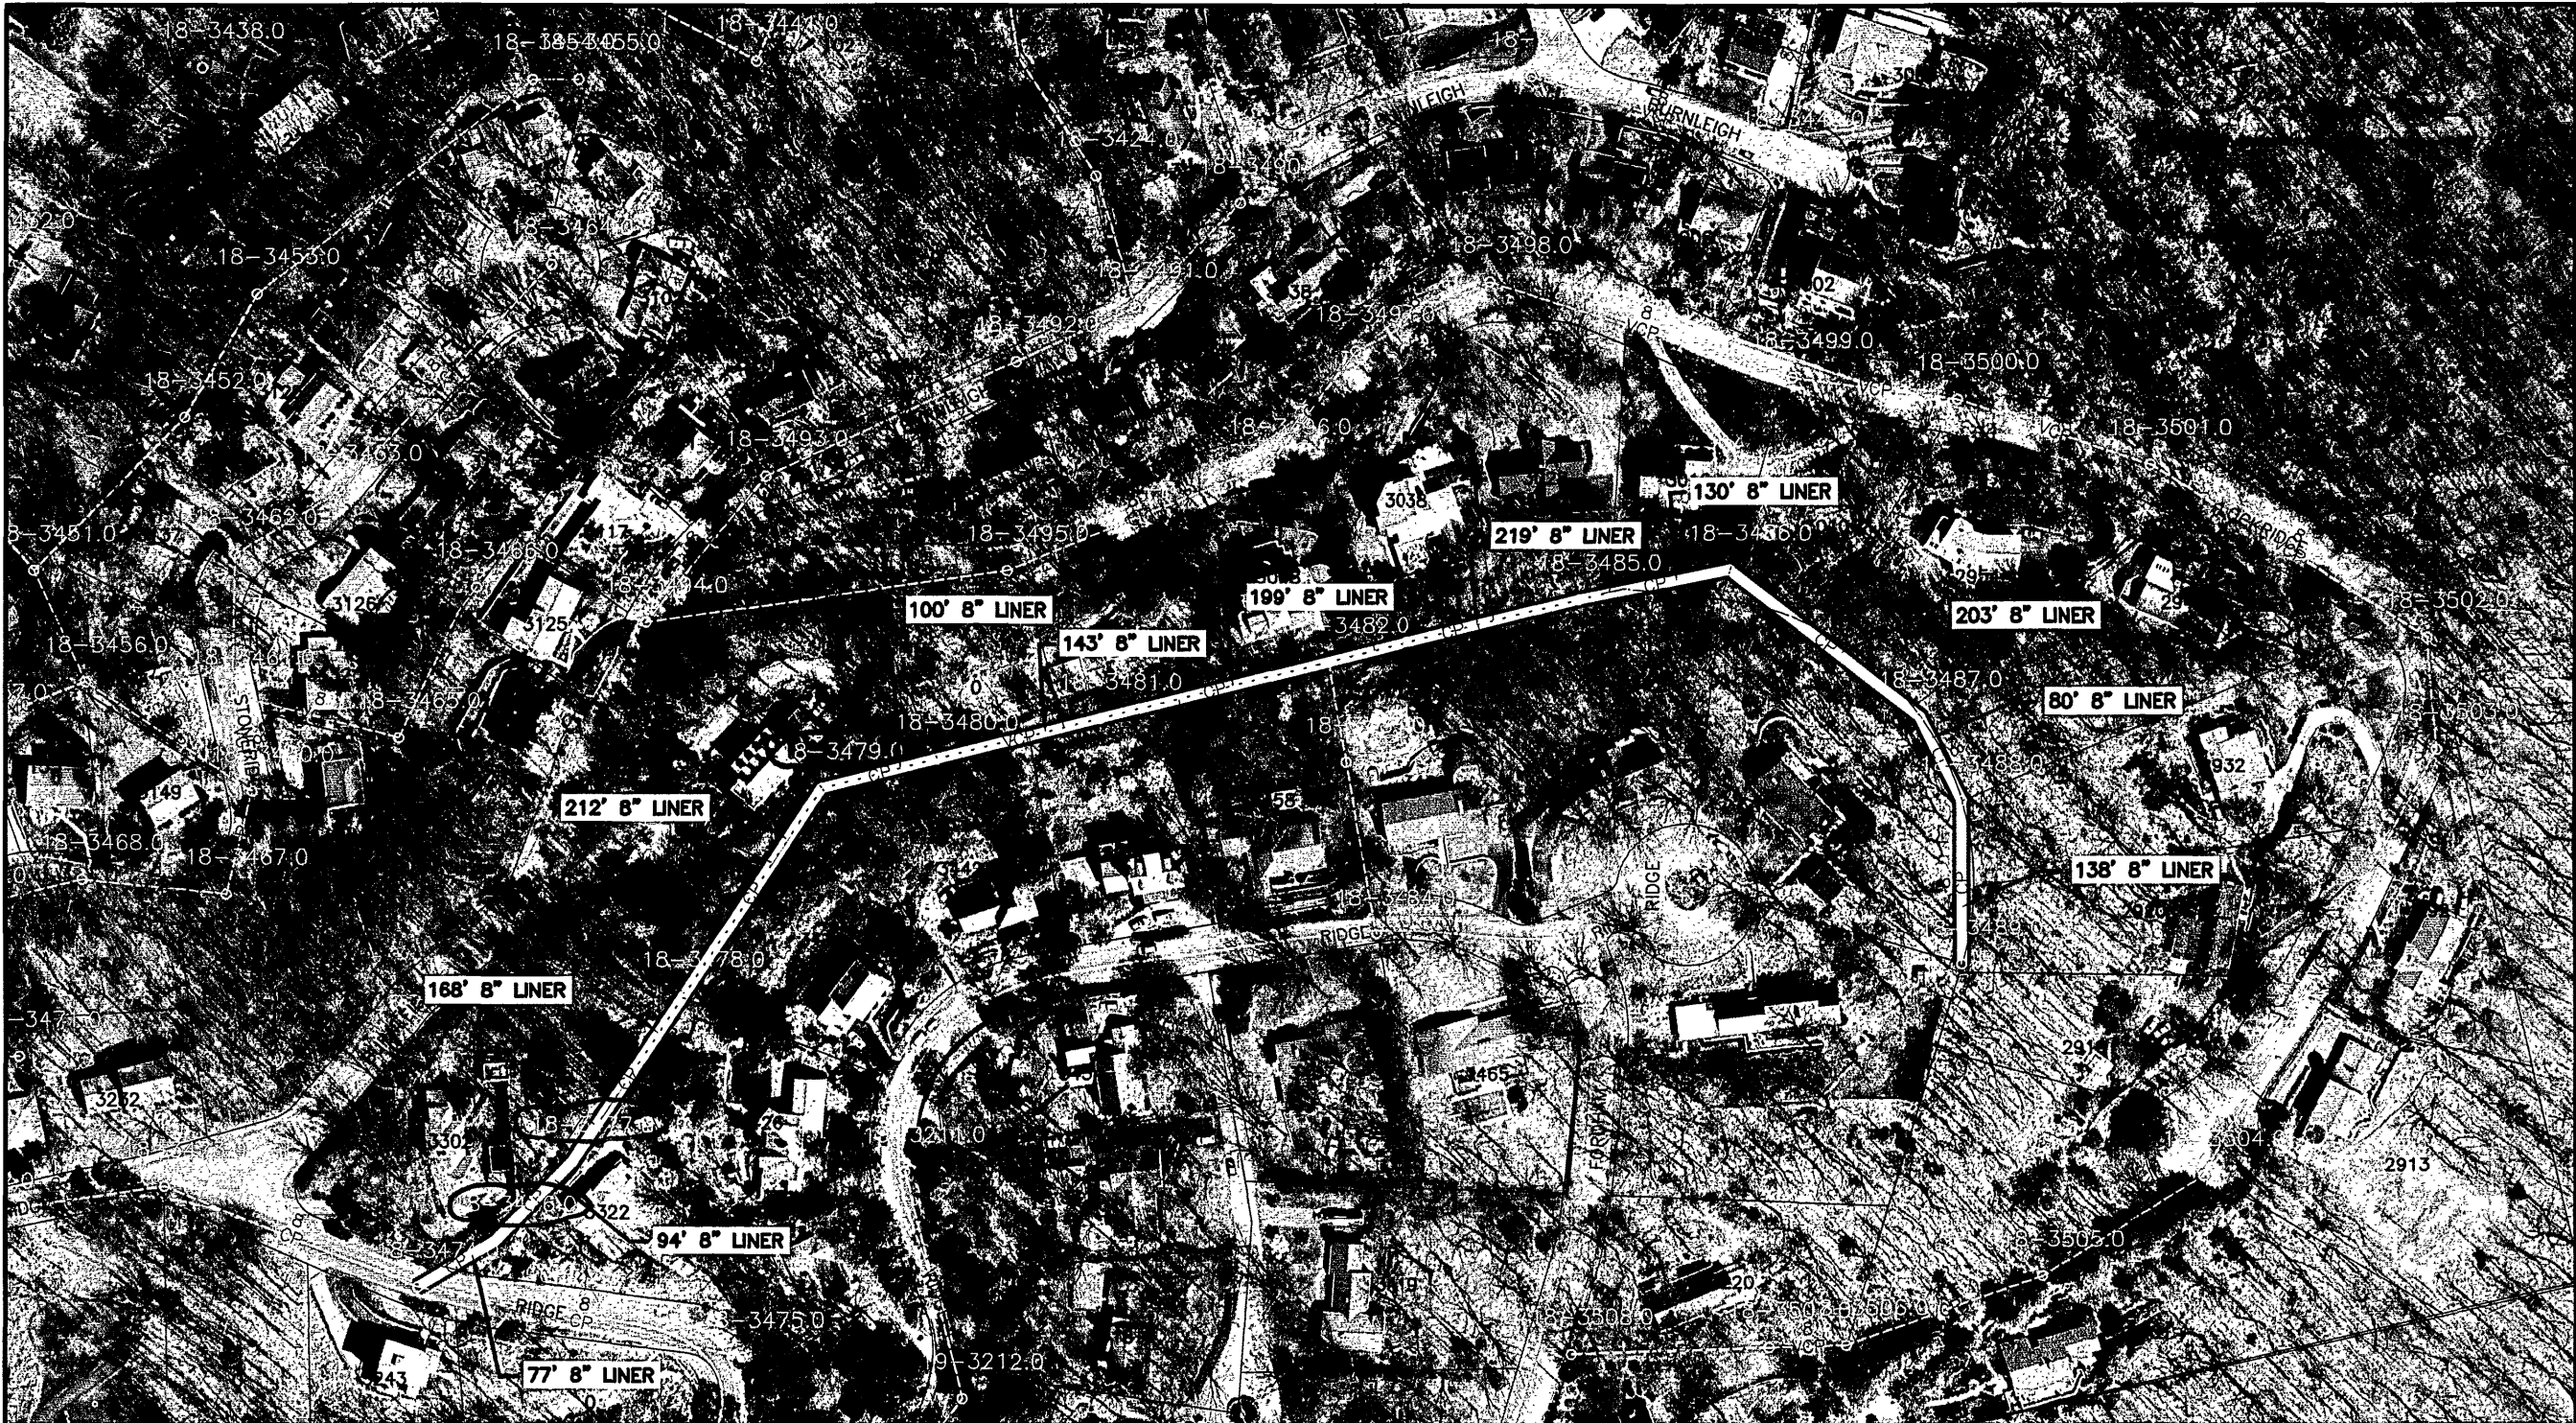


Sewer Lining:

MH 18-3479.0 → 18-3474.02 - 10" Fold & Form PVC Alloy (Ultraliner) [1746 LF]

MH Rehab:

- 18-3479.0 - New Water-tight Frame & Cover, Cementitious Liner (1" Qualex)
- 18-3477.0 - New Water-tight Frame & Cover
- 18-3476.0 - New Water-tight Frame & Cover, Cementitious Liner (1" Qualex)

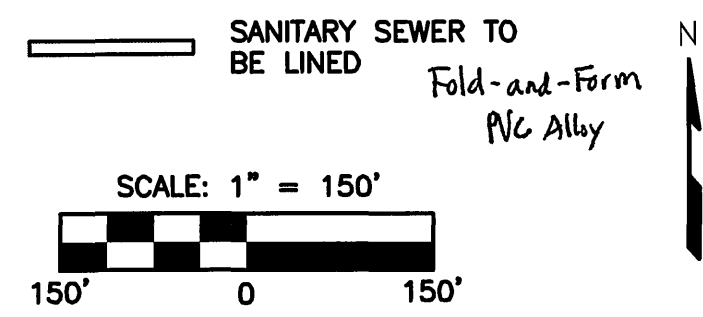

 Wiley Wilson Constant Progress	
127 Nationwide Drive Lynchburg, Virginia 24502-4272	
WWWA LINER PROJECTS 2009	
PROJECT	TITLE
	AS-BUILT LOCKRIDGE ROAD EJF 10/26/10
COMM. NO. 209050.00	
DRAWN BSH	CHECKED WM
DWG. REFERENCE NO. LOCKRIDGE ROAD.DWG	
SHEET TITLE	
DATE 12-09	REV.