



AS-BUILT DRAWING NOTE:
AS-BUILT DRAWING FOR WATERLINE IMPROVEMENTS ARE FOR AS-BUILT PURPOSES ONLY. NO IMPROVEMENTS OTHER THAN WATER LINE STRUCTURES WERE AS-BUILT OR INDICATED AS SUCH ON THE SUBJECT PLAN SET. UNDERGROUND PIPING WAS NOT LOCATED. LOCATION SHOWN IS APPROXIMATE BASED ON SURFACE FEATURES AND INFORMATION PROVIDED BY CONTRACTOR.

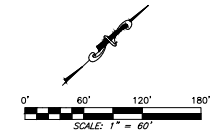

BALZER & ASSOCIATES, INC.
PLANNERS / ARCHITECTS
ENGINEERS / SURVEYORS
Roanoke / Richmond
New River Valley / Staunton
Harrisonburg / Lynchburg
www.balzer.cc
1208 Corporate Circle
Roanoke, VA 24018
540.772.5550

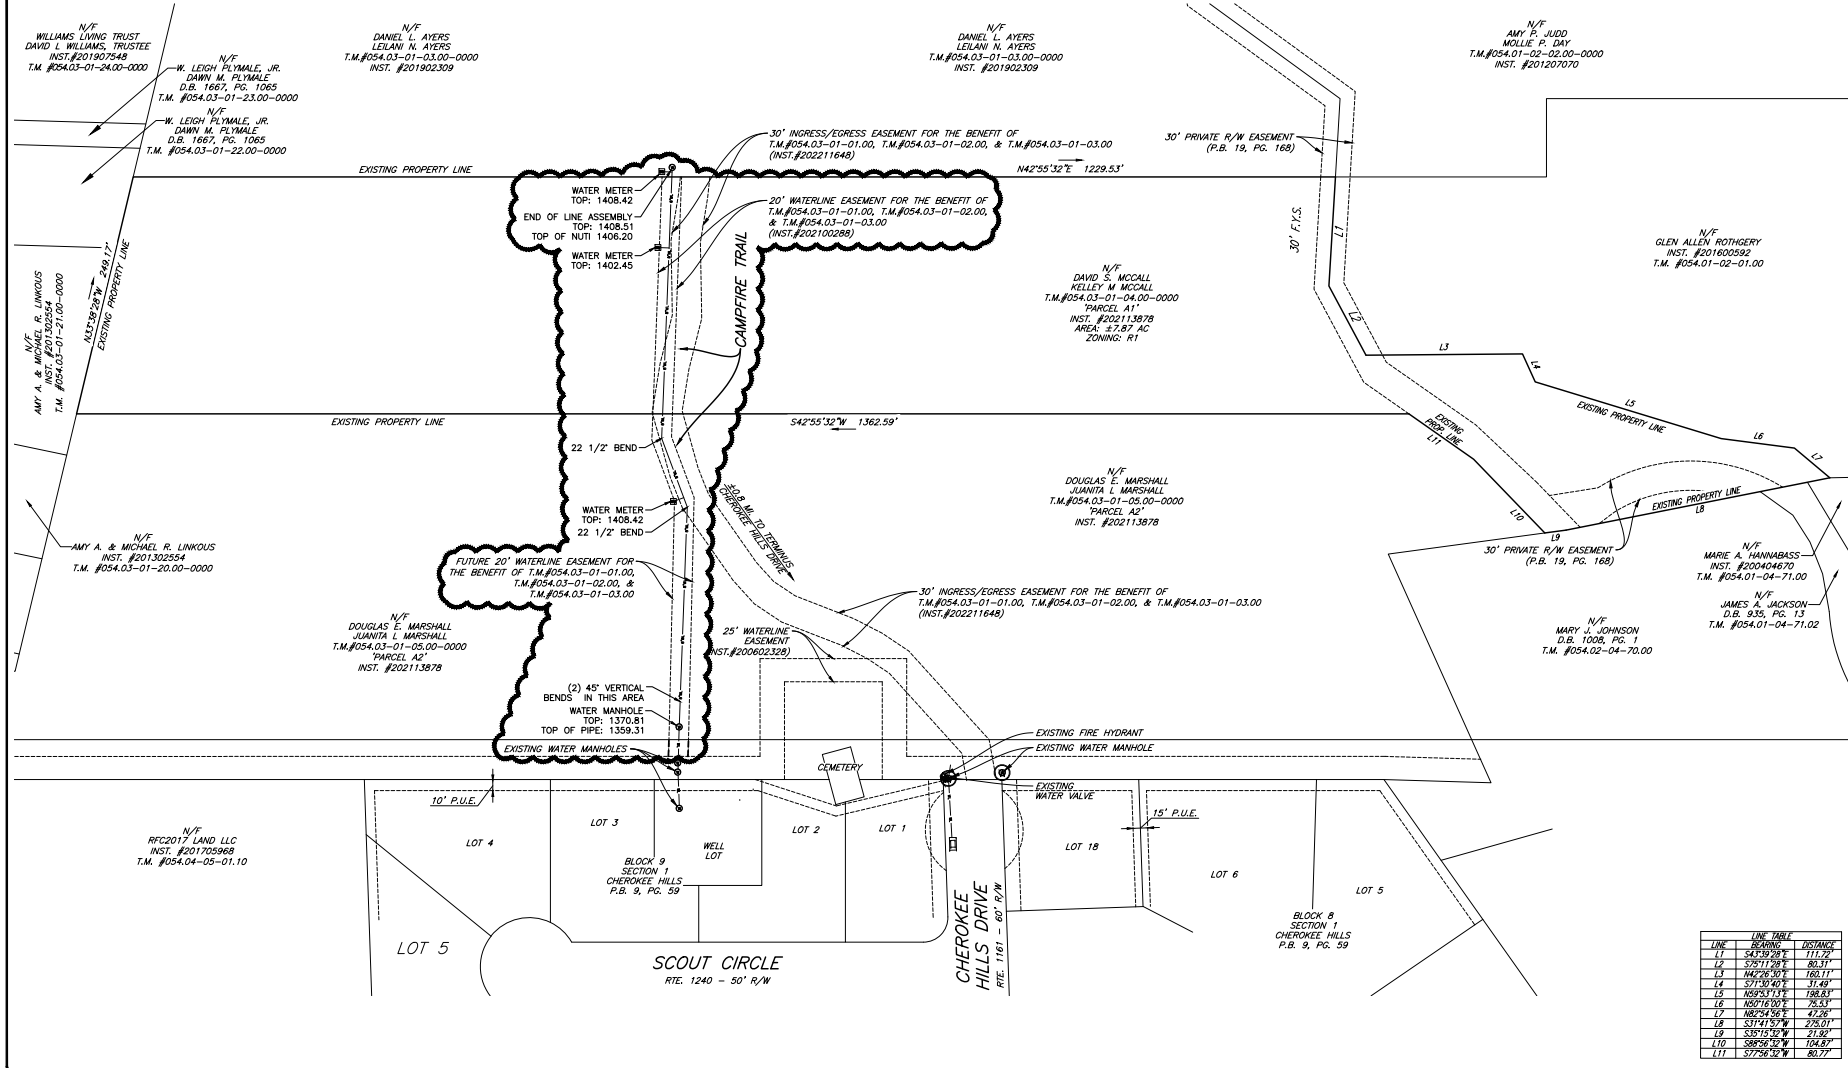

LINE	BEARING	DISTANCE
11	S43°59'00"E	111.24
12	S75°11'30"E	80.17
13	N42°25'32"E	1229.53
14	S71°30'00"E	31.49
15	N05°31'13"E	186.83
16	N05°10'00"E	2.53
17	N05°24'56"E	47.26
18	S31°41'55"W	216.91
19	S35°15'10"W	104.87
110	S88°56'10"W	88.77
111	S77°58'32"W	88.77

MCCALL RESIDENCE ESC PLAN
SITUATE CHEROKEE HILLS DRIVE
WWW.WATERLINE-AS-BUILT

DRAWN BY: EJP
DESIGNED BY: EJP
CHECKED BY: DSH
DATE: 01/30/2023
SCALE: 1" = 60'
REVISIONS:

EX-A
PROJECT NO. 05200308.00