

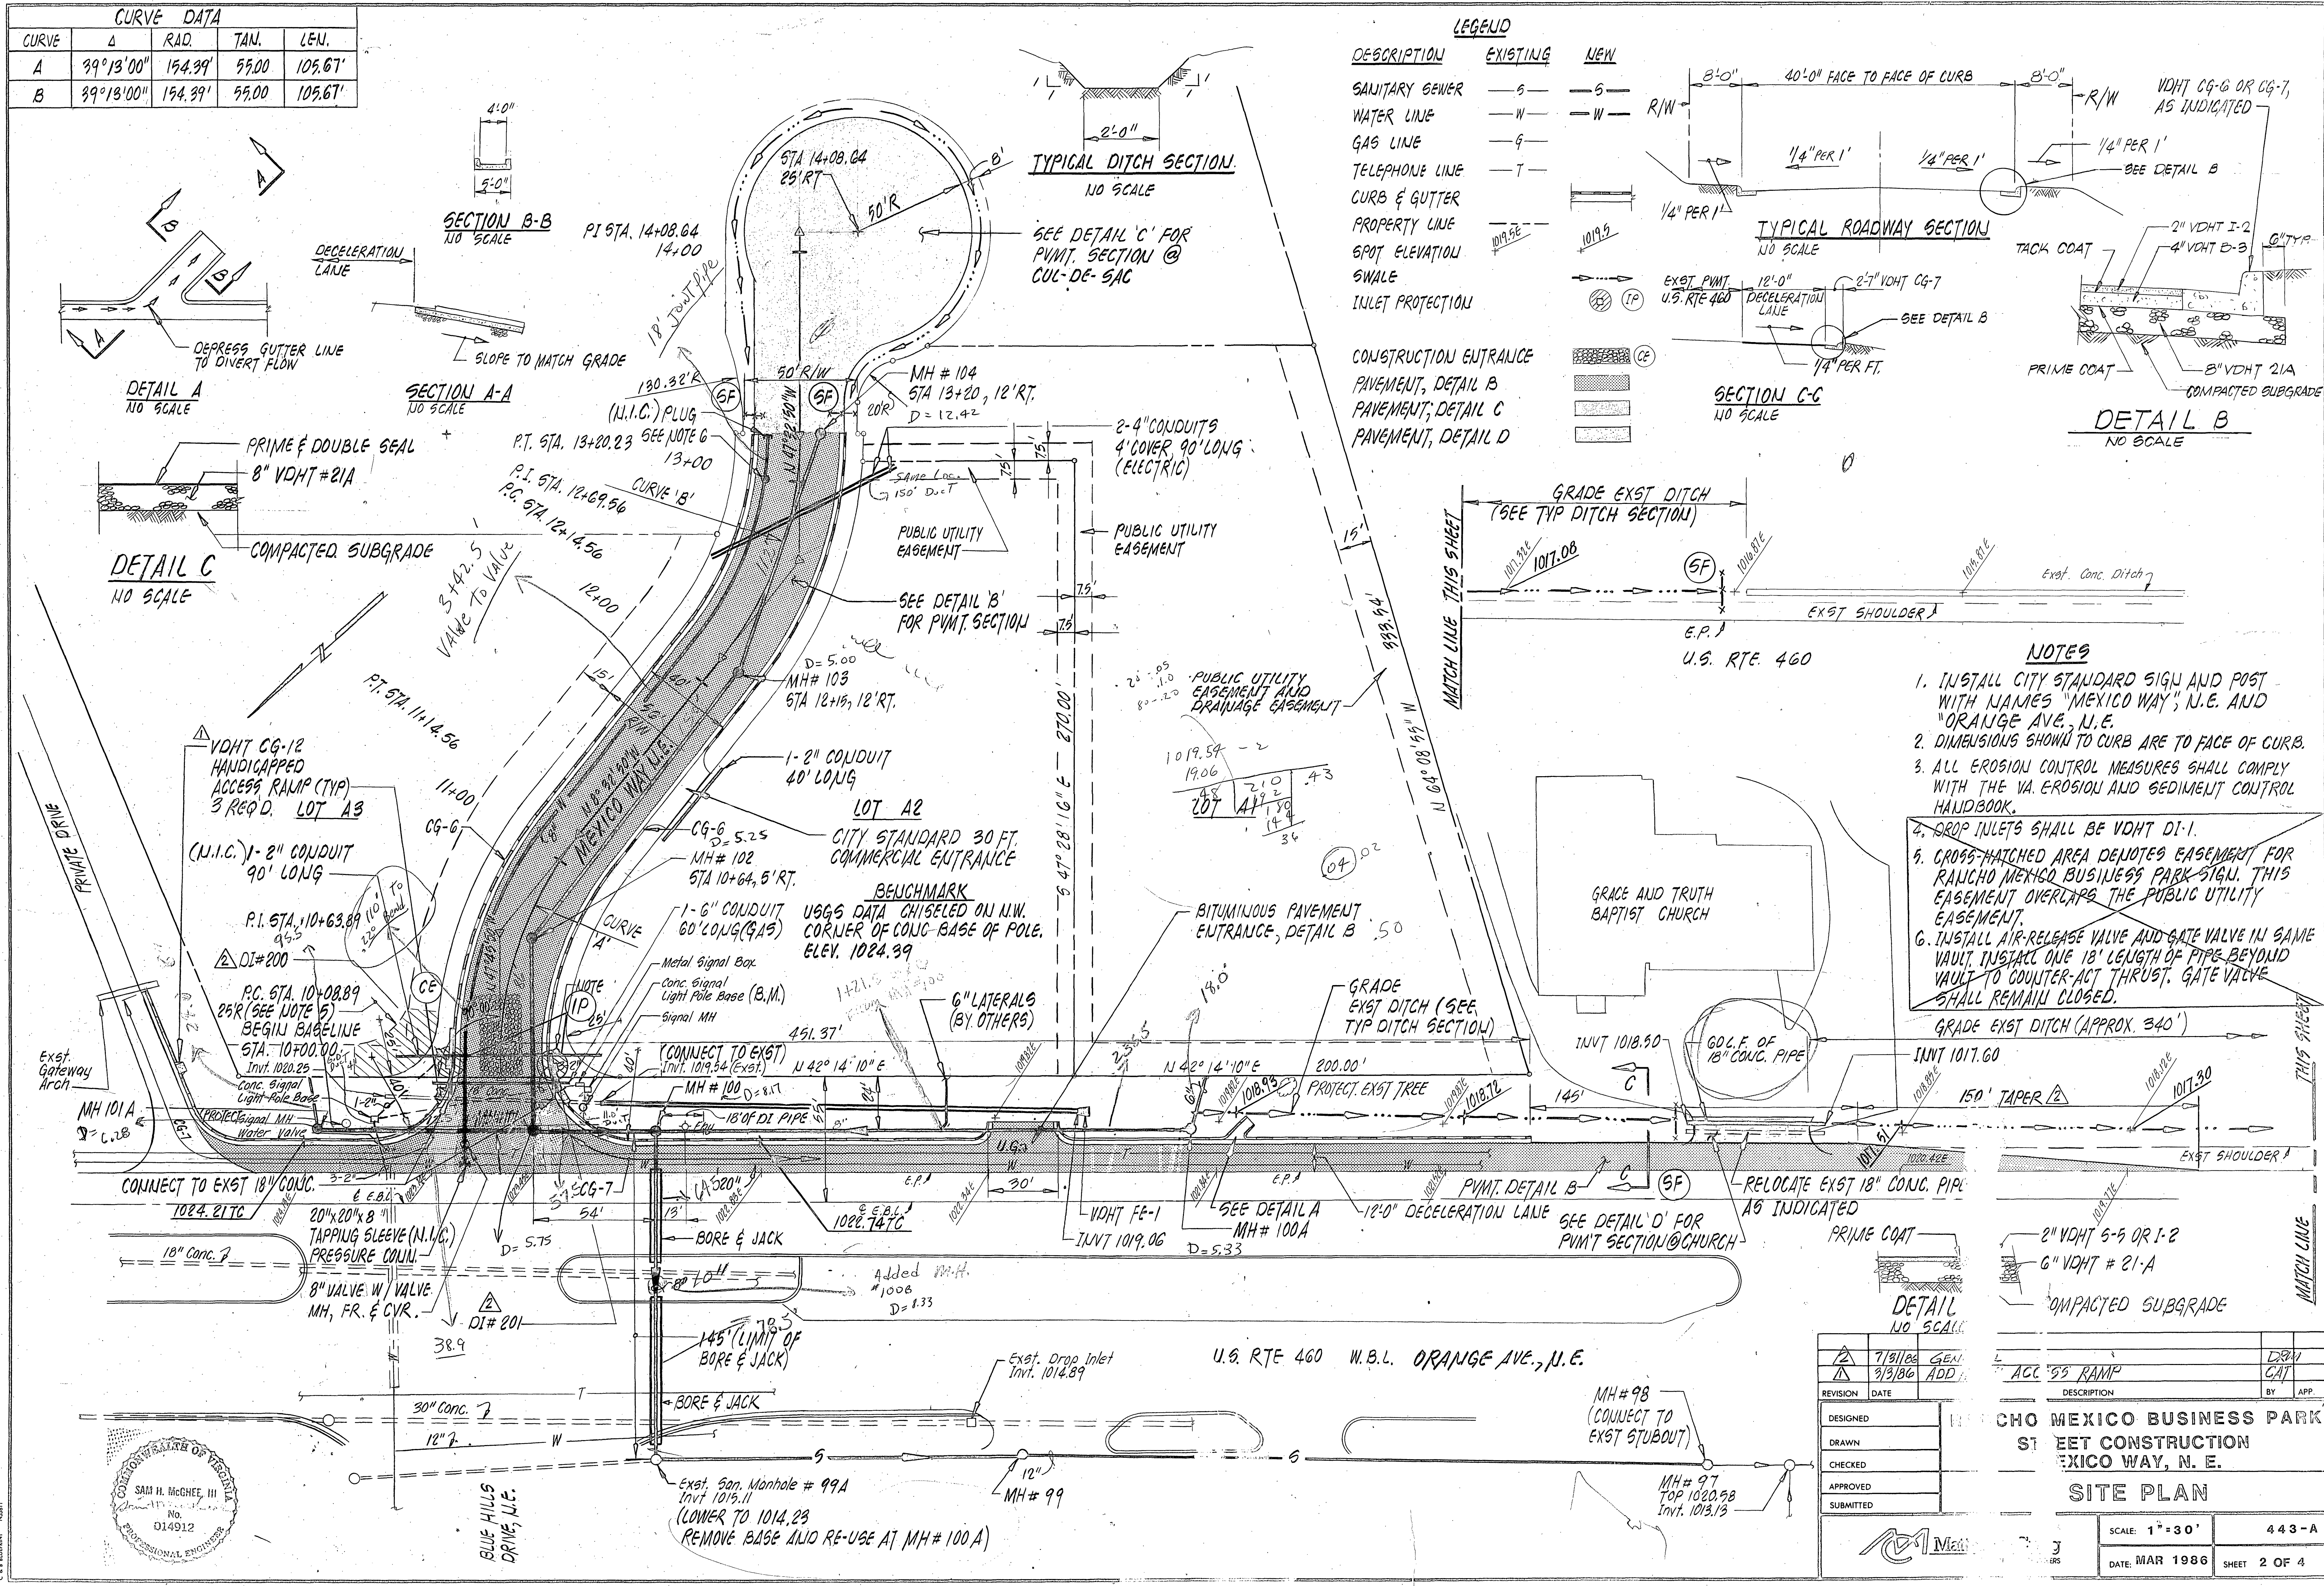


CURVE DATA				
CURVE	Δ	RAD.	TAN.	LEN.
A	39°13'00"	154.39'	55.00	105.67'
B	39°13'00"	154.39'	55.00	105.67'

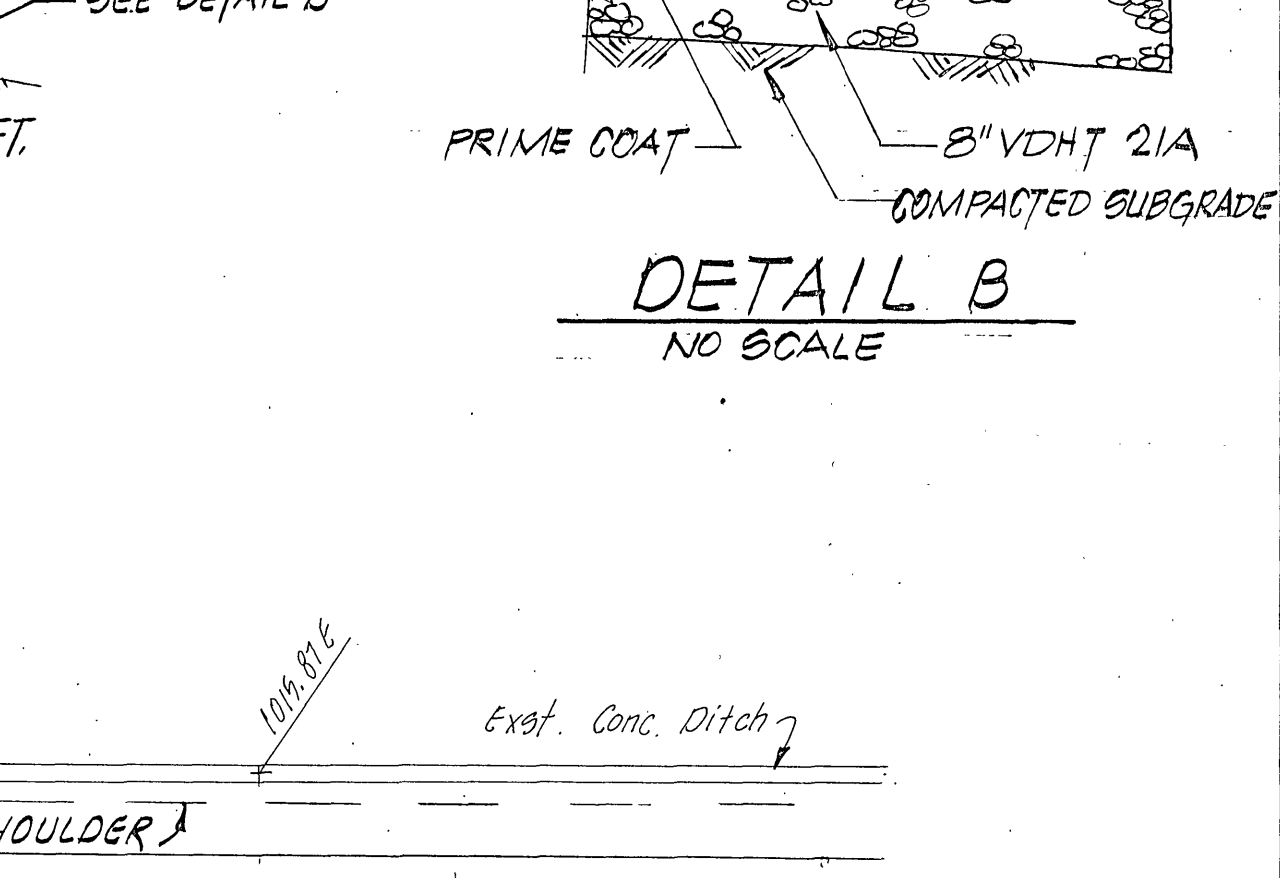

DESCRIPTION	EXISTING	NEW
SANITARY SEWER	—S—	—S—
WATER LINE	—W—	—W—
GAS LINE	—G—	—G—
TELEPHONE LINE	—T—	—T—
CURB & GUTTER	—C—	—C—
PROPERTY LINE	—P—	—P—
SPOT ELEVATION	—E—	—E—
SWALE	—SW—	—SW—
INLET PROTECTION	—IP—	—IP—

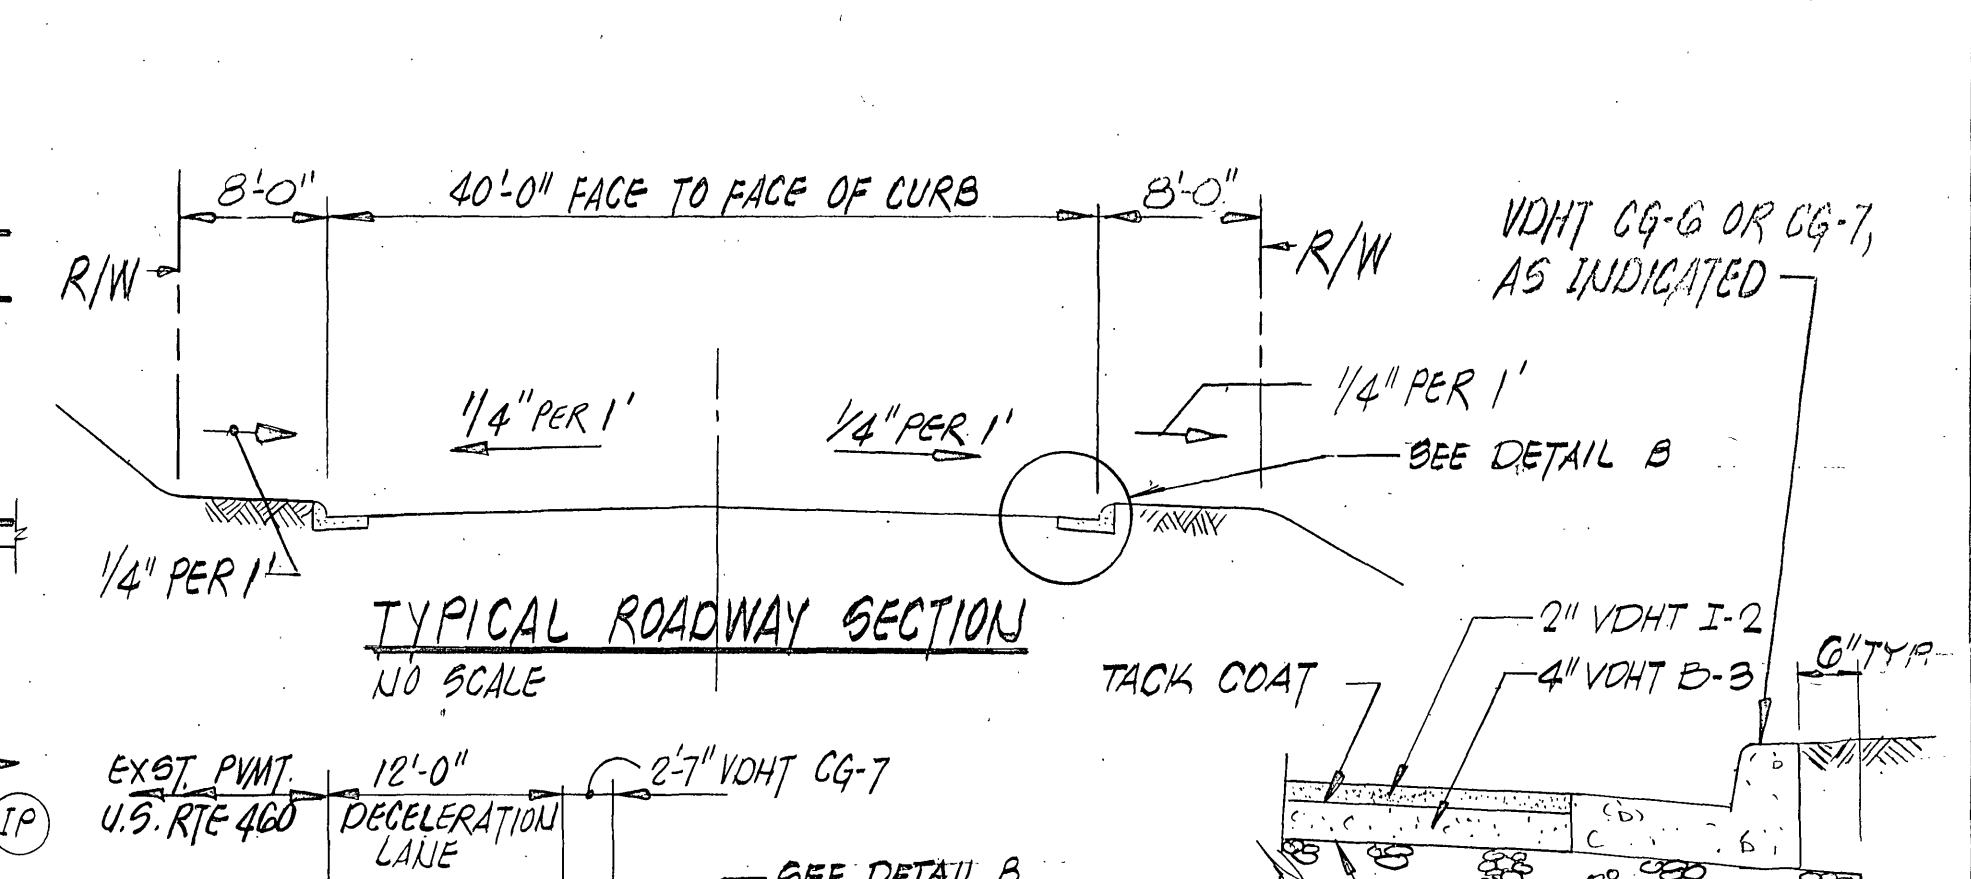

- NOTES**
1. INSTALL CITY STANDARD SIGN AND POST WITH NAMES "MEXICO WAY", N.E. AND "ORANGE AVE., N.E."
 2. DIMENSIONS SHOWN TO CURB ARE TO FACE OF CURB.
 3. ALL EROSION CONTROL MEASURES SHALL COMPLY WITH THE VA. EROSION AND SEDIMENT CONTROL HANDBOOK.
 4. DROP INLETS SHALL BE V.D.H.T. DI-1.
 5. CROSS-HATCHED AREA DENOTES EASEMENT FOR RANCHO MEXICO BUSINESS PARK STATION. THIS EASEMENT OVERLAPS THE PUBLIC UTILITY EASEMENT.
 6. INSTALL AIR-RELEASE VALVE AND GATE VALVE IN SAME VAULT. INSTALL ONE 18' LENGTH OF PIPE BEYOND VAULT TO COUNTER-ACT THRUST. GATE VALVE SHALL REMAIN CLOSED.

DESIGNED	7/31/86	GEN.	ADD.	DATE	7/31/86
DRAWN	3/3/86	ADD.			
CHECKED					
APPROVED					
SUBMITTED					

ACC.	SS RAMP	BY	APP.

CHO MEXICO BUSINESS PARK	STREET CONSTRUCTION	MEXICO WAY, N. E.
SITE PLAN		
SCALE: 1"=30'	443-A	
DATE, MAR 1986	SHEET 2 OF 4	