
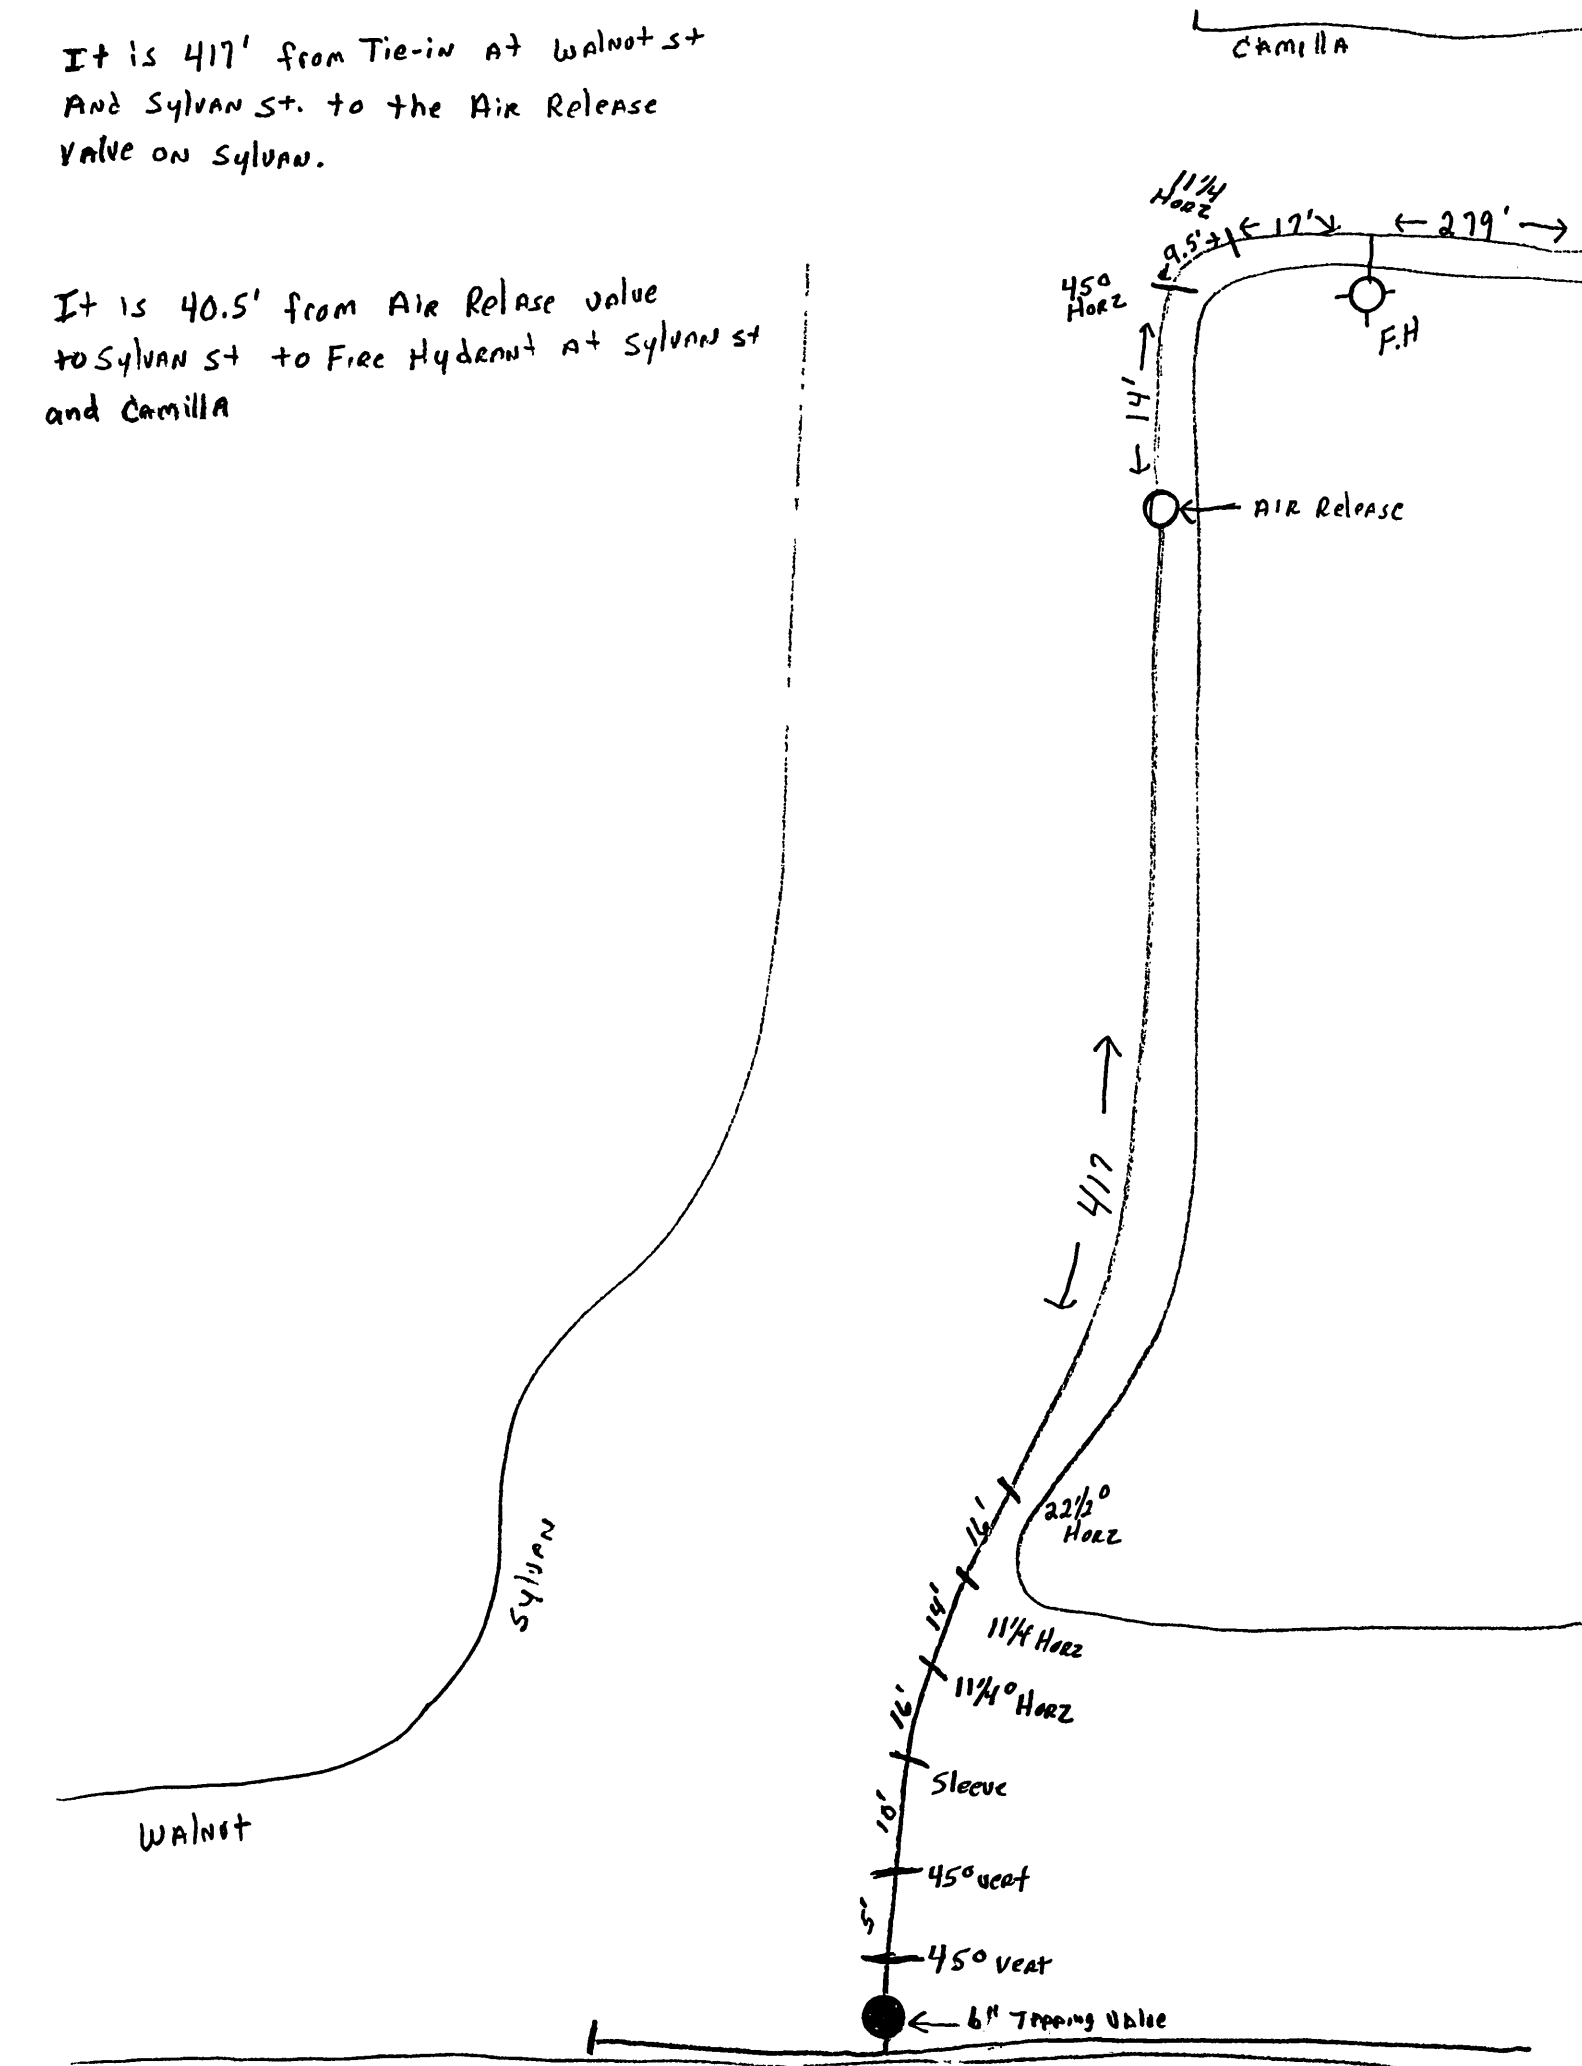
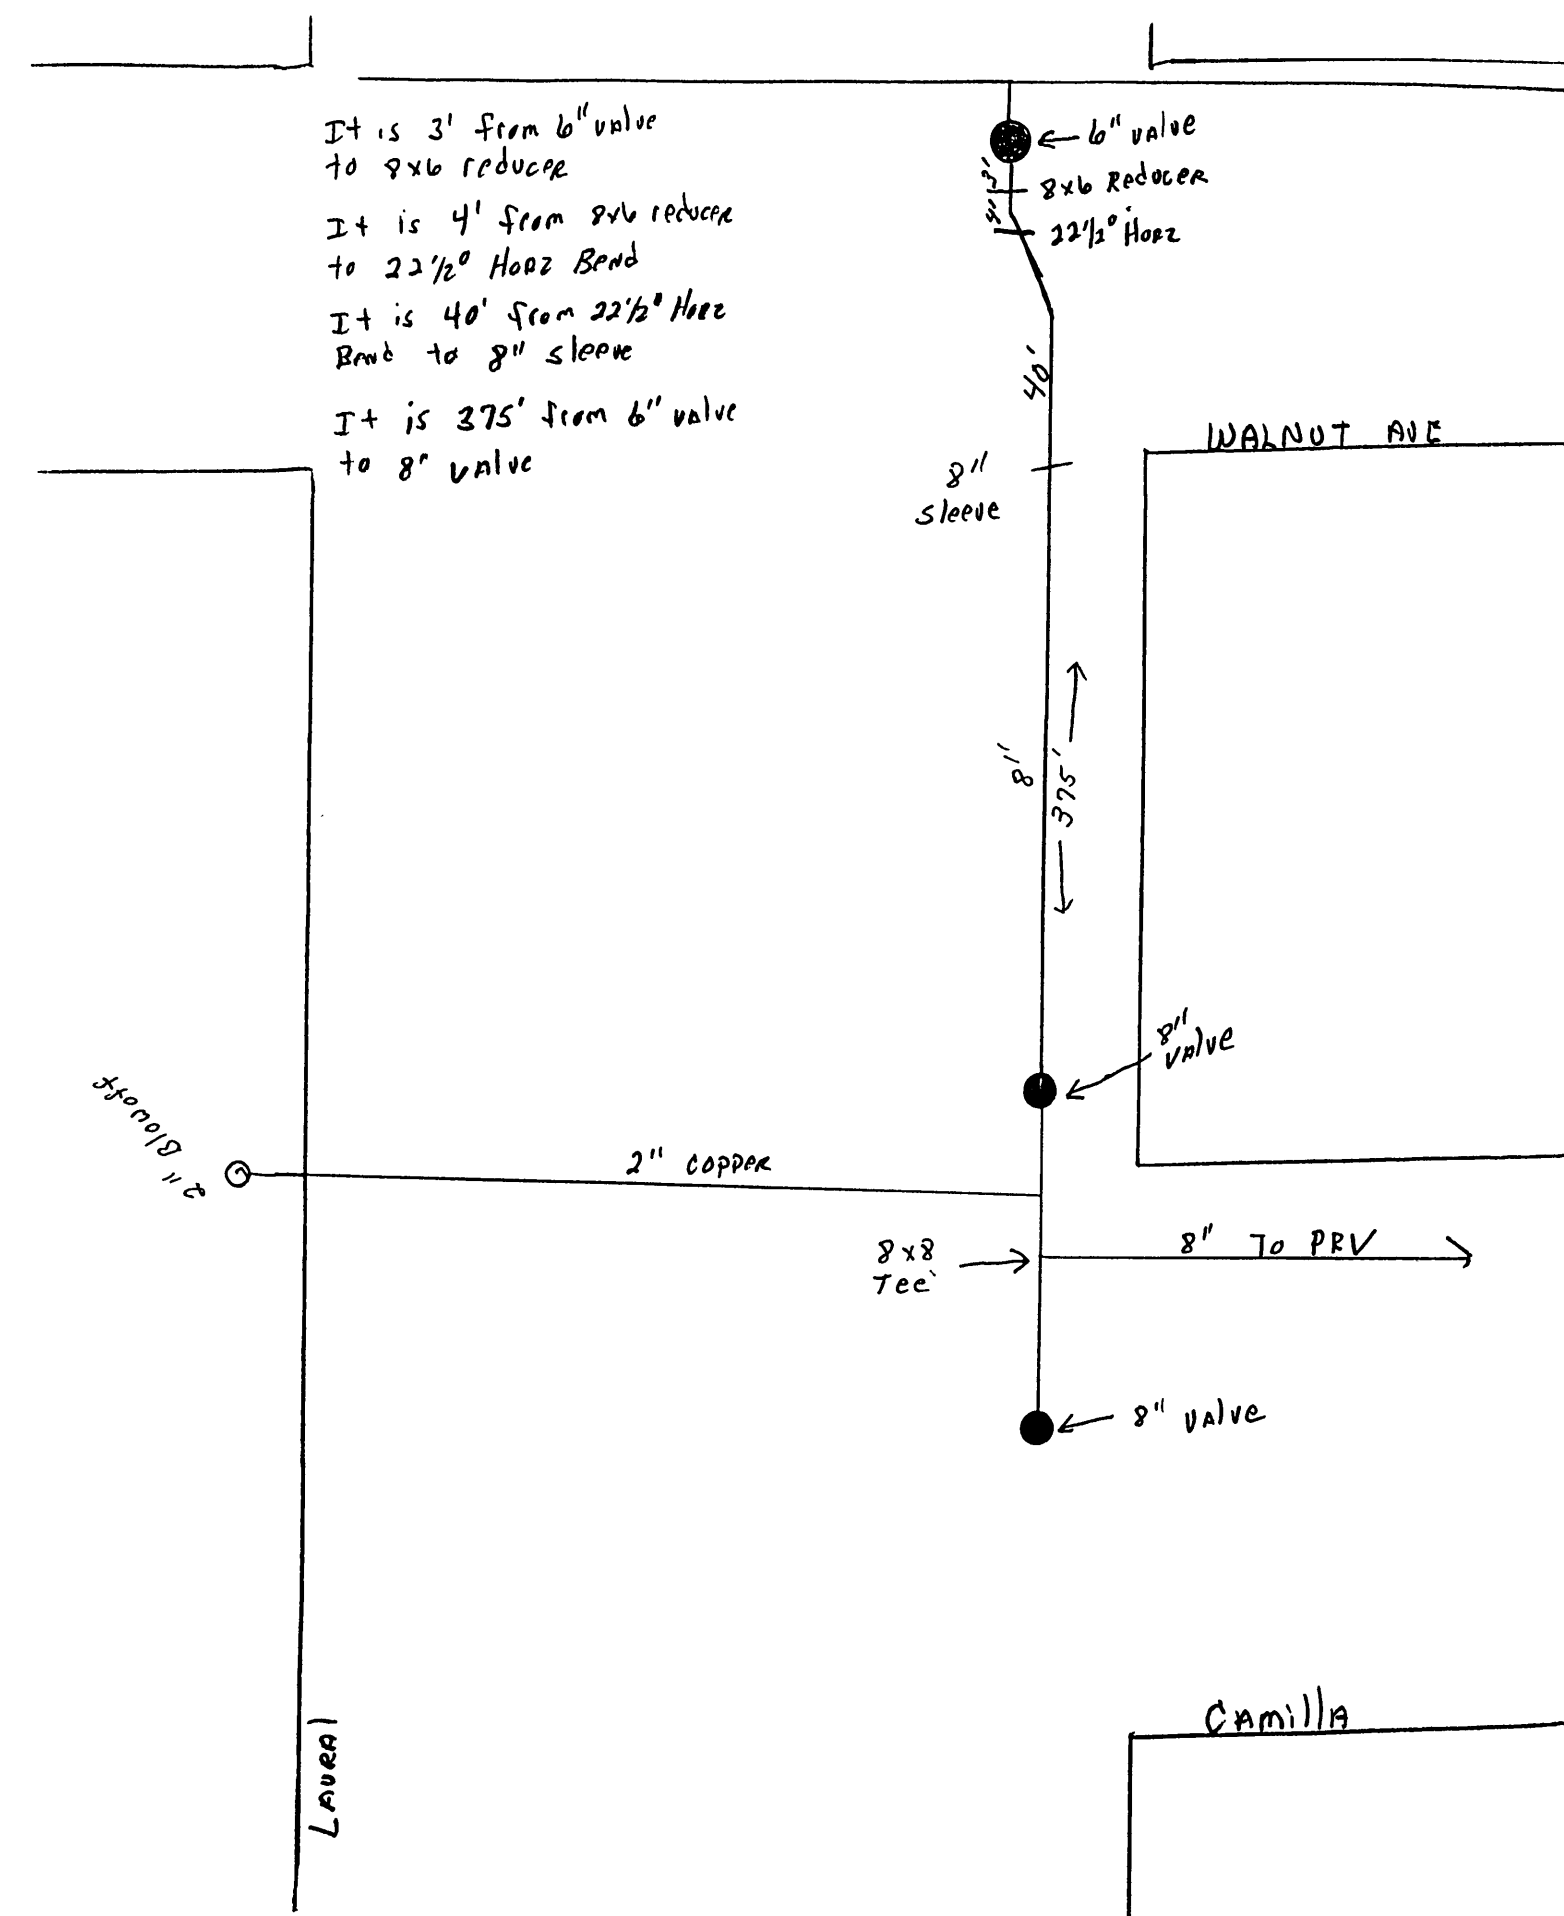
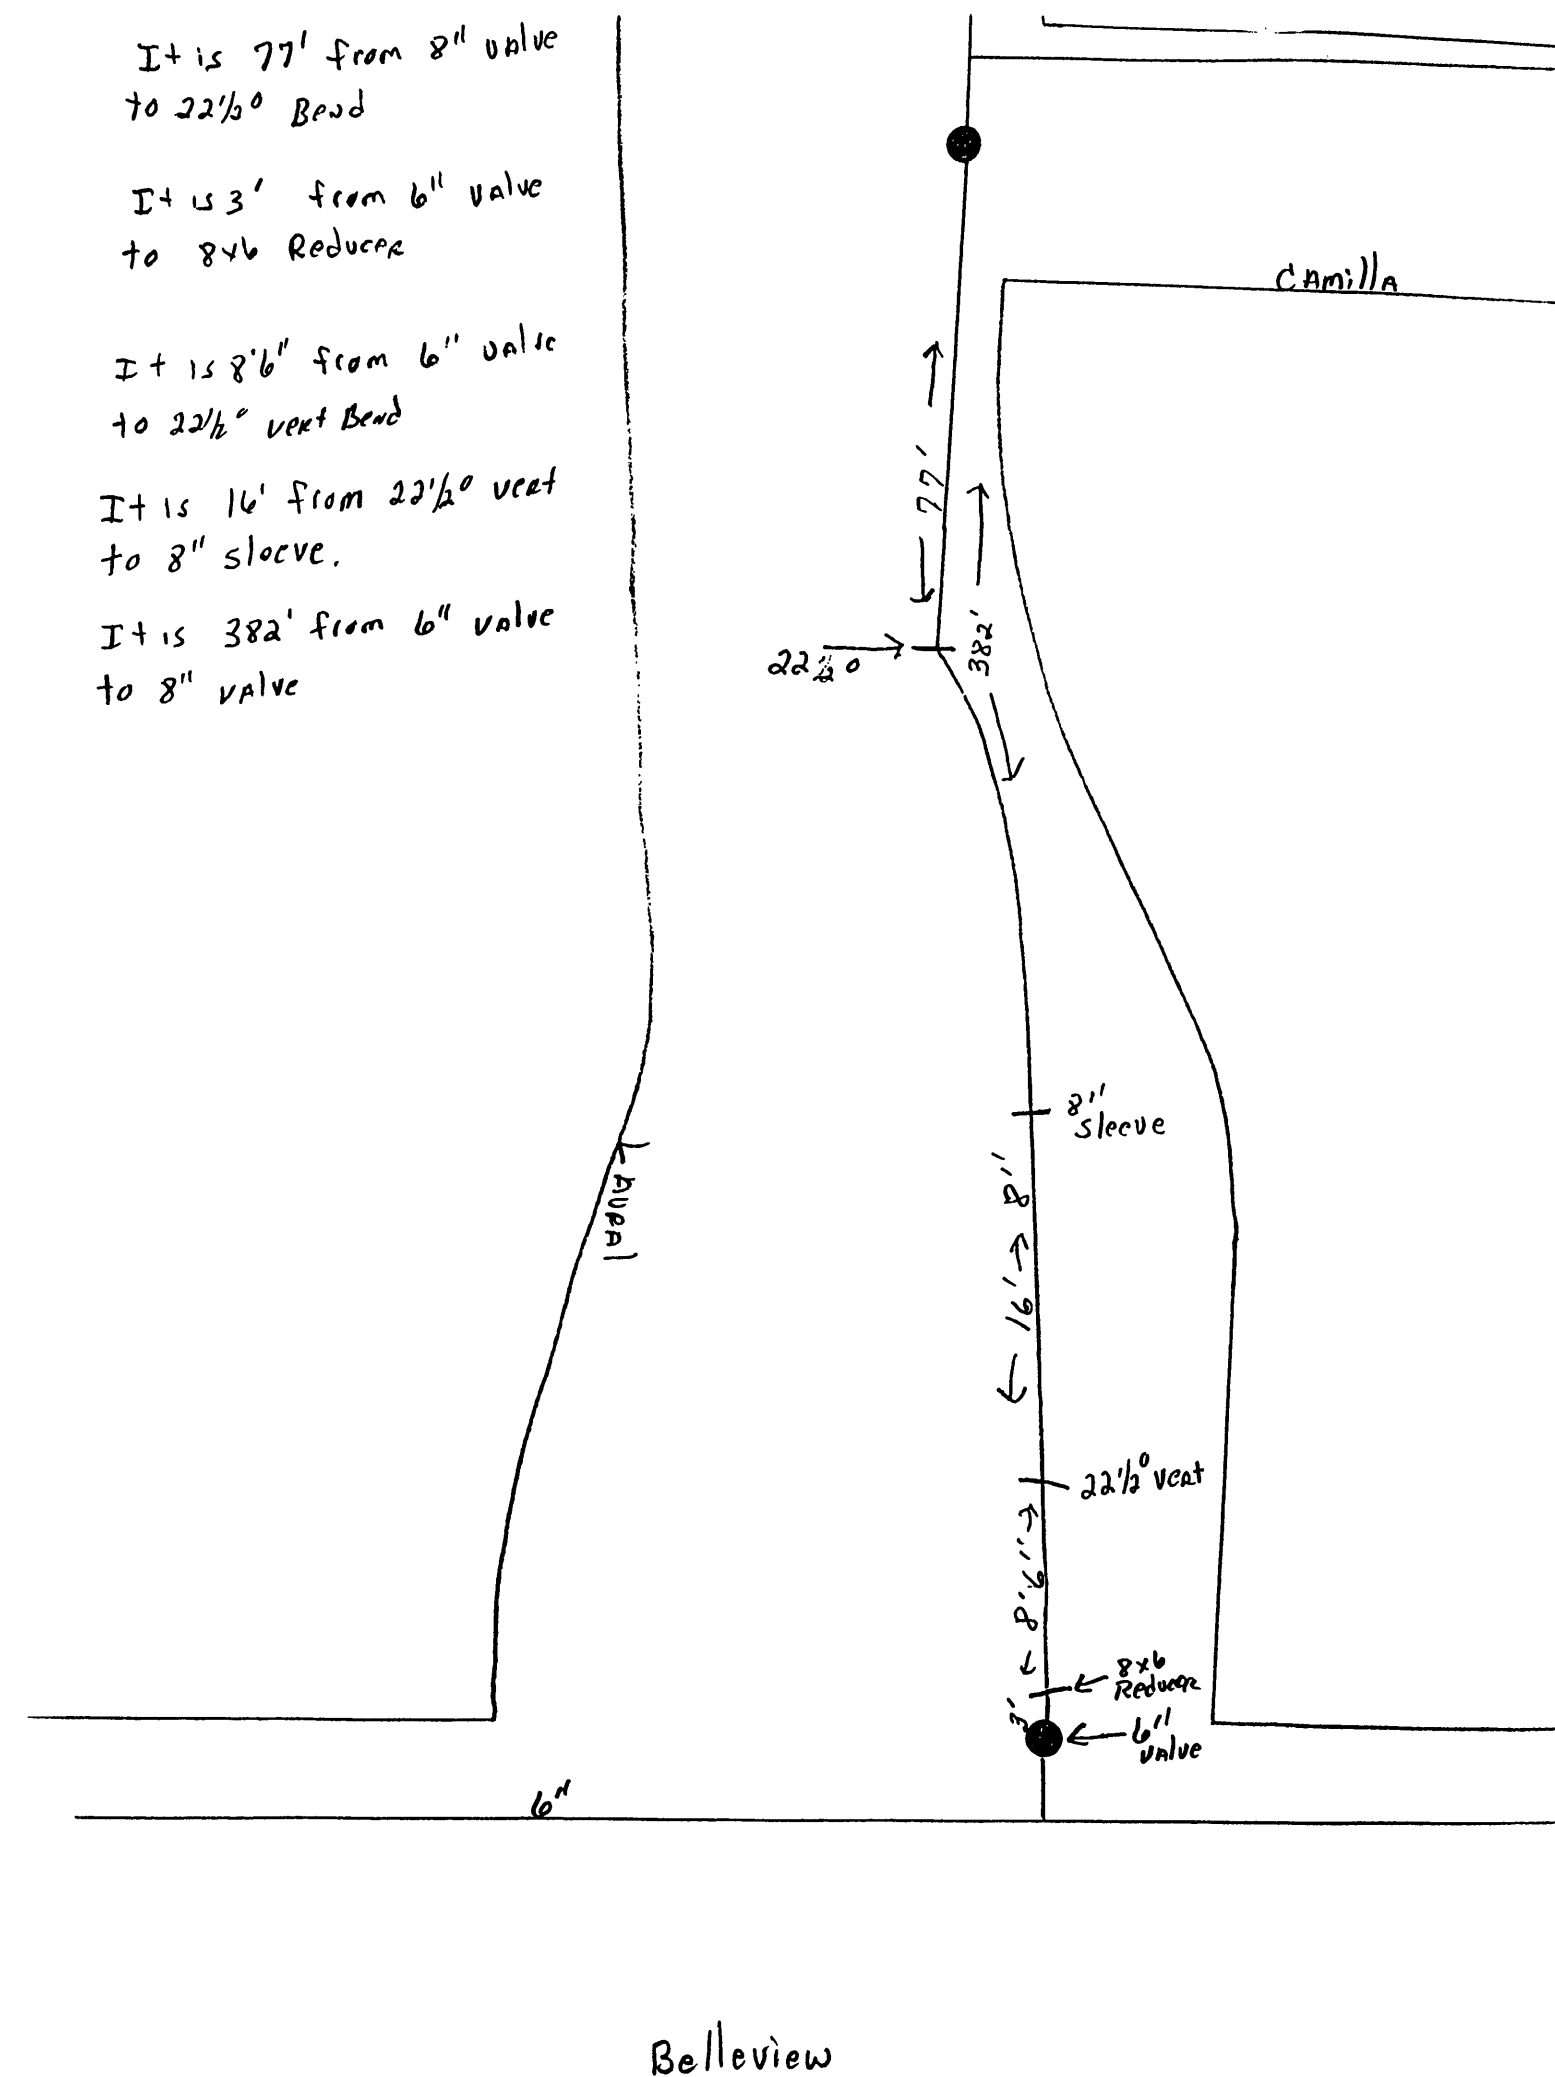
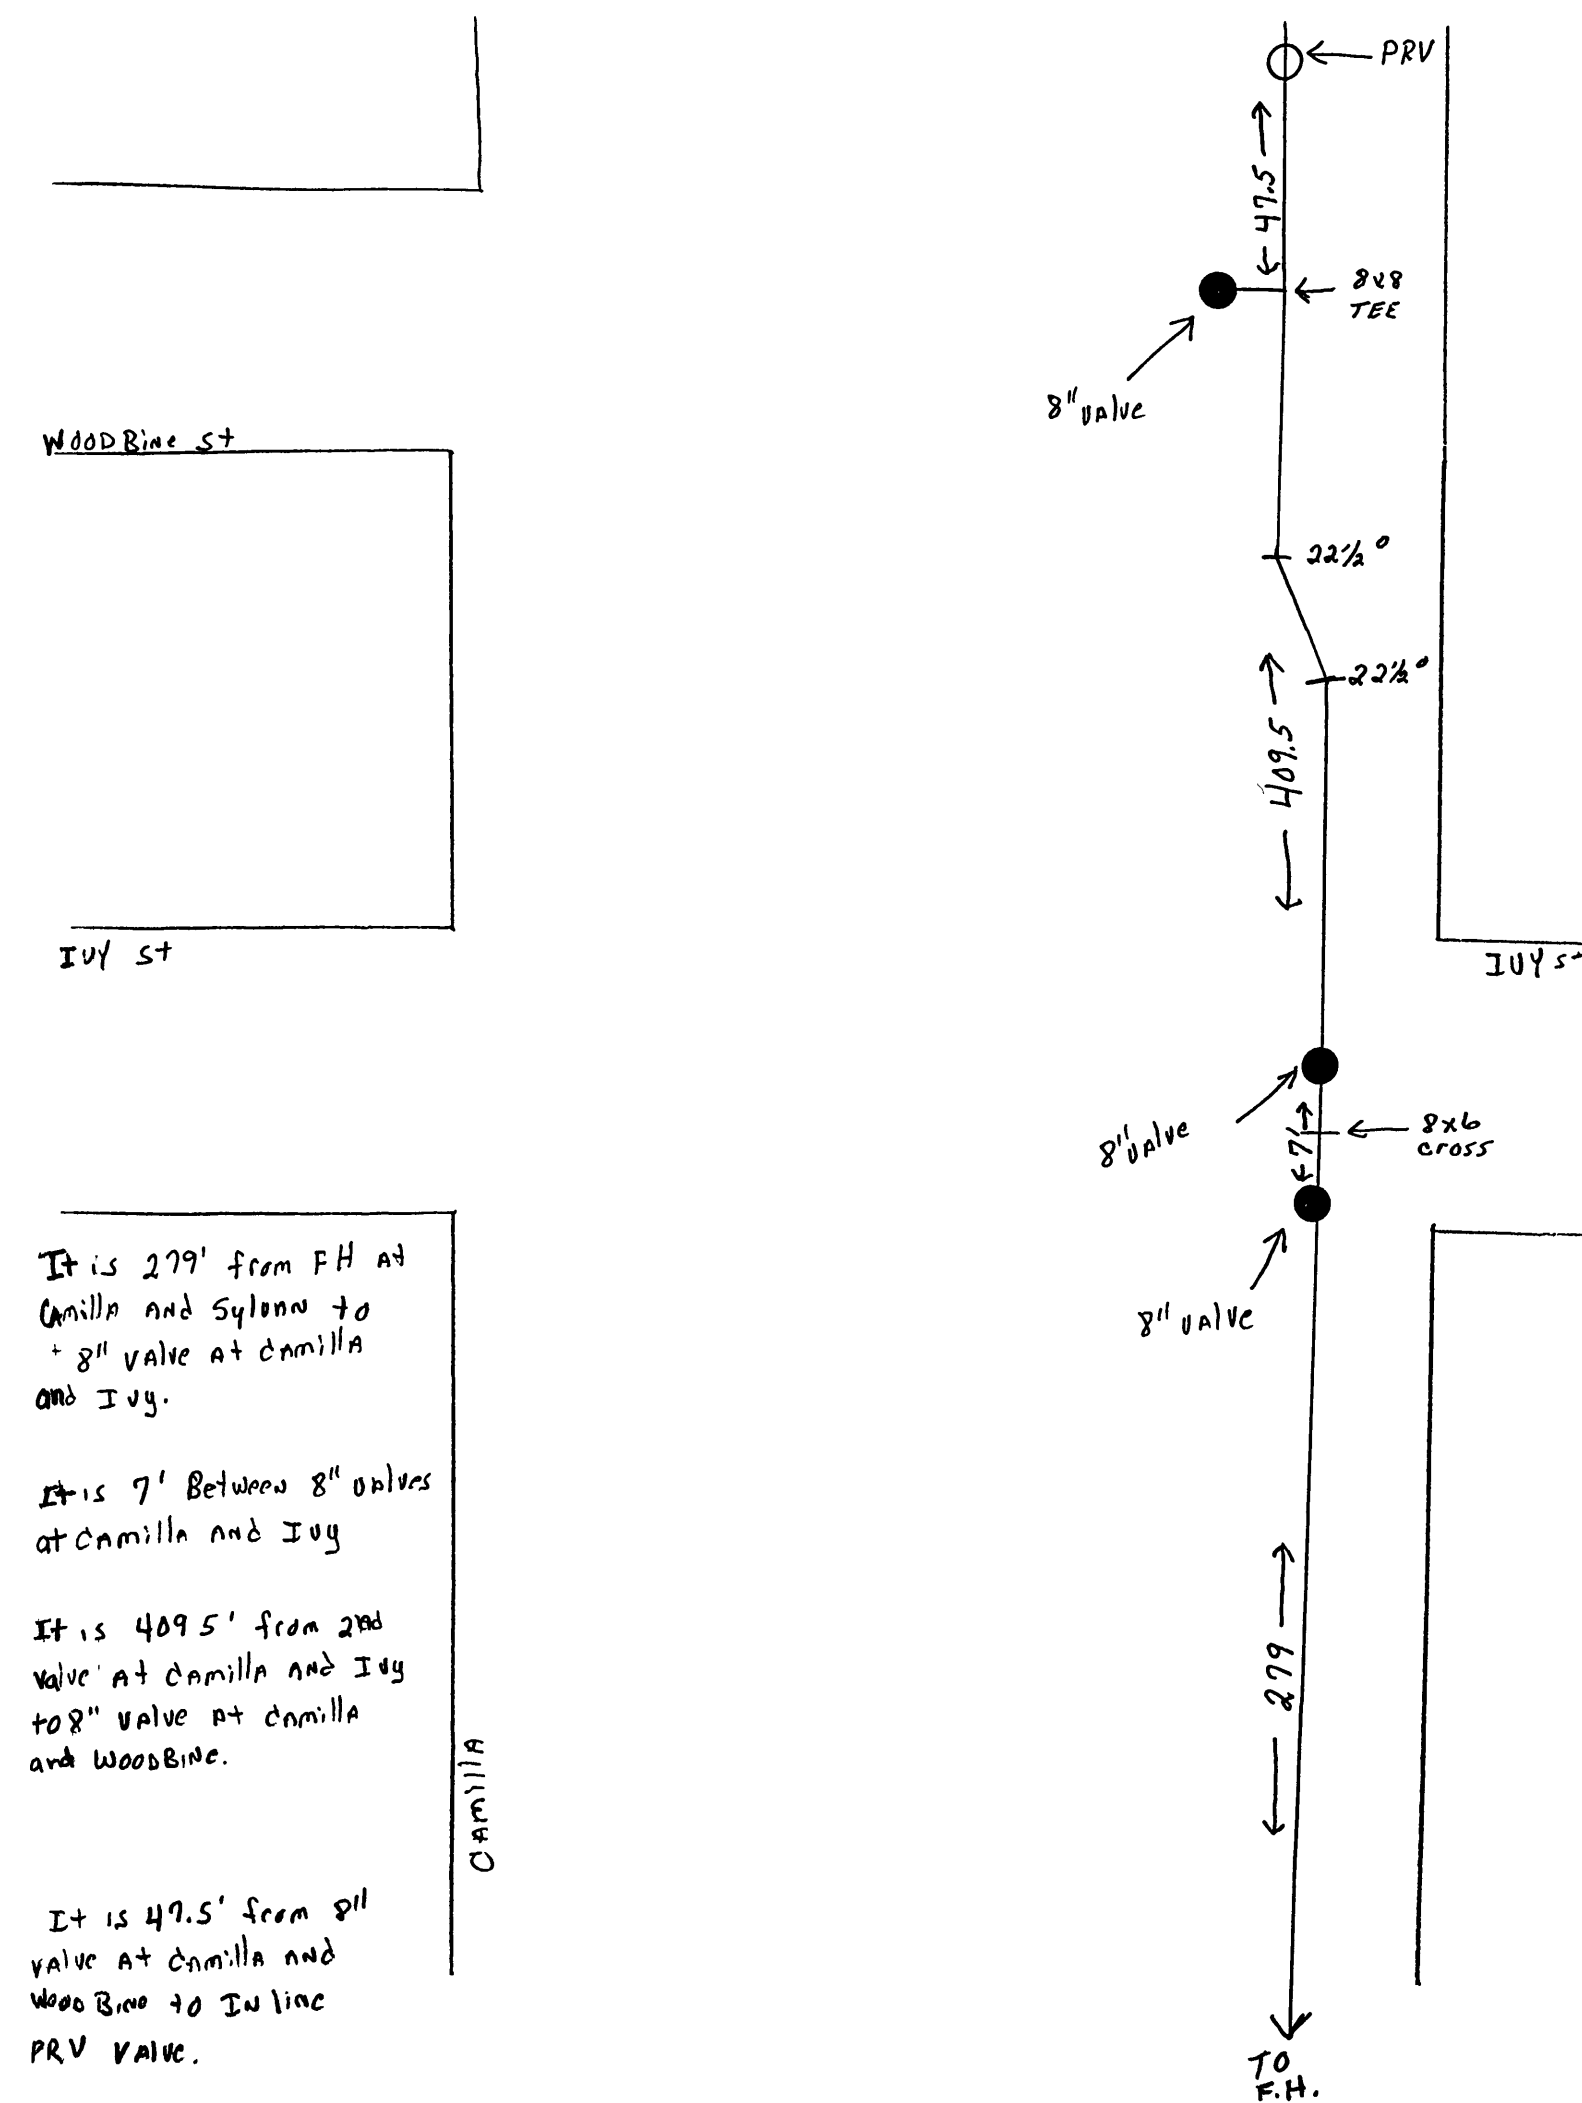
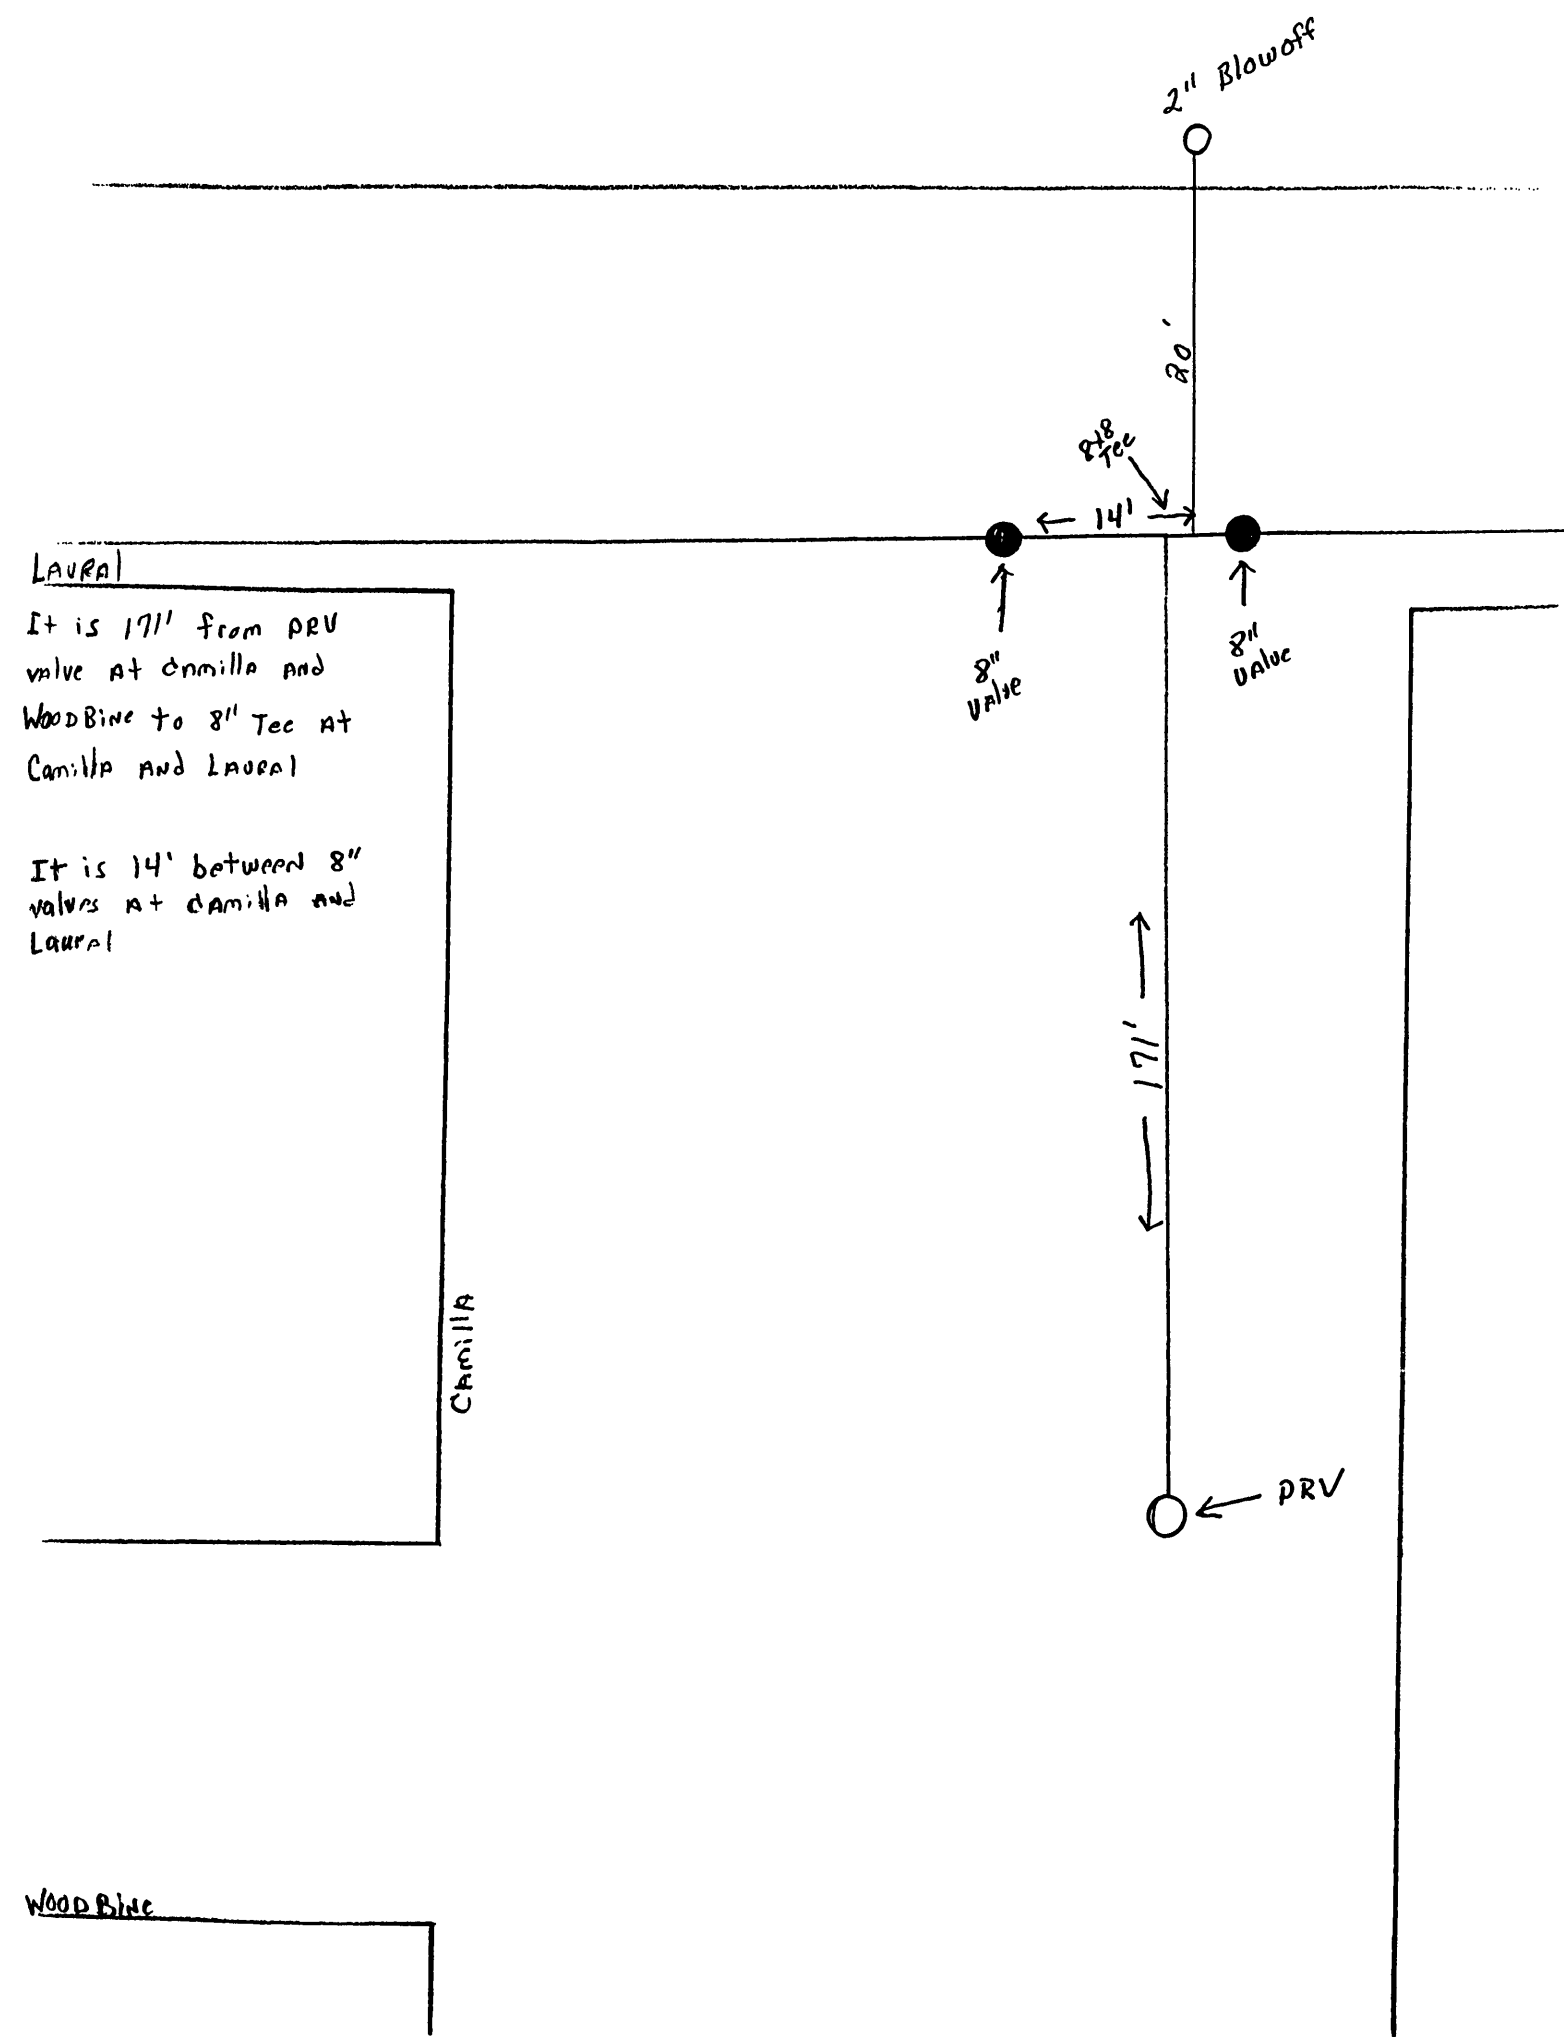


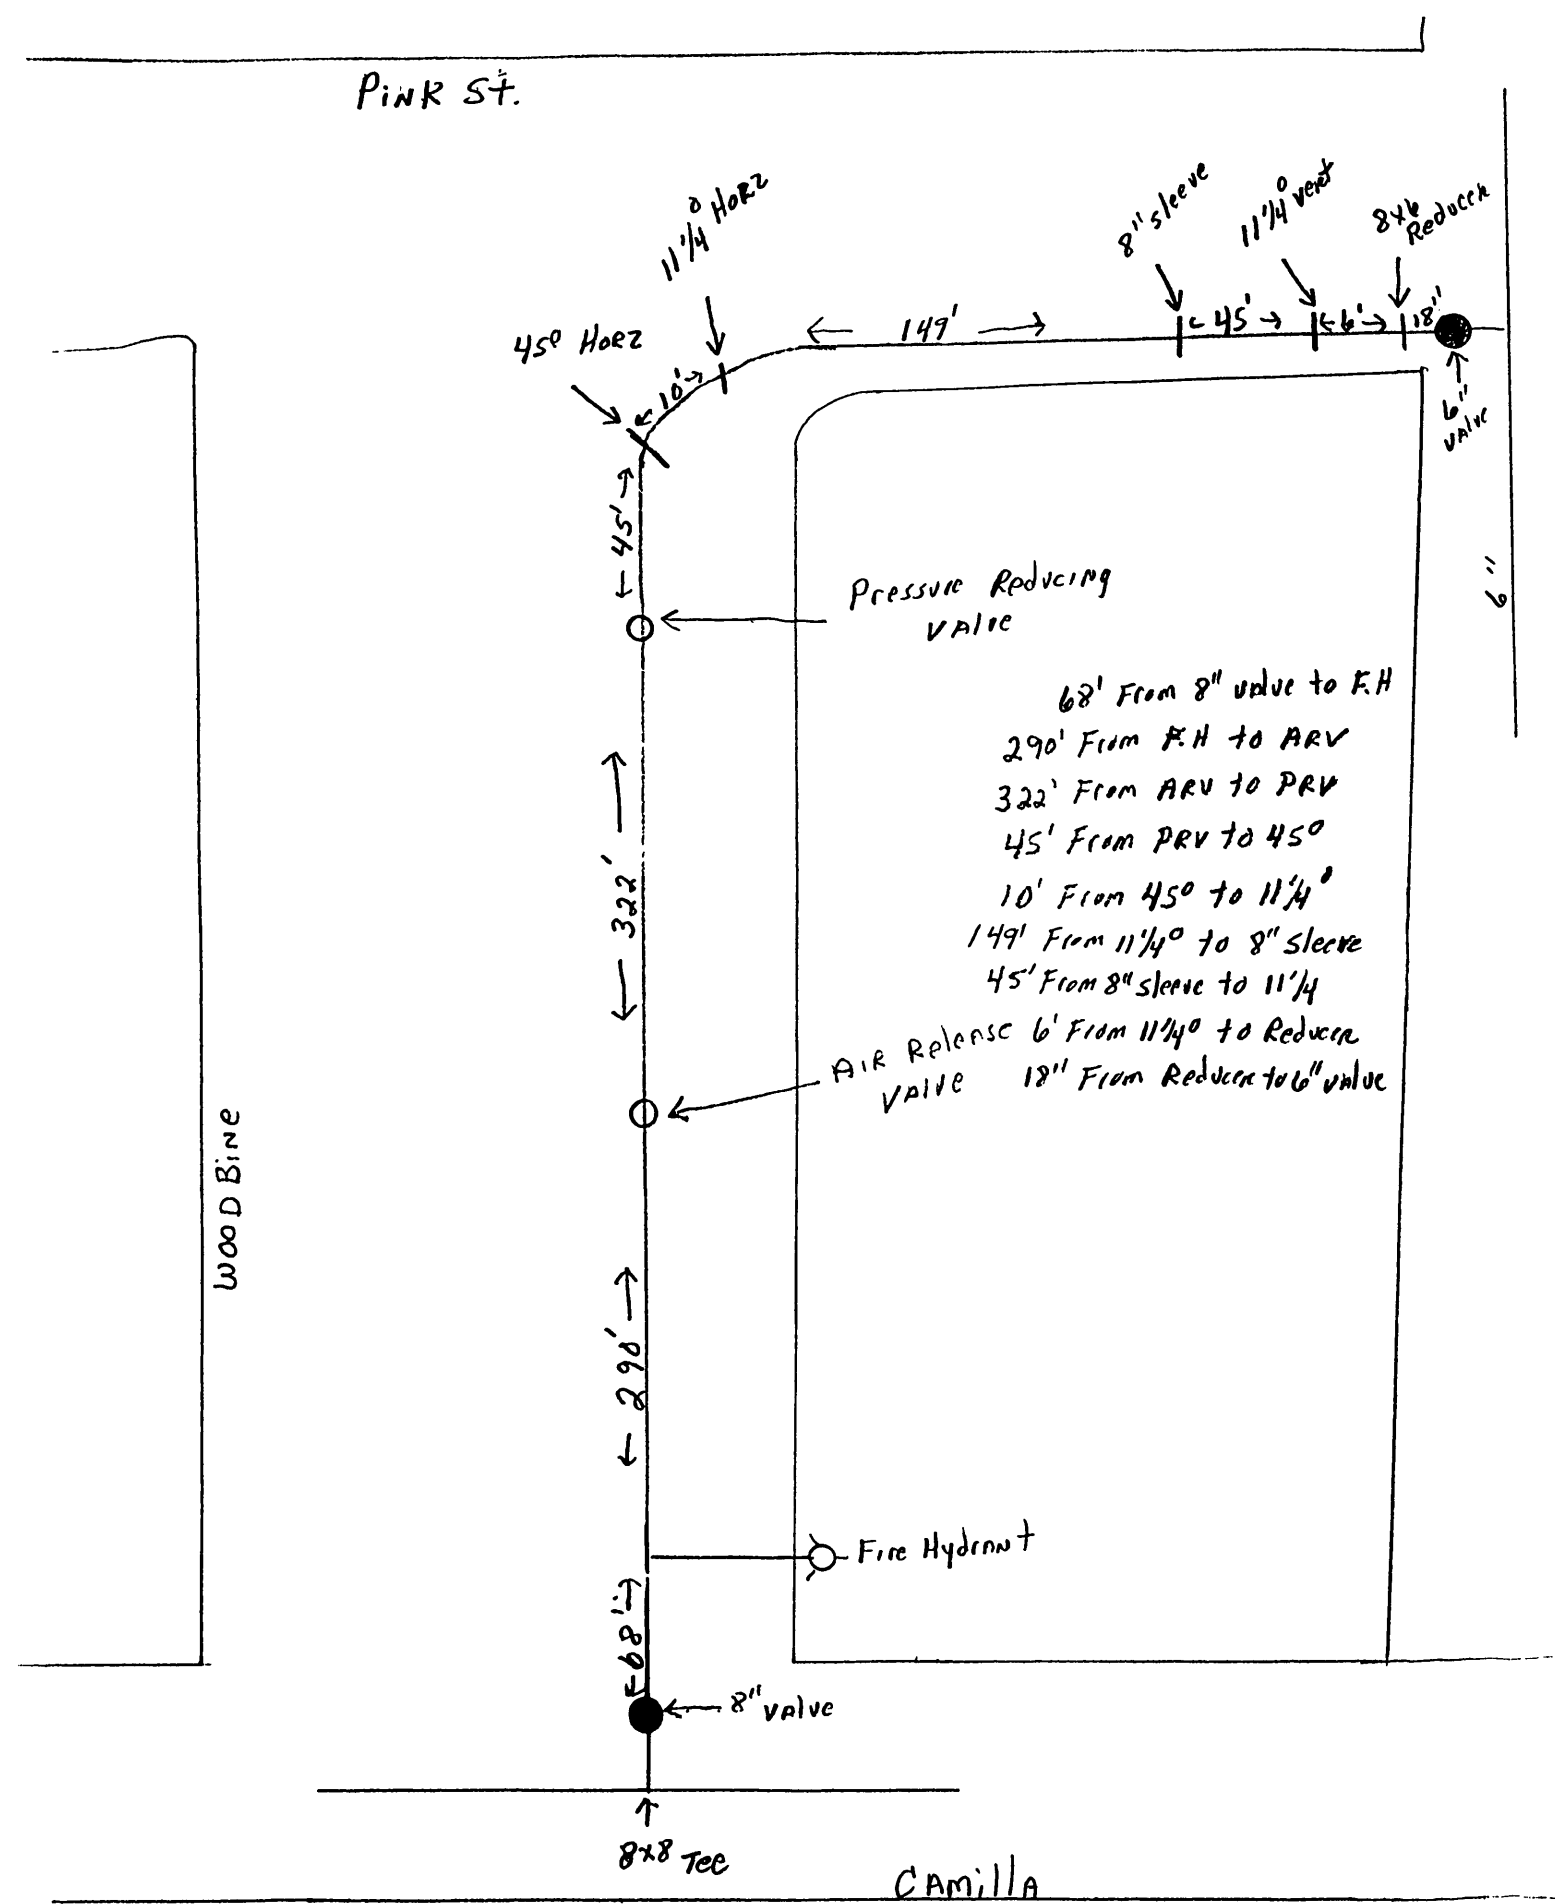

RECORD DRAWING

Designed: CDA
Drawn: CDA
Checked: CDA
Approved: JGR
Date: 19 JAN 2005
Project: 6GVJWG
C1
Sheet 3 of 3

MILL MOUNTAIN
WATER LINE UPGRADES