


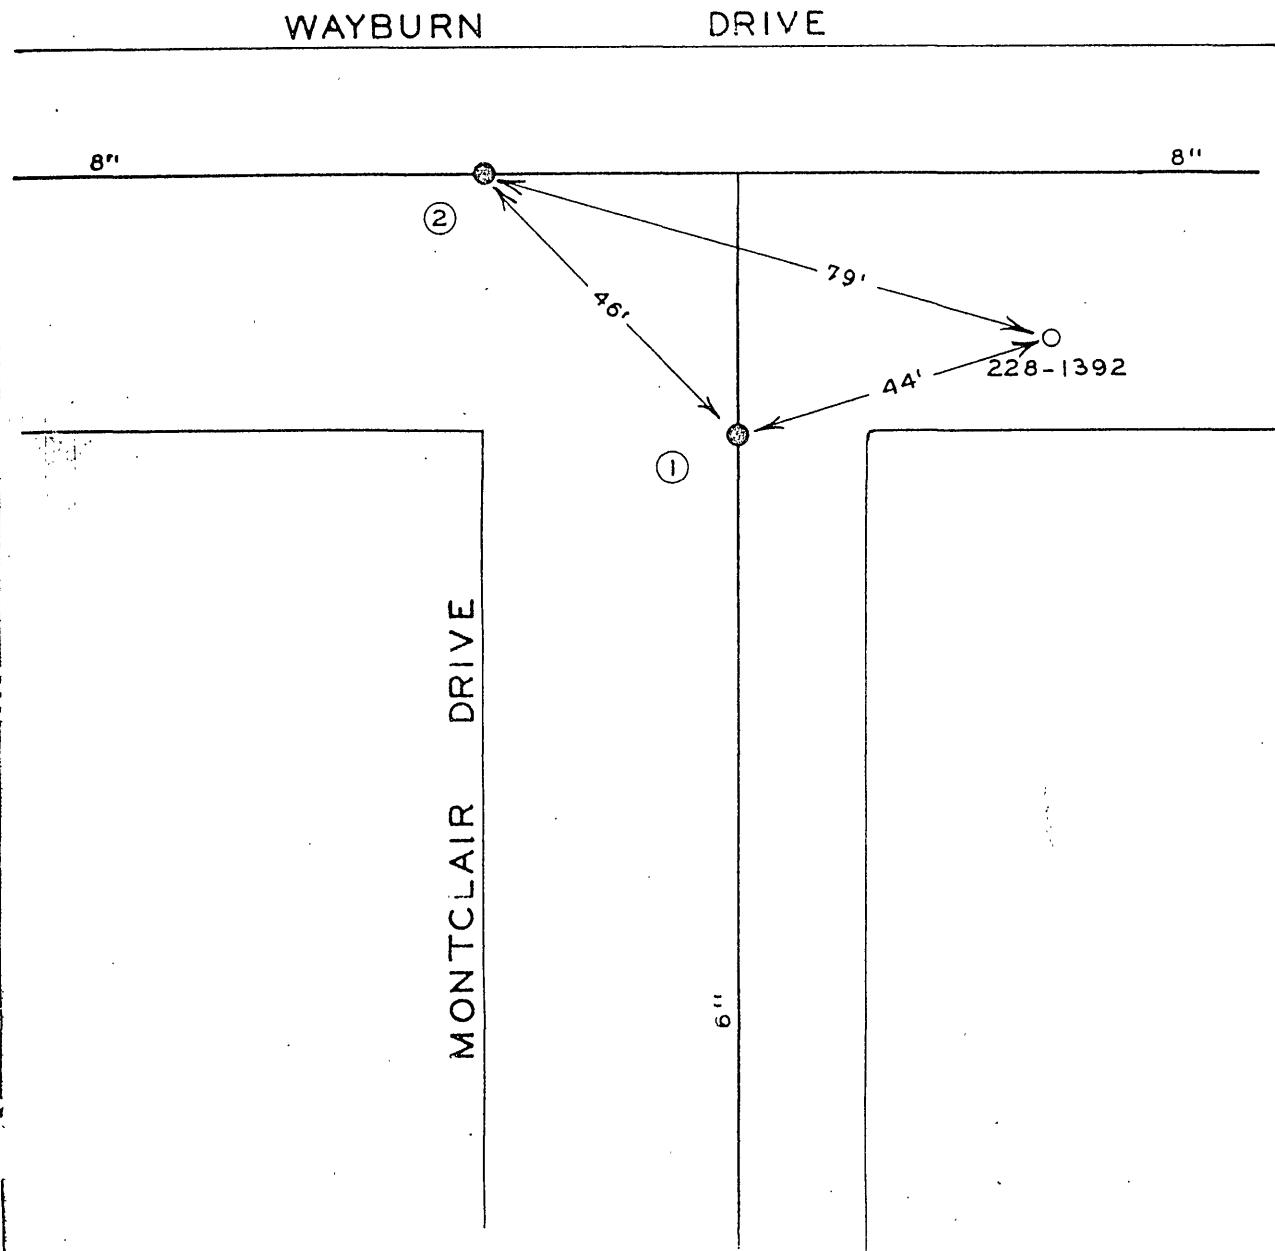

DATE	NO.	SIZE	MAKE	OPEN	TURNS
11-64	1	6	DARLING	R	21
11-64	2	8	DARLING	R	27
	1	0	SPL		
	2	0	WPL		

CITY OF ROANOKE - WATER DEPT.	
VALVE DIAGRAM	
MONTCLAIR DRIVE &	
WAYBURN DRIVE N.W.	
SEC. MAP	47 Roanoke County
DATE DEC 8 1965	PAGE NO.