
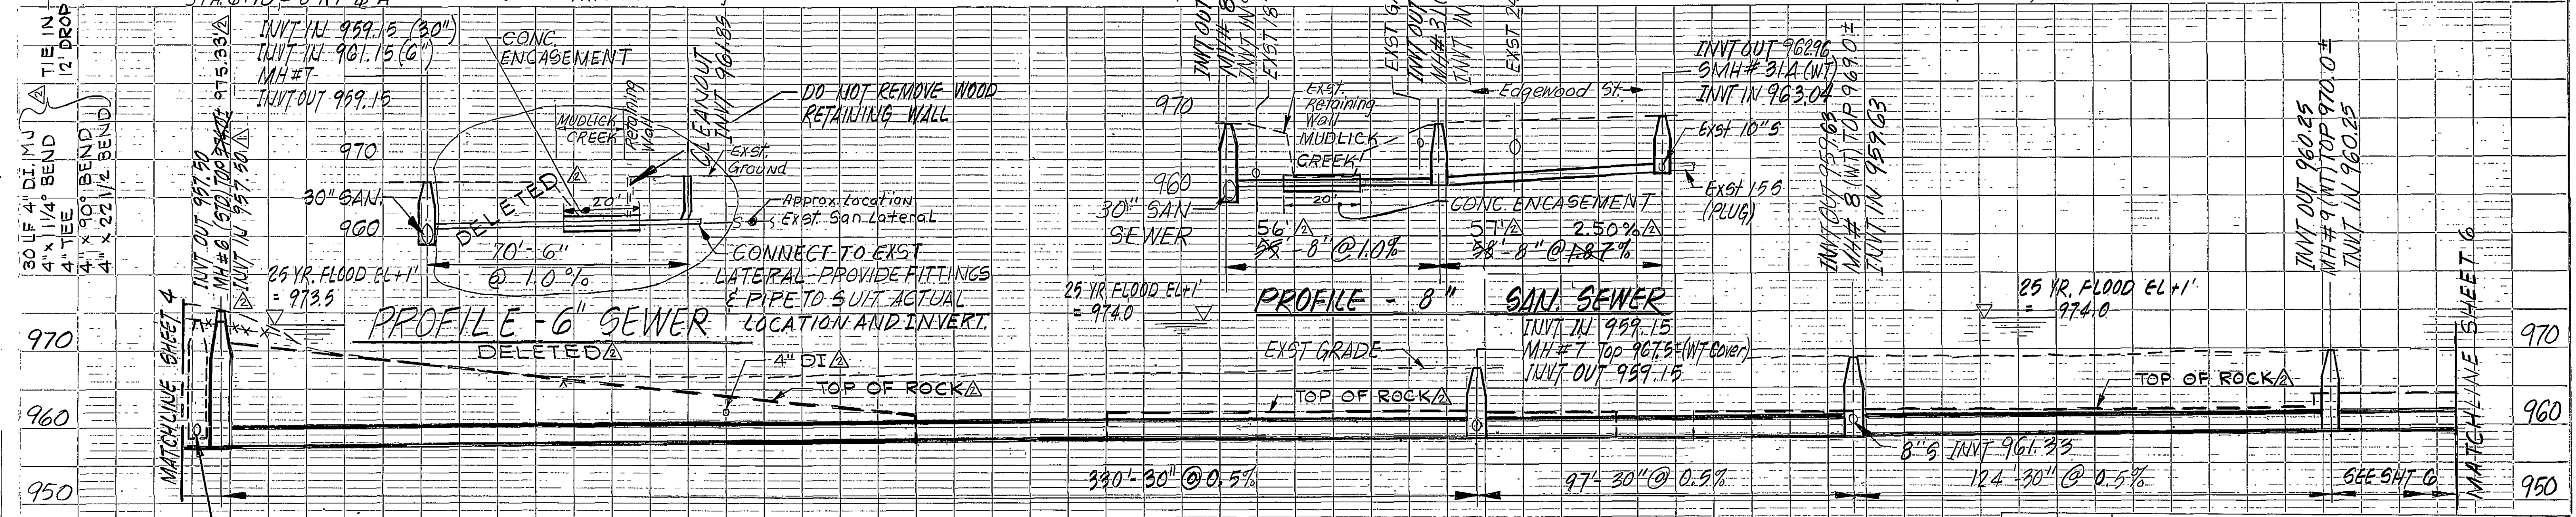


DATE	7/1/84
PROJECT	MUDLICK CREEK SANITARY SEWER
NOTE BOOK	REV. OF WAY DIST. CD.
NO.	

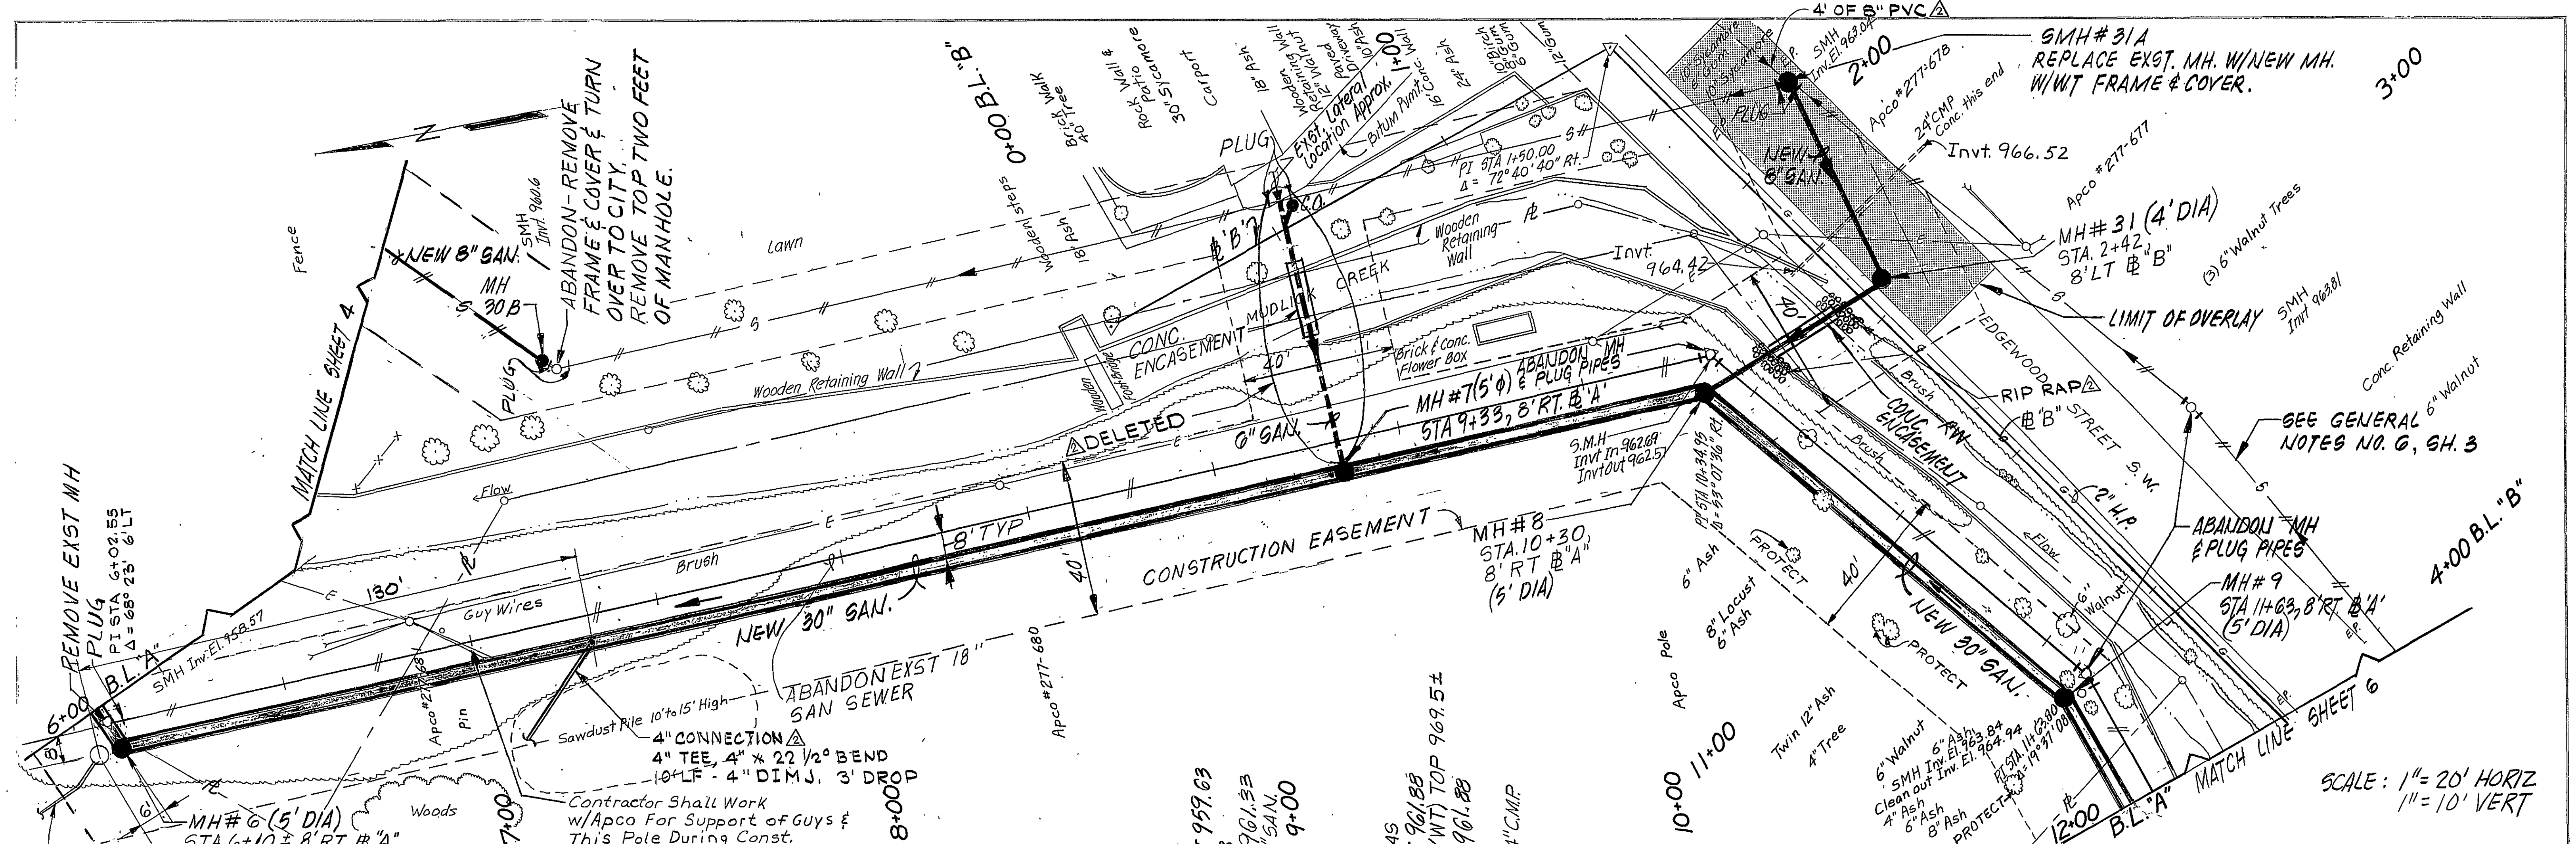


PROFILE - 30" SANITARY SEWER

6/15/88	RECORD DRAWINGS PER CONSTRUCTION RECORDS	JLJ/SWH		
10/30/84	REV PER SDH COMMENTS			
REVISION	DATE	DESCRIPTION	BY	APP
DESIGNED	JWC			
DRAWN	CAT			
CHECKED	SWH			
APPROVED				
SUBMITTED	SWH			

MUDLICK CREEK SANITARY SEWER

PLAN AND PROFILE

Mattern and Craig		SCALE: NOTED	COMM. NO. 473
CONSULTING ENGINEERS ROANOKE, VIRGINIA		DATE: JULY 84	SHEET 5

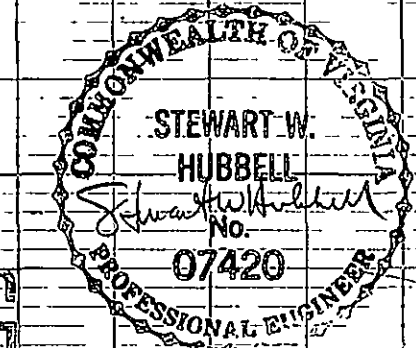

RECORD DRAWING