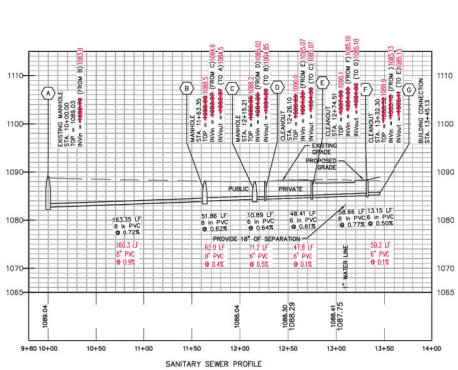
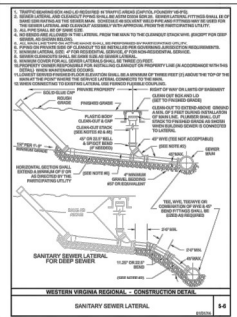
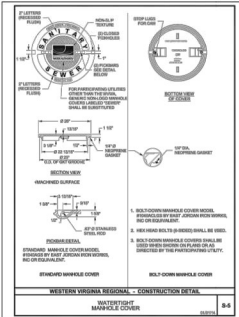


AS-BUILT FEATURES LEGEND:

—	SANITARY SEWER LINE
□ WM	WATER METER
○	MANHOLE
○ C.O.	UTILITY CLEAN OUT

GAY AND NEEL, INC.
ENGINEERING ♦ AND PLANNING ♦ SURVEYING

1260 Radford Street
Christiansburg, Virginia 24073

Phone: (540) 381-6011
Fax: (540) 381-2773
Email: info@gayandneel.com
Web: www.gayandneel.com

The drawing, design, and digital files relating to this project are the property of Gay and Neel, Inc. The reproduction, copying, or other use of this drawing without GNI's written consent is prohibited.

NATIONAL BANK
ROANOKE OFFICE

ROANOKE, VIRGINIA



REVISIONS		
NO.	COMMENTS	DATE

PROJECT TEAM	
PC	JOHN T. NEEL, PE

25	BRYANT H. ALTIZER, PE LS
----	--------------------------

DESIGN	ESD, ZJM
ISSUE DATE	

ISSUE DATE	04/13/2021
CAN JOB NO	

2960

SHEET TITLE
UTILITY PROFILES AND DETAILS

SHEET NUMBER

C4-02