


DATE STARTED 10-21-97
 DATE COMP. 10-28-97
 FEET MAIN - 360
 SIZE - 8"
 VALVES - 2
 VAULTS - 2
 DATE COMP. 11-27-97
 "AS BUILT"

TEMPORARY CONSTRUCTION
 LIMITS

EXIST. DI-7A WITH CONC.
 IC. R/W MON.
 1069331.93
 642148.22

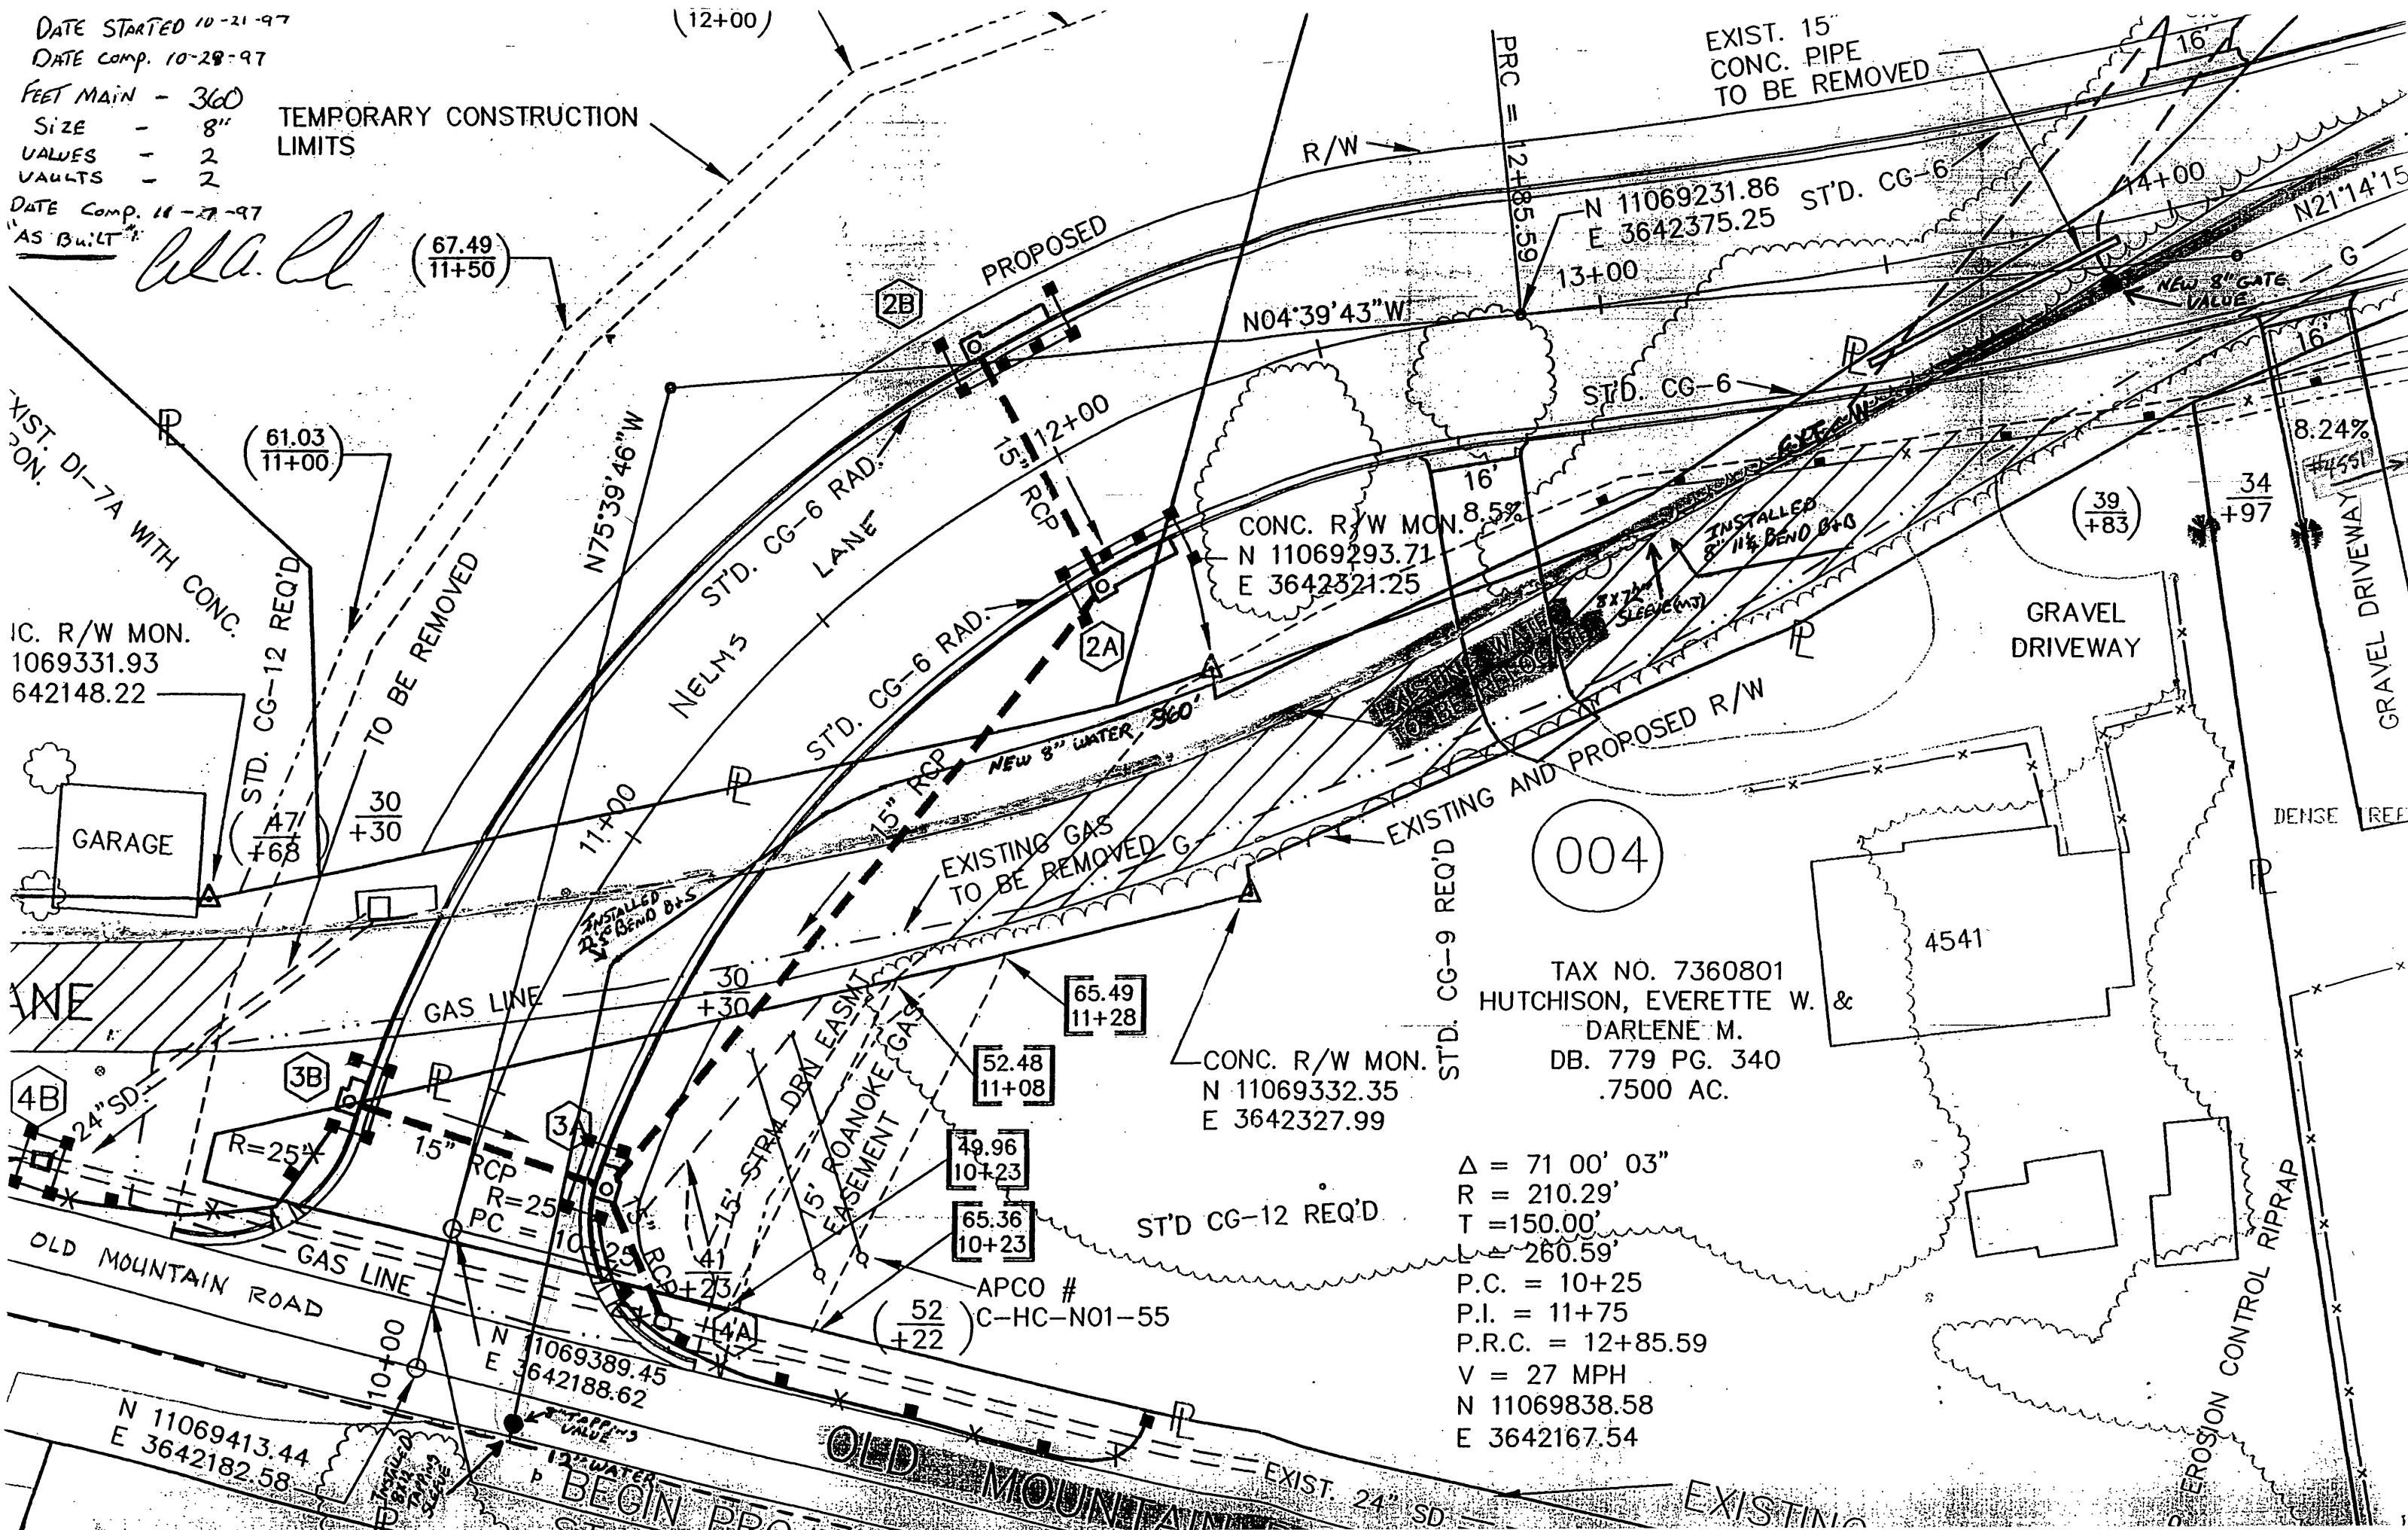

TAX NO. 7360801
 HUTCHISON, EVERETTE W. &
 DARLENE M.
 DB. 779 PG. 340
 .7500 AC.

$\Delta = 71^{\circ} 00' 03''$
 $R = 210.29'$
 $T = 150.00'$
 $L = 260.59'$
 $P.C. = 10+25$
 $P.I. = 11+75$
 $P.R.C. = 12+85.59$
 $V = 27 \text{ MPH}$
 $N 11069838.58$
 $E 3642167.54$

APCO #
 C-HC-N01-55

$N 11069413.44$
 $E 3642182.58$

BEGIN

OLD MOUNTAIN ROAD

EXIST. 24" SD

EXISTING

EROSION CONTROL RIPRAP