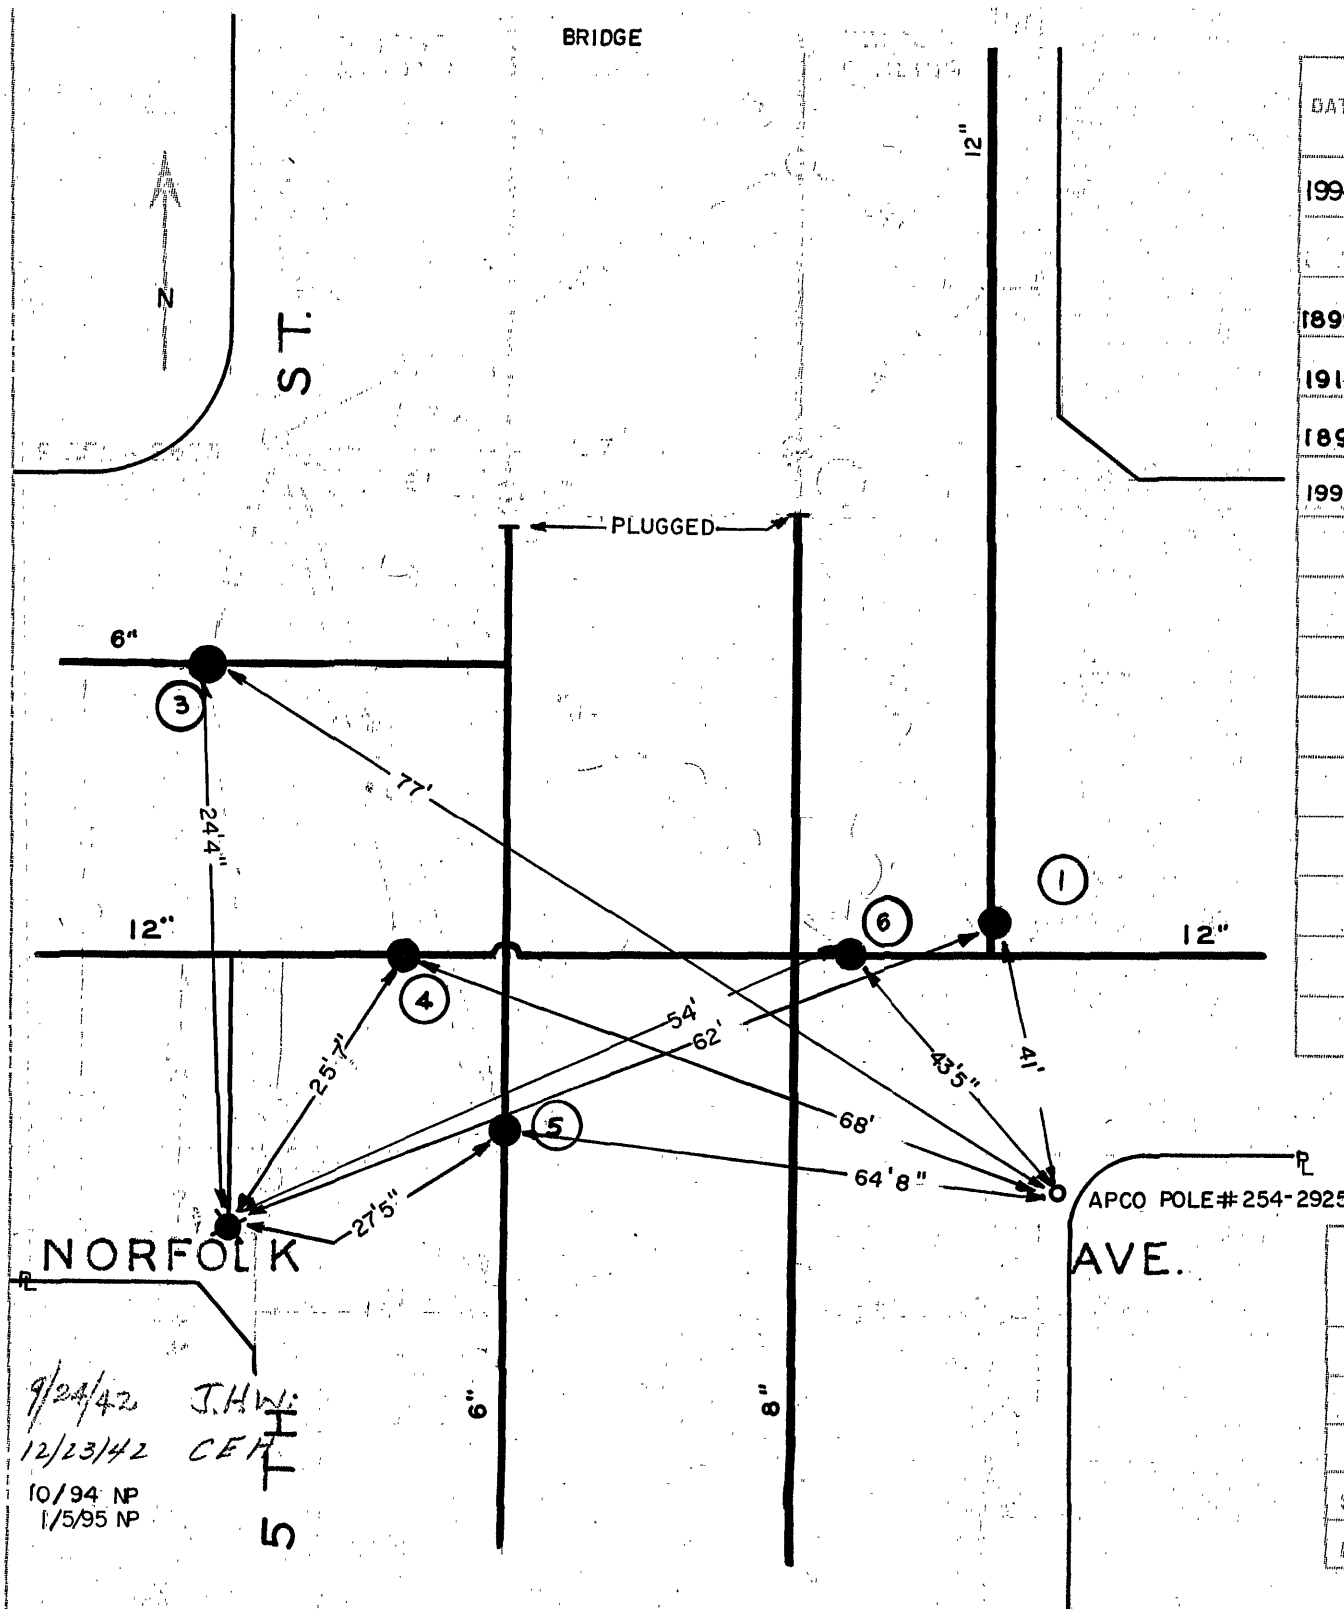


[illegible]

CITY OF ROANOKE—WATER DEPT
VALVE DIAGRAM

NORFOLK AVE, & 5TH ST. S W.

SEC. MAP 101

DATE _____

PAGE 110. S.W. 8