



# ROANOKE COUNTY BOARD OF SUPERVISORS

## GLENVAR HEIGHTS BOULEVARD

### WATER LINE

### EXTENSION PROJECT

SITUATED IN  
 CATAWBA MAGISTERIAL DISTRICT  
 ROANOKE COUNTY, VIRGINIA

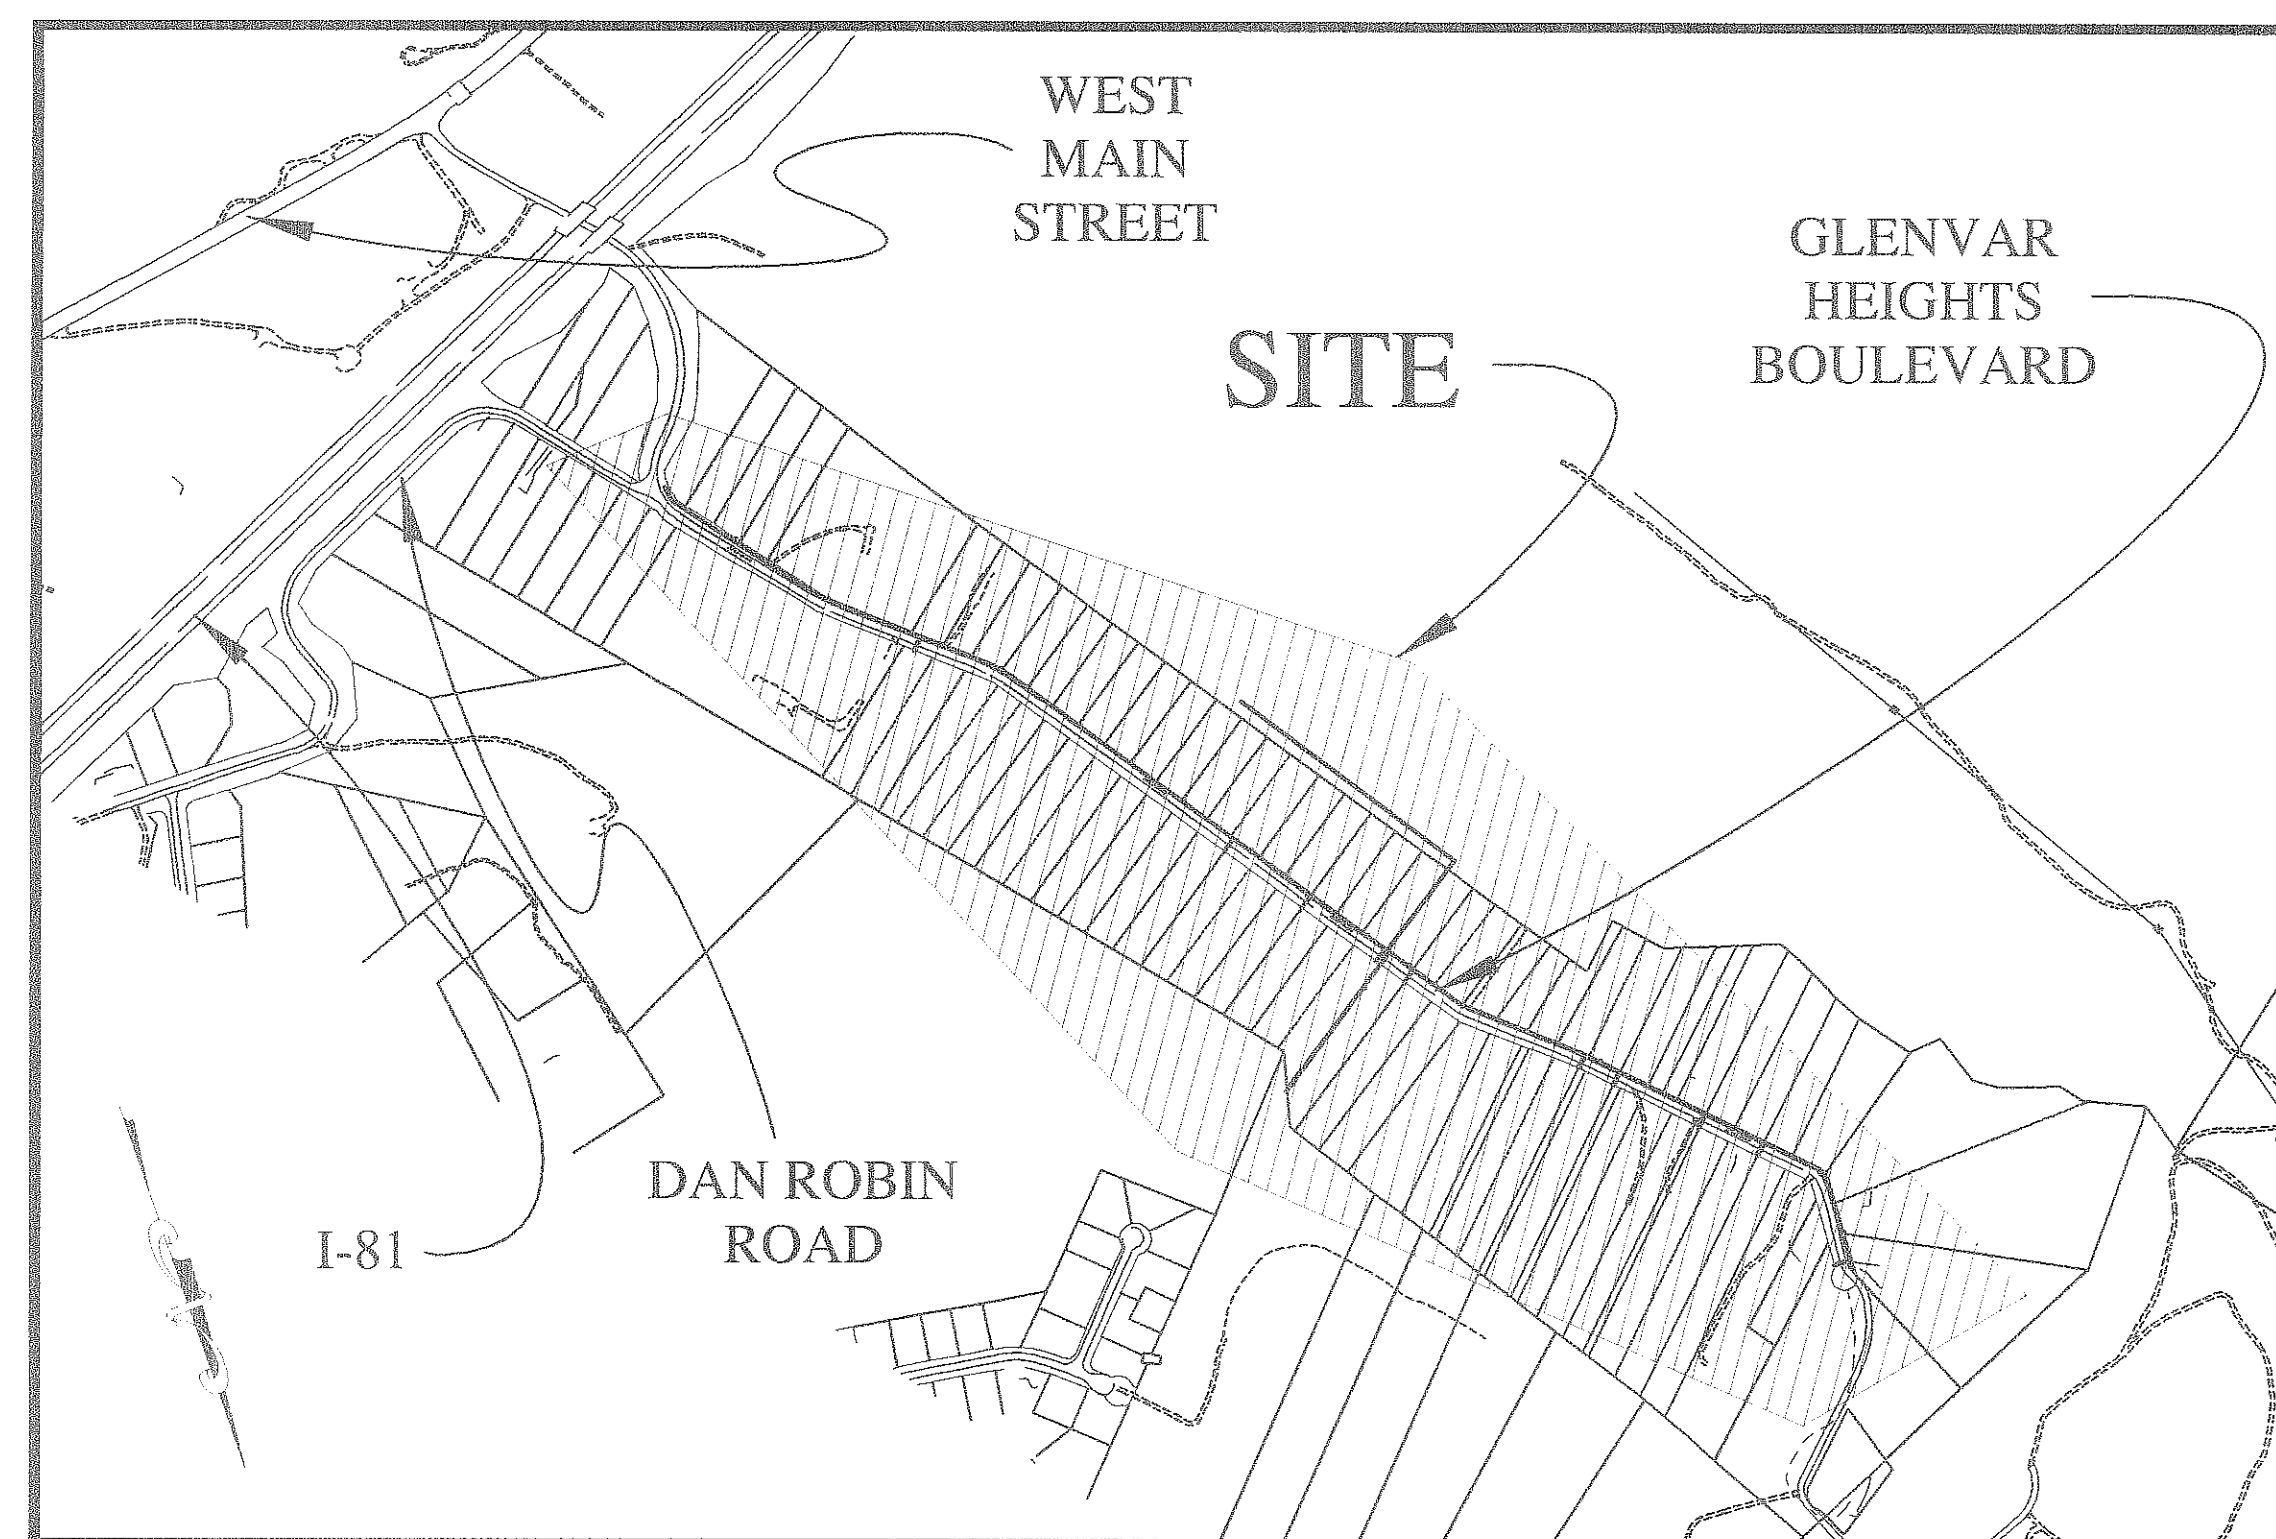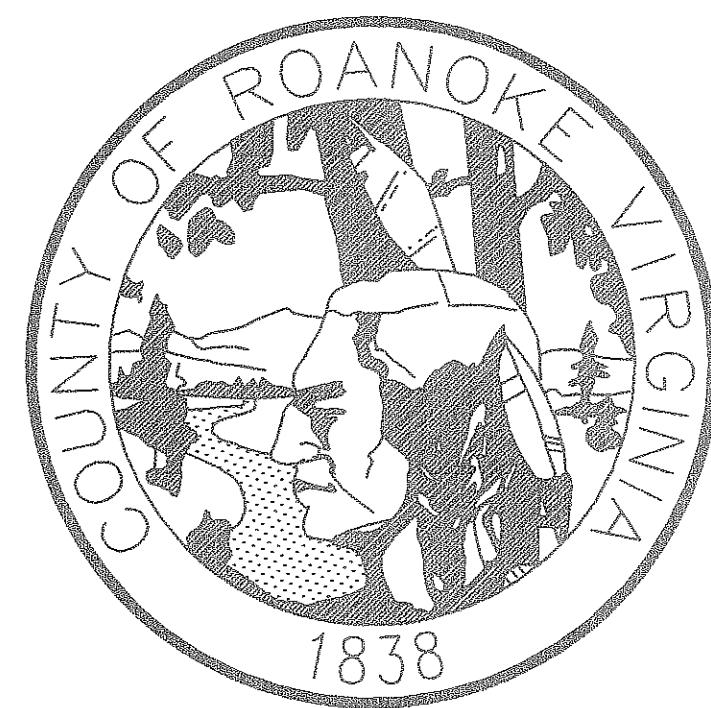

VICINITY MAP  
 1" = 600'

#### SCHEDULE OF DRAWINGS

SHEET	TITLE
2	SHEET INDEX
3	8" WATERLINE PLAN & PROFILE
4	8" WATERLINE PLAN & PROFILE
5	8" WATERLINE PLAN & PROFILE
6	24" WATERLINE PLAN & PROFILE
7	24" WATERLINE PLAN & PROFILE
8	DETAILS SHEET

AS BUILT  
 8/27/03

ROANOKE COUNTY UTILITY DEPARTMENT  
 1206 KESSLER MILL ROAD  
 SALEM, VIRGINIA 24153