




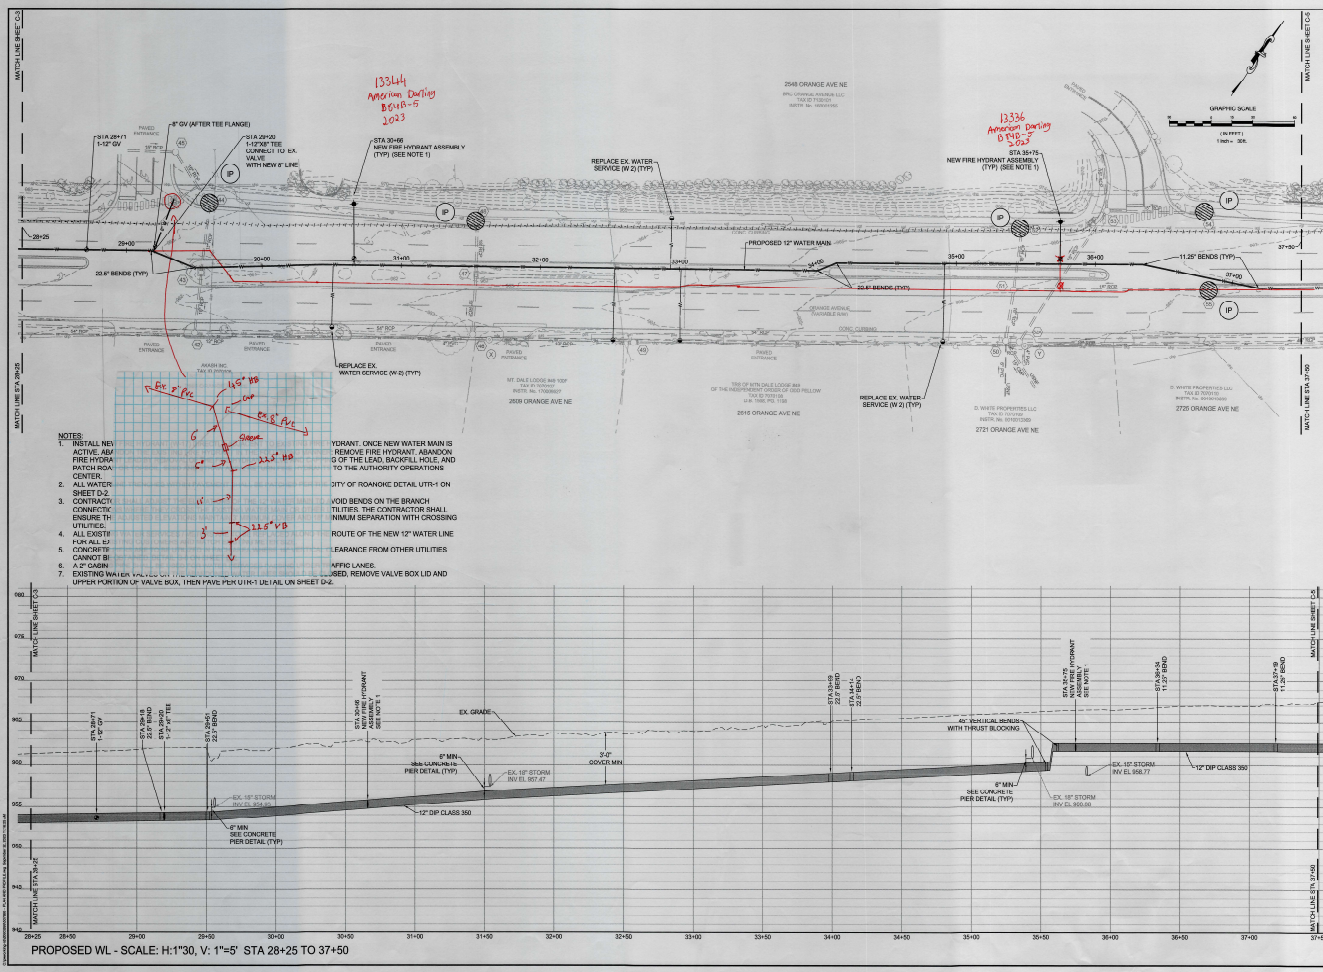

Draper Aden Associates
 Engineering • Surveying • Environmental Services
 2000 North Main Street, Suite A
 Raleigh, NC 27601
 Phone: 919.488.8888
 Fax: 919.488.8889
 www.drapeeraden.com

**WATERLINE PLAN AND PROFILE (3 OF 6)
 ORANGE AVE & GUS NICKS
 WATER MAIN REPLACEMENT**

REVISED: 01/11/2011

DESIGNED BY	WCR
DRAWN BY	WCR
CHECKED BY	WCR
DATE	11/11/2011
PROJECT NUMBER	607066

C-4
 9 OF 20