**NEW WWA ASSETS INSTALLED:****FIRE HYDRANT**

NORTHING: 3628001.68  
EASTING: 11063664.85  
ELEVATION: 971.00

**HYDRANT GATE VALVE**


NORTHING: 3627990.44  
EASTING: 11063665.25  
ELEVATION: 969.82 (VALVE TOP)  
ELEVATION: 965.95 (VALVE TOP OF NUT)

**AS-BUILT**


AS-BUILT INFORMATION SHOWN ON  
THIS PLAN IS THE RESULT OF A FIELD  
SURVEY PERFORMED  
BY LUMSDEN ASSOCIATES, P.C. OR AS  
SUPPLIED BY SITEPRO, INC.  
(CONTRACTOR) FIELD MARKUPS.

**SURVEY CONTROL PROVIDED / UTILIZED:**

- ▲ **CONTROL POINT No. 1**  
NORTHING: 3628009.32  
EASTING: 11063684.92  
ELEVATION: 970.82
- ▲ **CONTROL POINT No. 2**  
NORTHING: 3627931.40  
EASTING: 11063889.07  
ELEVATION: 986.38

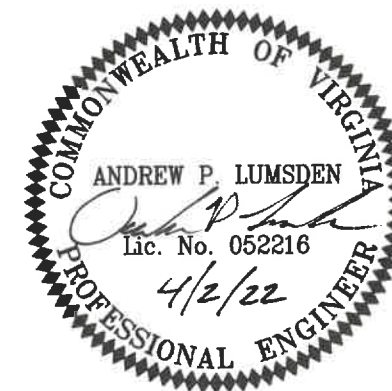**FIRE HYDRANT  
AS-BUILT**

OUR LADY OF THE VALLEY  
650 JEFFERSON STREET, N.W.

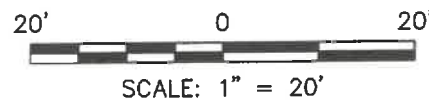

**Lumsden Associates, P.C.**  
ENGINEERS | SURVEYORS | PLANNERS

4664 BRAMBLETON AVENUE  
P.O. BOX 20669  
ROANOKE, VIRGINIA 24018

PHONE: (540) 774-4411  
FAX: (540) 772-9445  
WWW.LUMSDENPC.COM

DATE:	April 2, 2022
COMM. NO.:	21-322
SCALE:	1" = 20'