


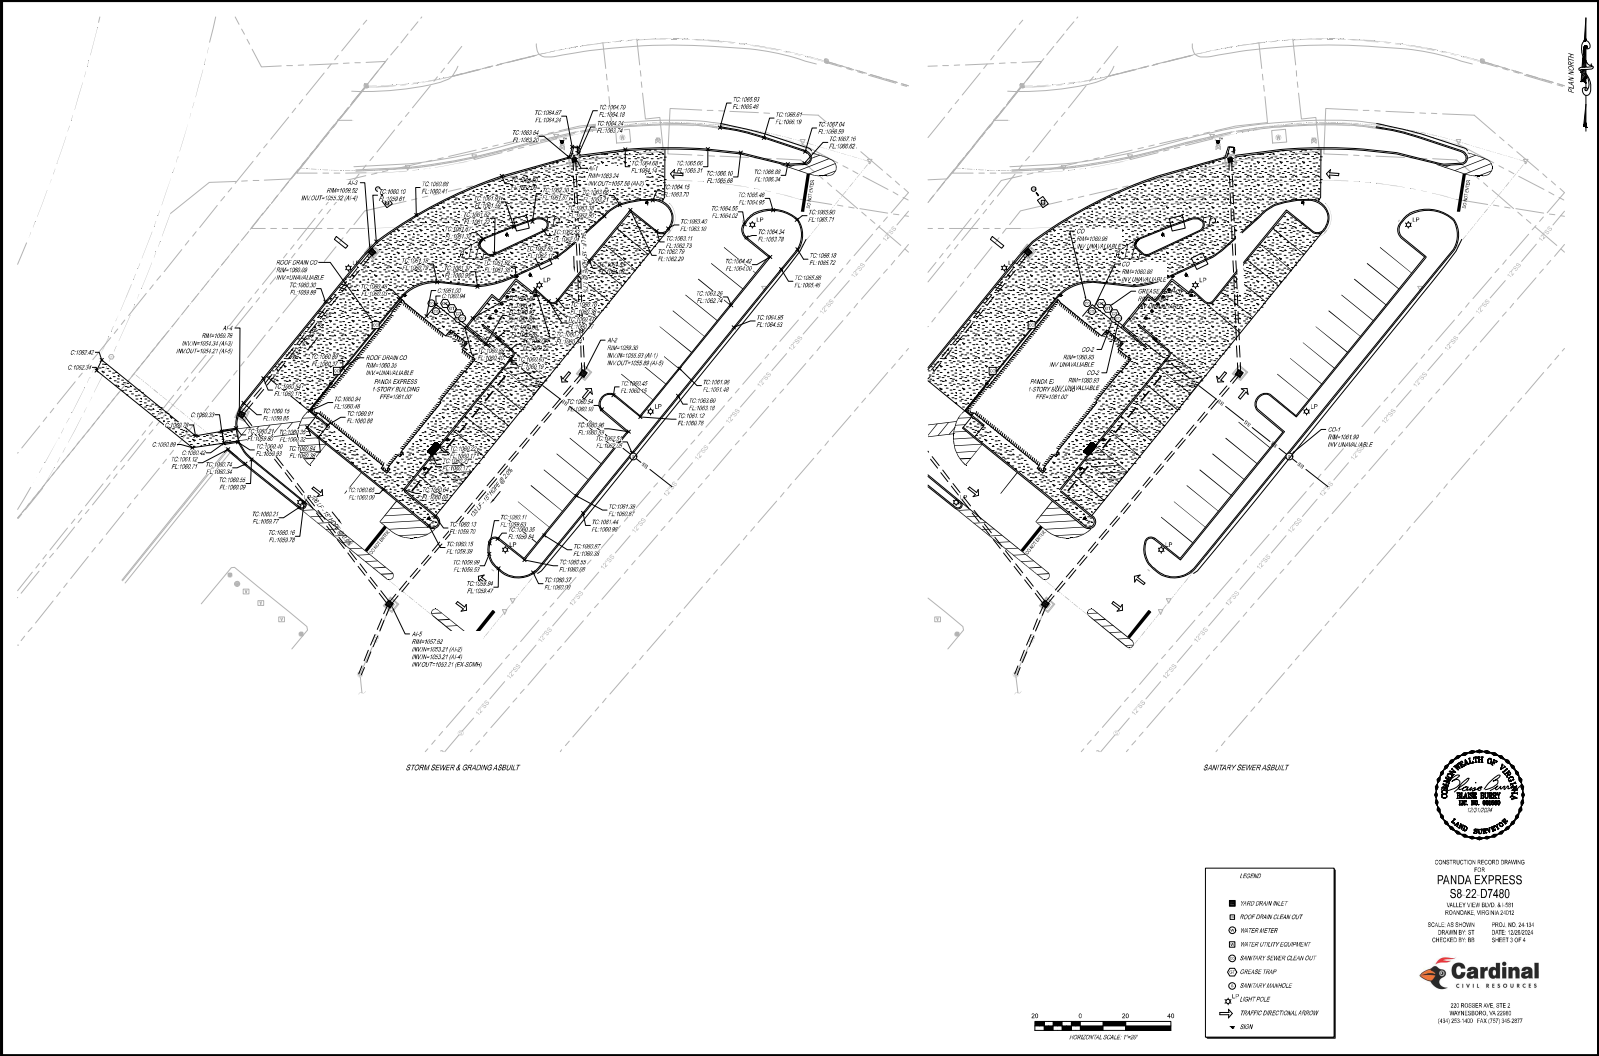

CONSTRUCTION RECORD DRAWING
P/S
PANDA EXPRESS
S8 22 07480
VALLEY VIEW BLVD. & STS
ROCKSPRING, VIRGINIA 22842
SCALE: AS SHOWN PROJ. NO. 24 131
DRAWN BY: ST DATE: 12/20/2024
CHECKED BY: RBG SHEET: 1 OF 4



Cardinal
CIVIL RESOURCES
220 ROSSER AVE. STE. 2
MAYFIELD, VA 22961
(434) 253-1400 FAX (434) 253-1407