

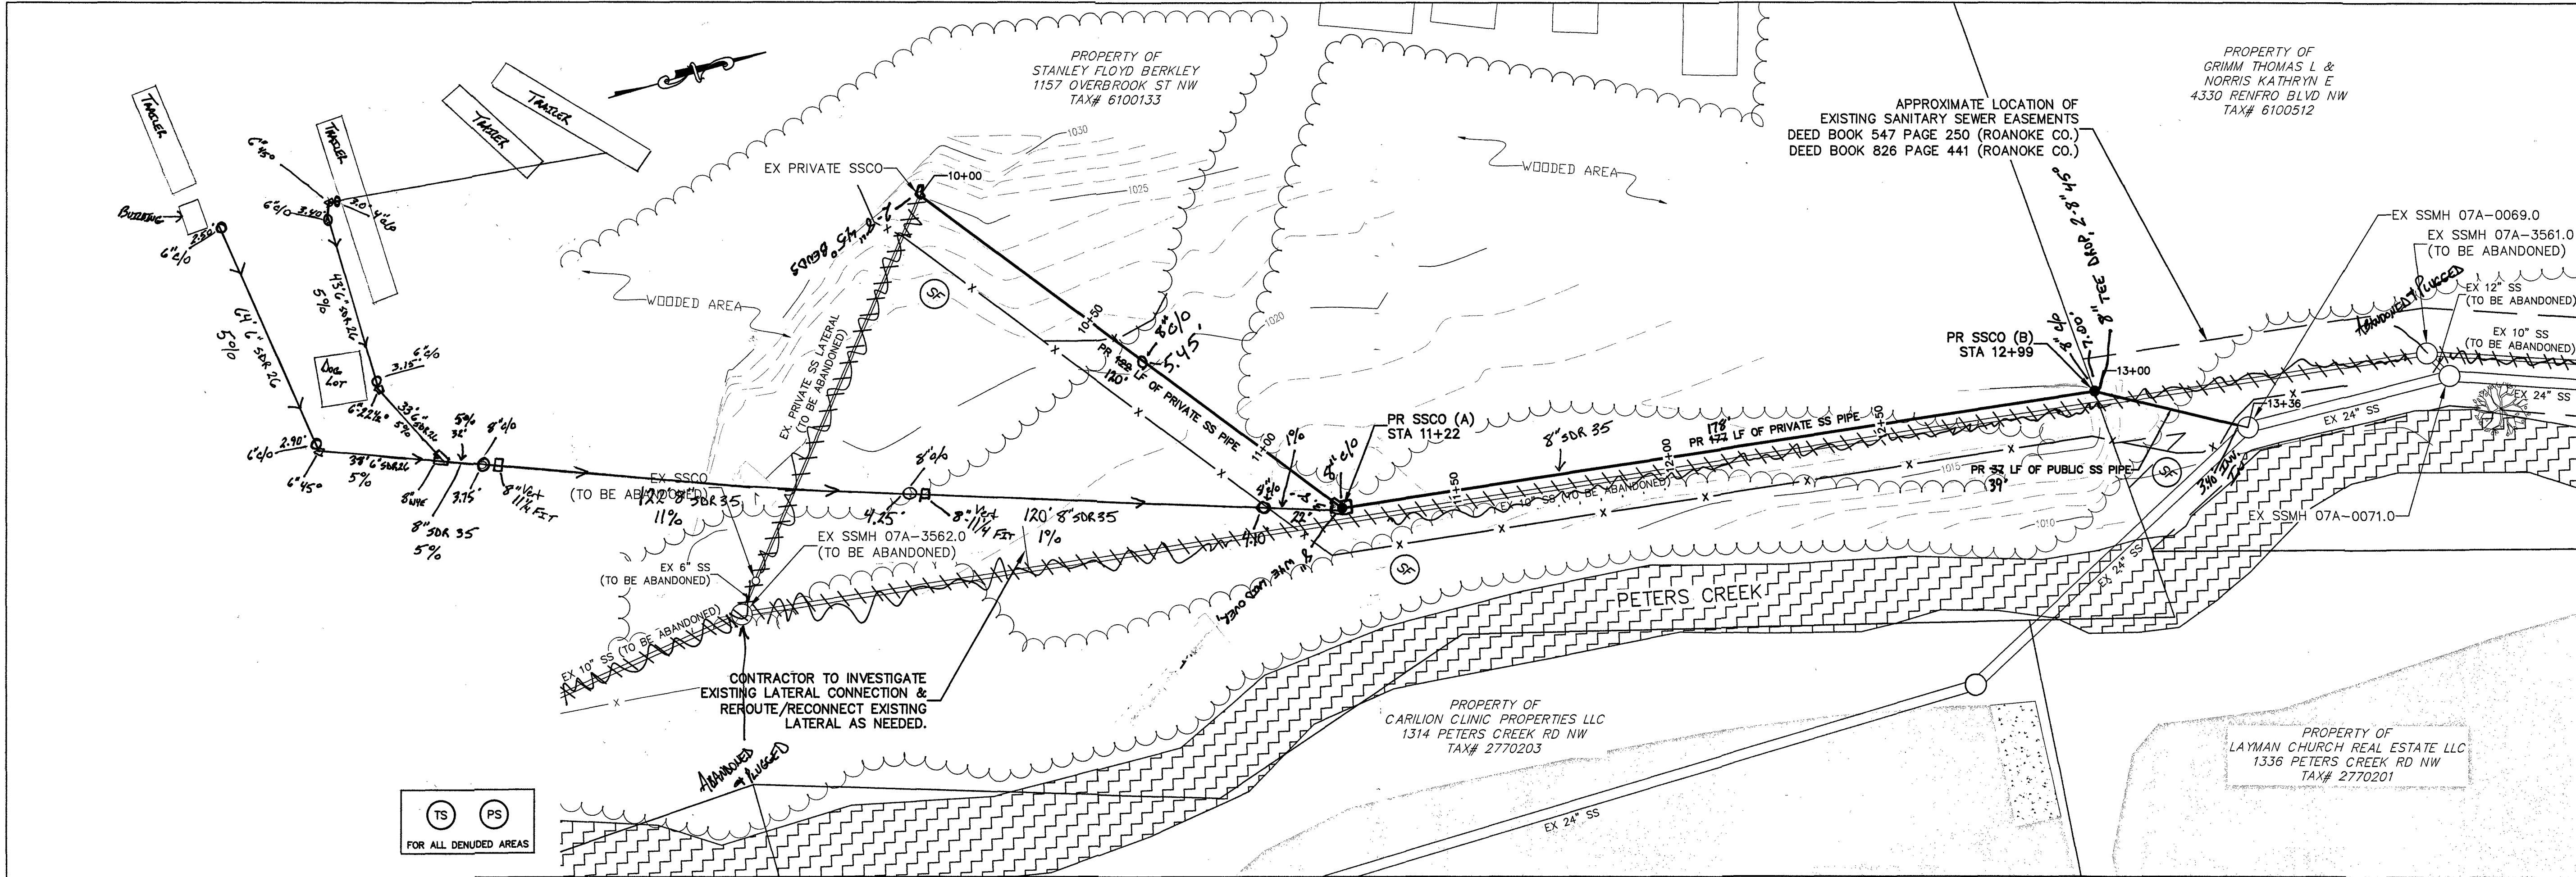


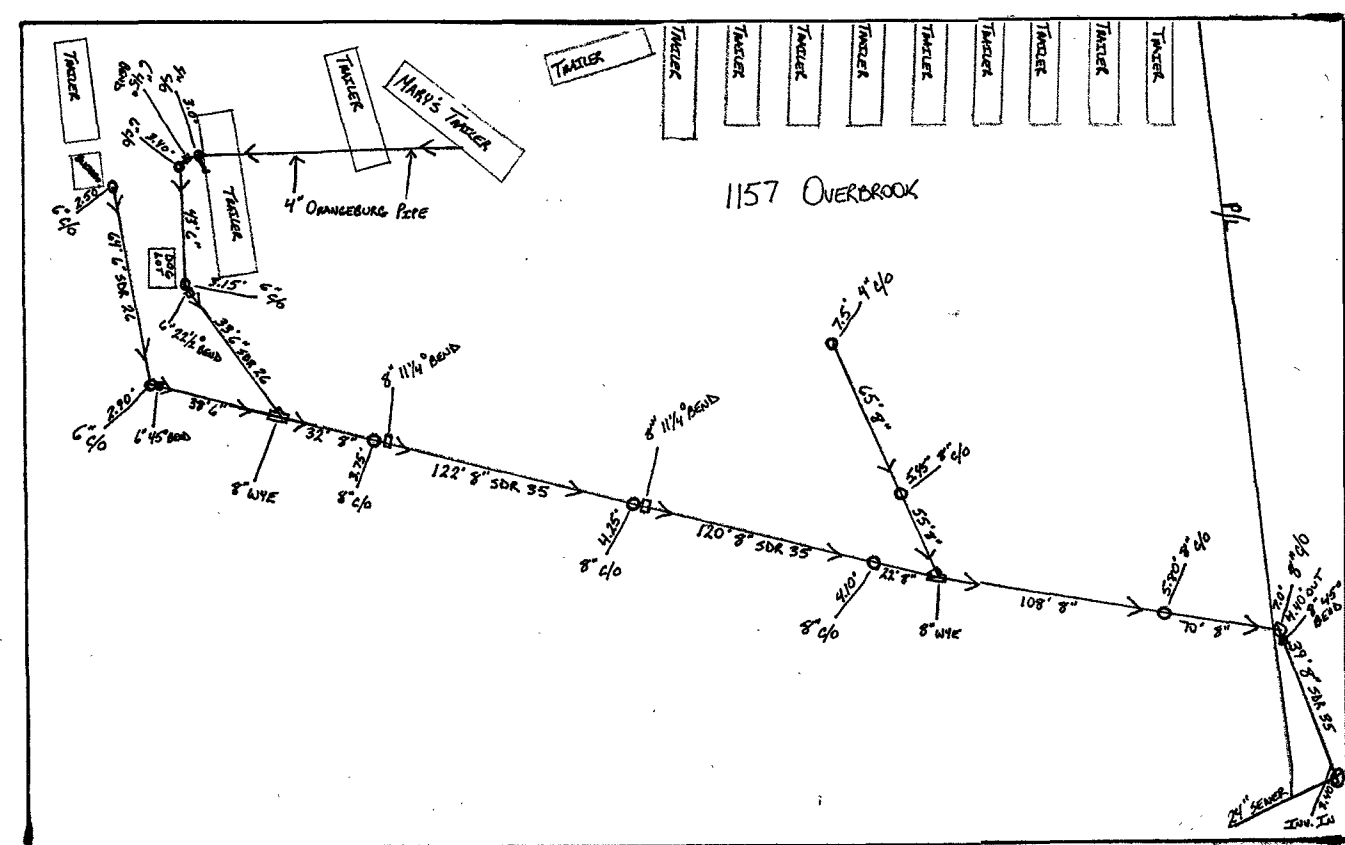

- GENERAL NOTES:
- SEWER LATERALS SHOWN ARE BASED ON CCTV FOOTAGE. ADDITIONAL LATERALS & CONFLICTS SHALL BE INVESTIGATED BY CONTRACTOR PRIOR TO EXCAVATION.
 - PROPERTY LINES SHOWN ON THIS PAGE ARE BASED ON GIS DATA AND HAVE NOT BEEN FIELD SURVEYED, WITH THE EXCEPTION OF PARCEL TAX NUMBER 6100512, WHOSE PROPERTY LINES WERE SET BASED ON RECORDS AND FIELD SURVEY DATA.

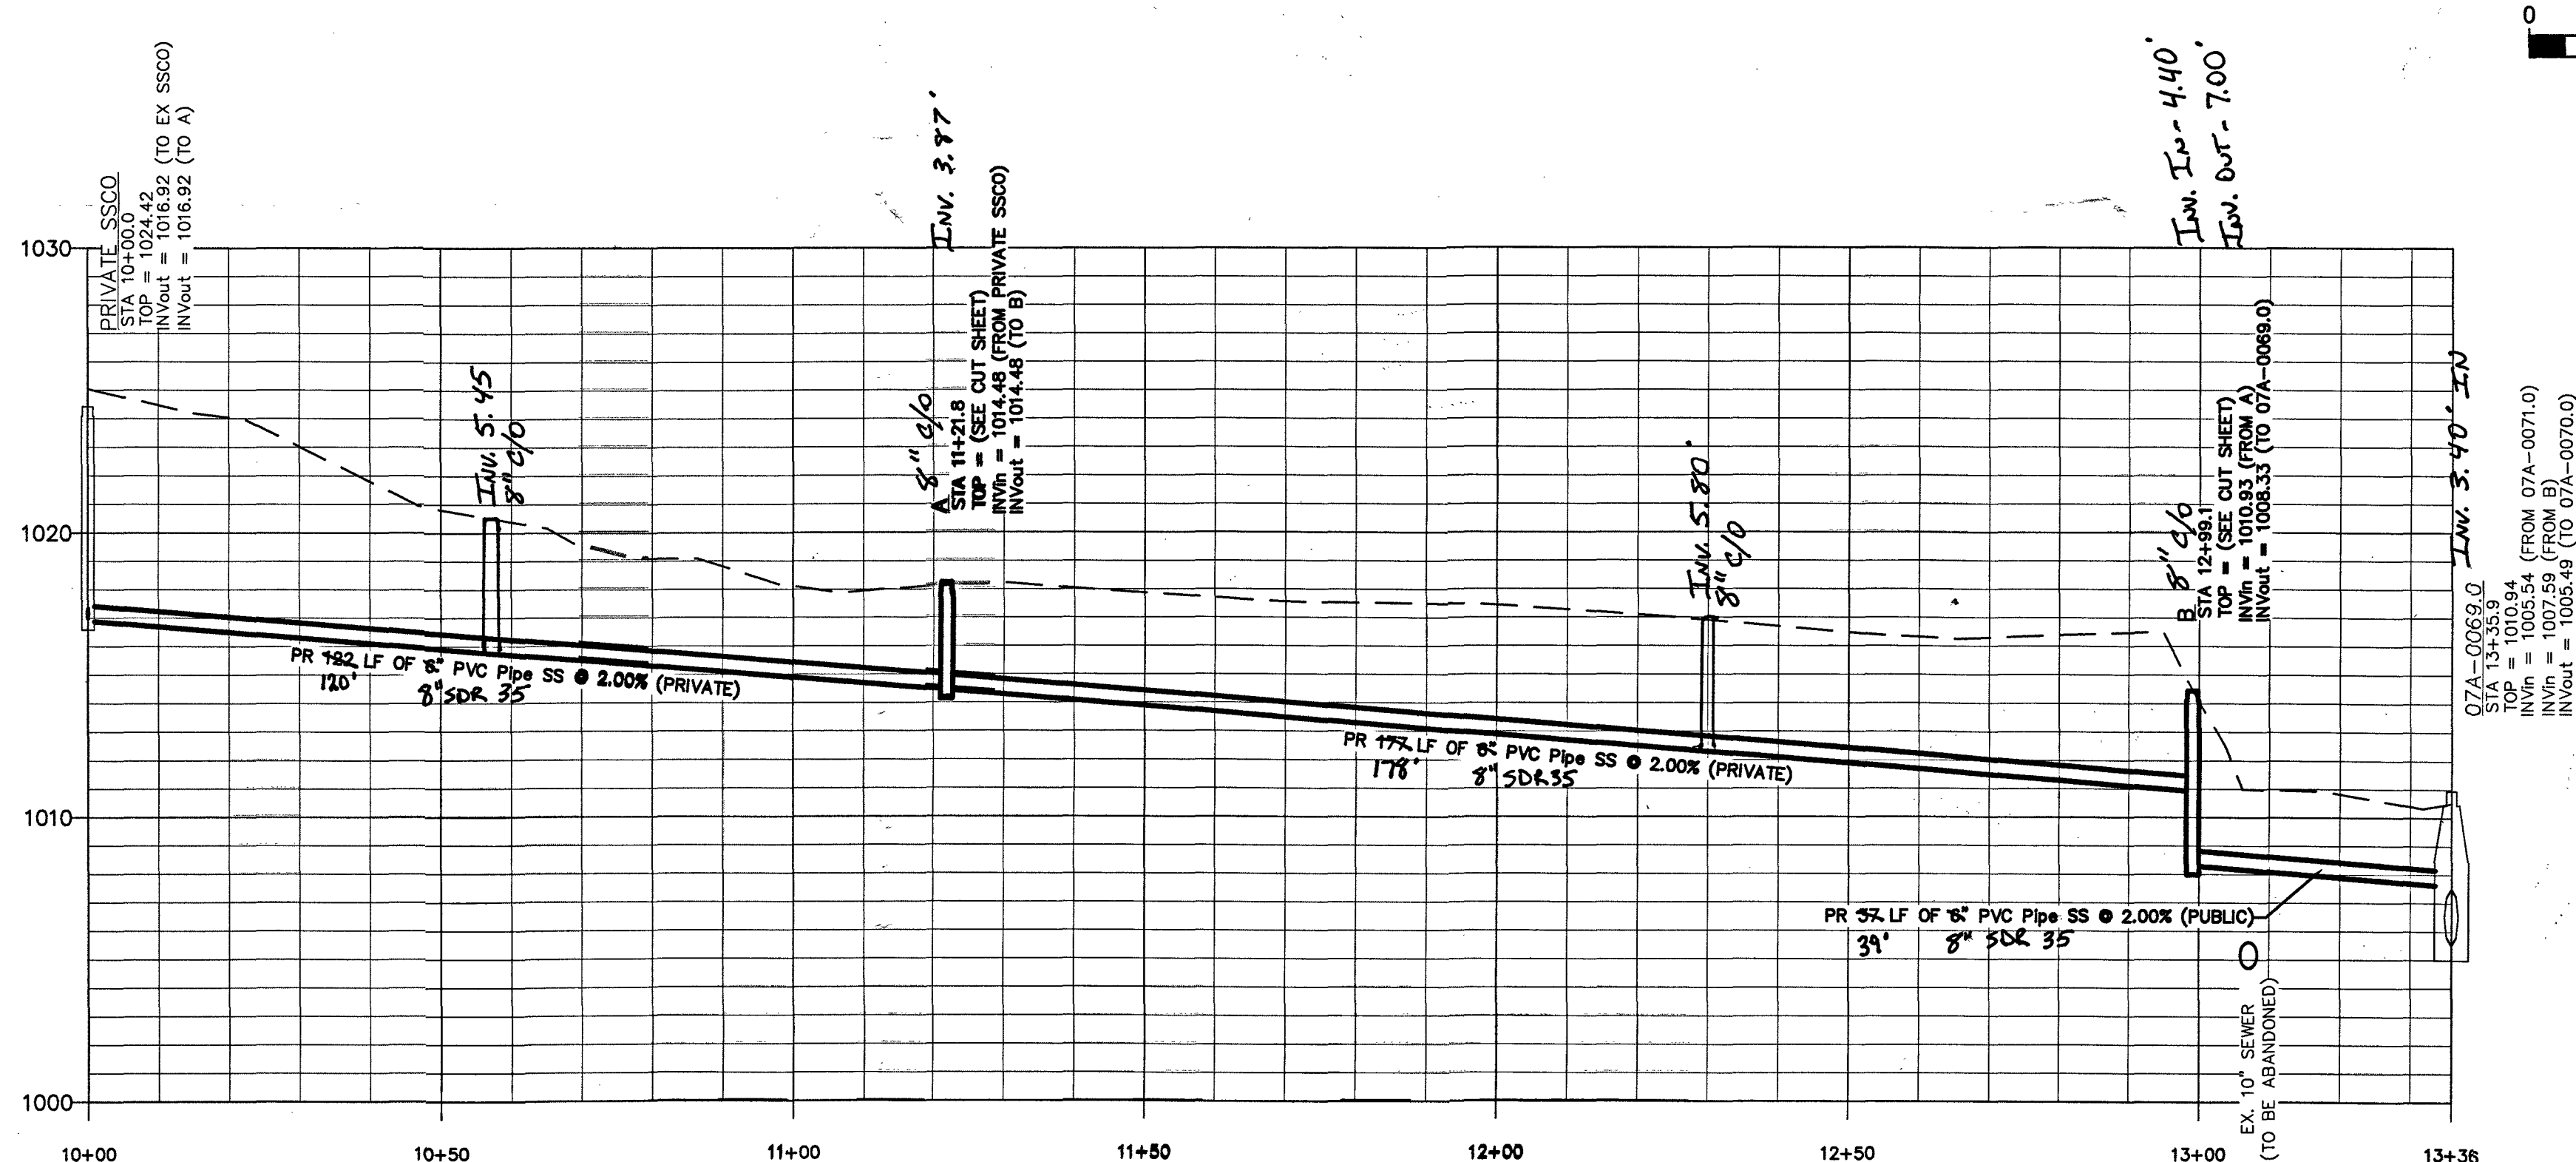

WESTERN VIRGINIA
WATER AUTHORITY
ENGINEERING SERVICES
601 S JEFFERSON ST, SUITE 300
ROANOKE, VA 24011
540-853-5700

PETERS CREEK SEWER
ABANDONMENT

PLAN & PROFILE

Rev	Description	Date	By
1	START	8-22-19	TB
2	COMPLETE	9-17-19	TB
3	AS-BUILT - CIVIL - THE DESIGNER	9-23-2019	START
4	COMPLETE	11-1-19	START
5	COMPLETE	12-5-19	START

Designed: DRJ
Drawn: AJC
Checked: NSS, AJC
Approved: TEC
Date: AUGUST 2019
Project: SCIP-239