


548

544

545

546

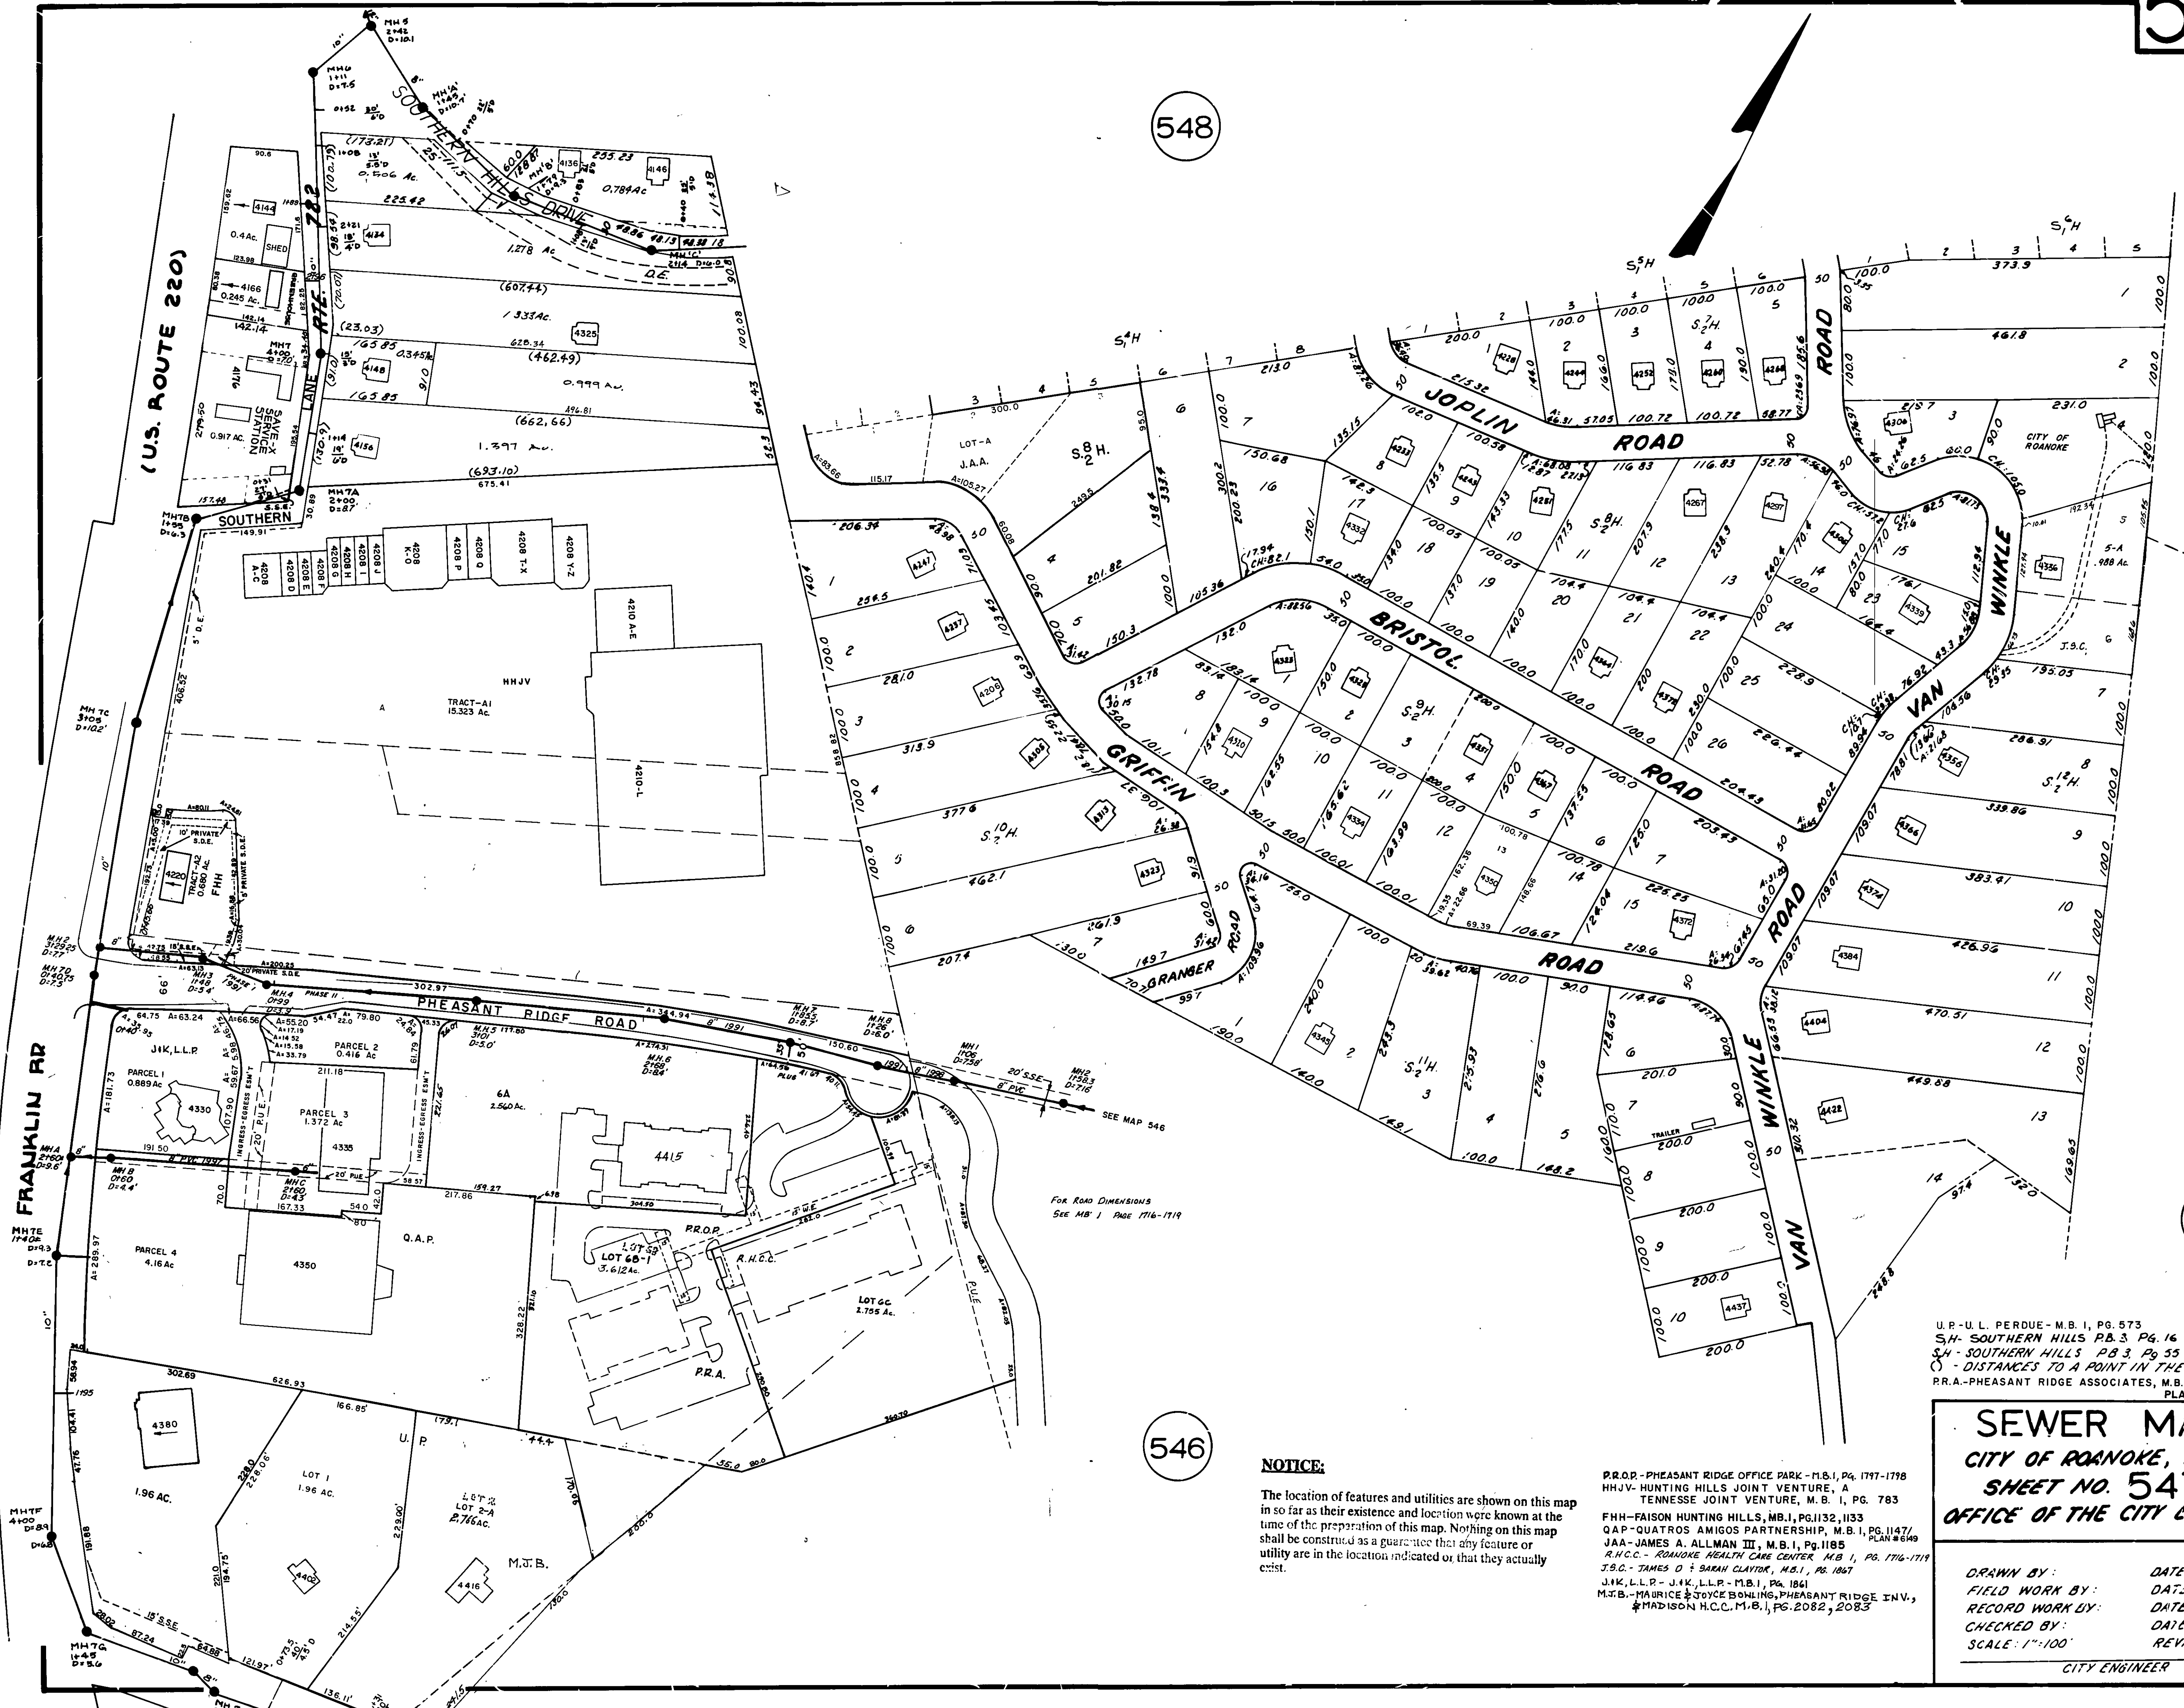

FOR ROAD DIMENSIONS
SEE MAP 1 PAGE 1716-1719

NOTICE:

The location of features and utilities are shown on this map in so far as their existence and location were known at the time of the preparation of this map. Nothing on this map shall be construed as a guarantee that any feature or utility are in the location indicated or that they actually exist.

P.R.O.P. - PHEASANT RIDGE OFFICE PARK - M.B. 1, PG. 1797-1798
 H.H.V. - HUNTING HILLS JOINT VENTURE, A
 TENNESSEE JOINT VENTURE, M.B. 1, PG. 783
 F.H.H. - FAISON HUNTING HILLS, M.B. 1, PG. 1132, 1133
 Q.A.P. - QUATROS AMIGOS PARTNERSHIP, M.B. 1, PG. 1147/
 J.A.A. - JAMES A. ALLMAN III, M.B. 1, PG. 1185
 R.H.C. - ROANOKE HEALTH CARE CENTER, M.B. 1, PG. 1716-1719
 J.S.C. - JAMES O. & SARAH CLAYTON, M.B. 1, PG. 1087
 J.K.L.L.R. - J.K.L.L.R. - M.B. 1, PG. 1861
 M.T.B. - MAURICE & JOYCE BOWLING, PHEASANT RIDGE INV.,
 & MADISON H.C.C. M.B. 1, PG. 2082, 2083

U.P.-U.L. PERDUE - M.B. 1, PG. 573
 S.H. - SOUTHERN HILLS P.B. 3, PG. 16
 S.H. - SOUTHERN HILLS P.B. 3, PG. 35
 () - DISTANCES TO A POINT IN THE ROAD
 P.R.A. - PHEASANT RIDGE ASSOCIATES, M.B. 1, PG. 729, 869
 PLAN N° 6149

SEWER MAP
CITY OF ROANOKE, VA.
SHEET NO. 547
OFFICE OF THE CITY ENGINEER

DRAWN BY:	DATE:
FIELD WORK BY:	DATE:
RECORD WORK BY:	DATE:
CHECKED BY:	DATE:
SCALE: 1"=100'	REVISED:

CITY ENGINEER