
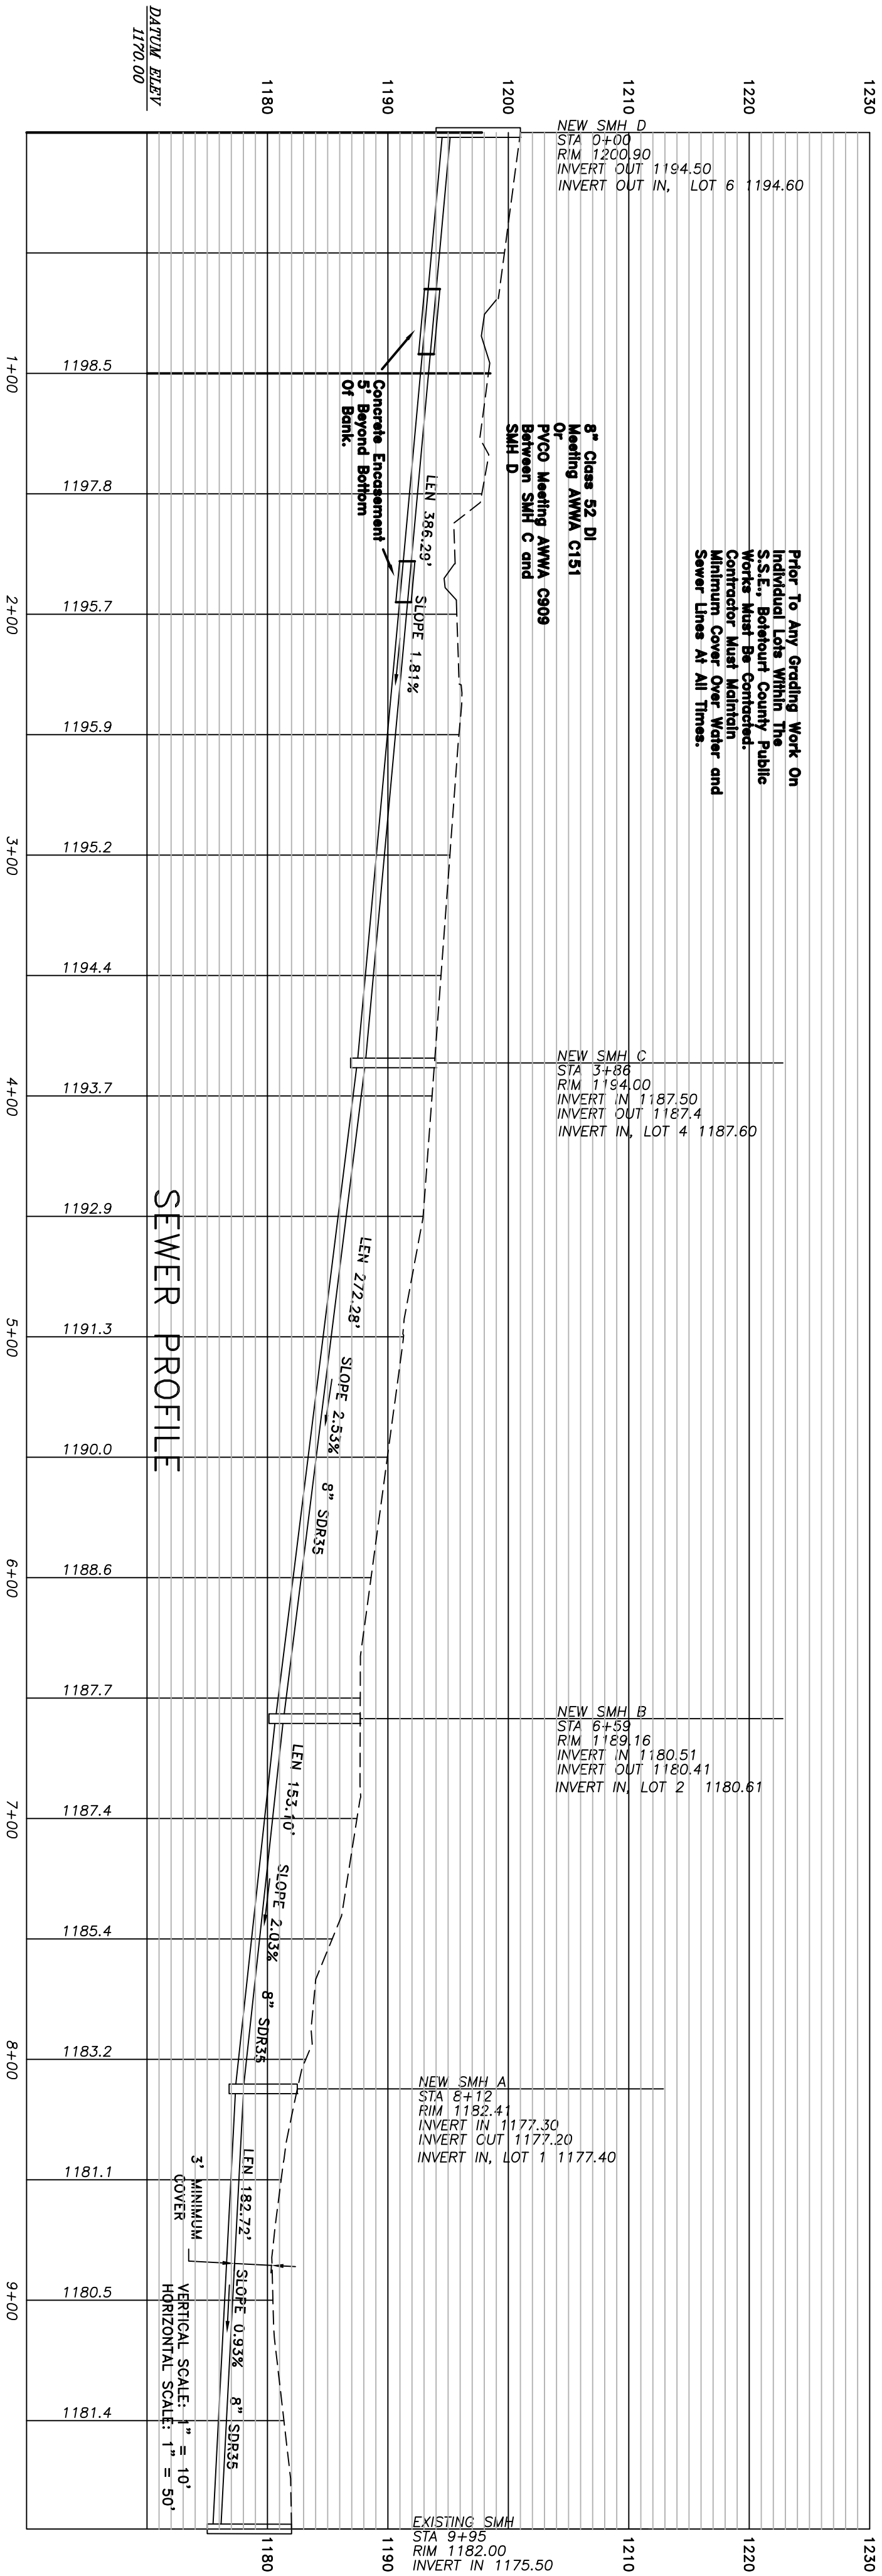


DEVELOPMENT PLAN
FOR
POPLAR TREE VILLAGE
BOTETOURT COUNTY, VIRGINIA

PROFILES

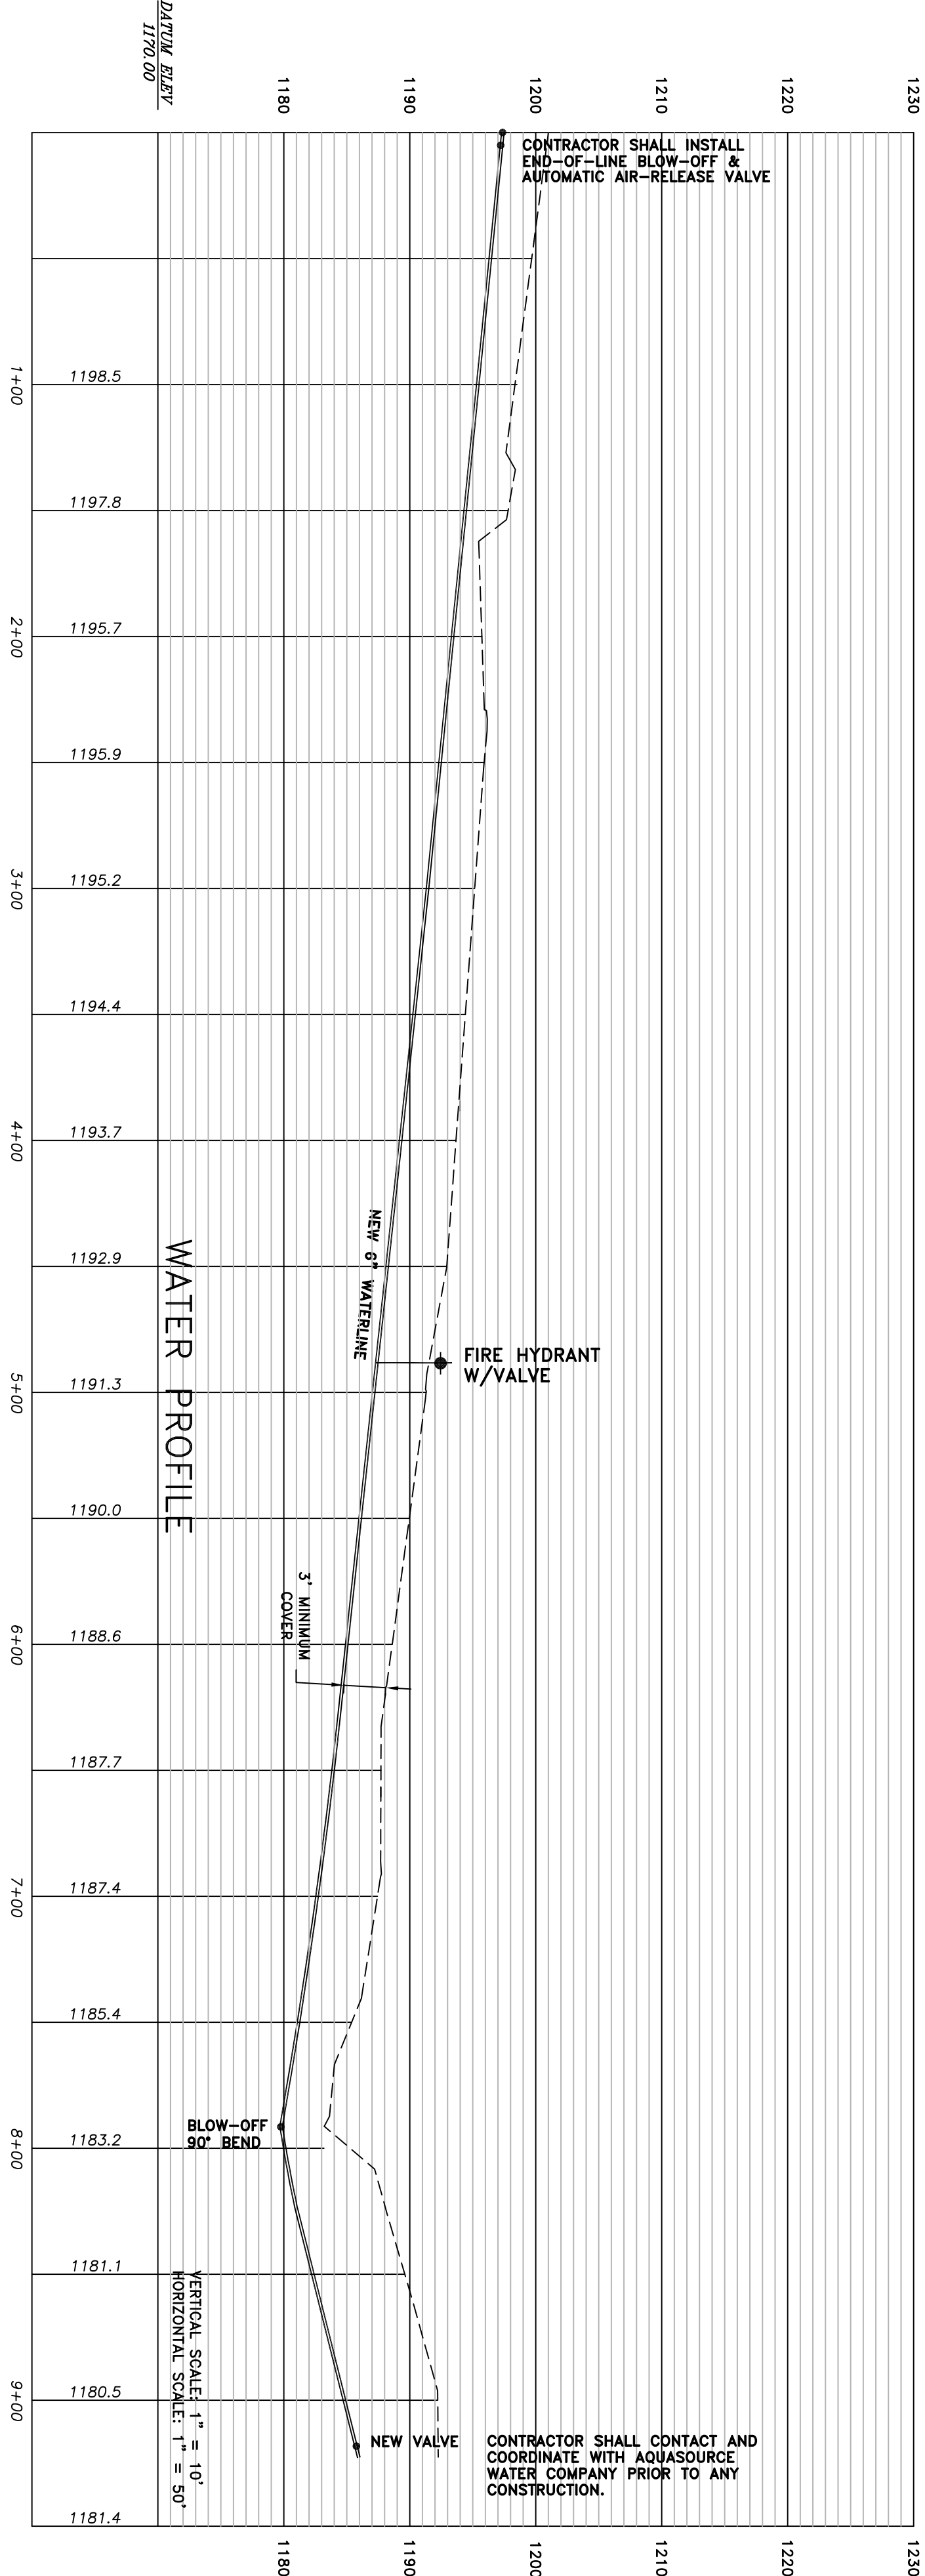

SLOPE CALCULATIONS ARE FROM CENTER
OF MANHOLE TO CENTER OF MANHOLE.
CONTRACTOR TO VERIFY SLOPES FOR
CONSTRUCTION PURPOSES.

AS-BUILT