

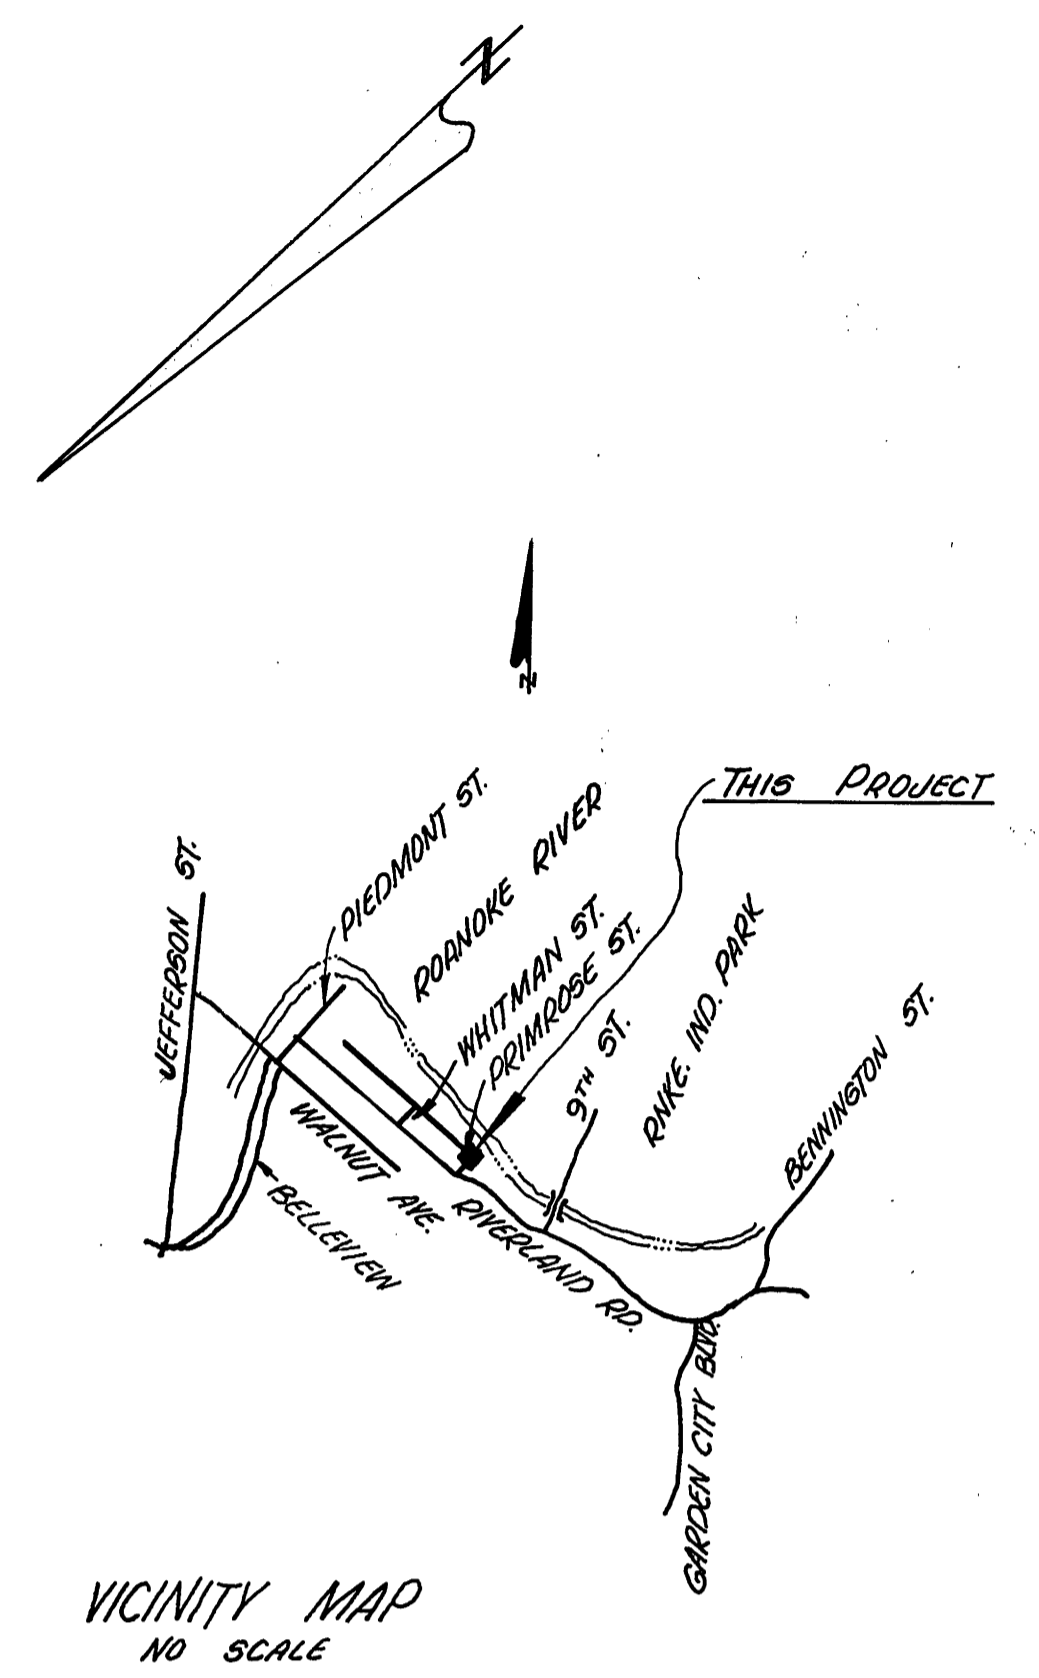


DATE: _____
 BY: **K. SMITH**
G. BREWER
 SURVEYED: _____
 PLOTTED: _____
 NOTE BOOK: _____
 NO. 563

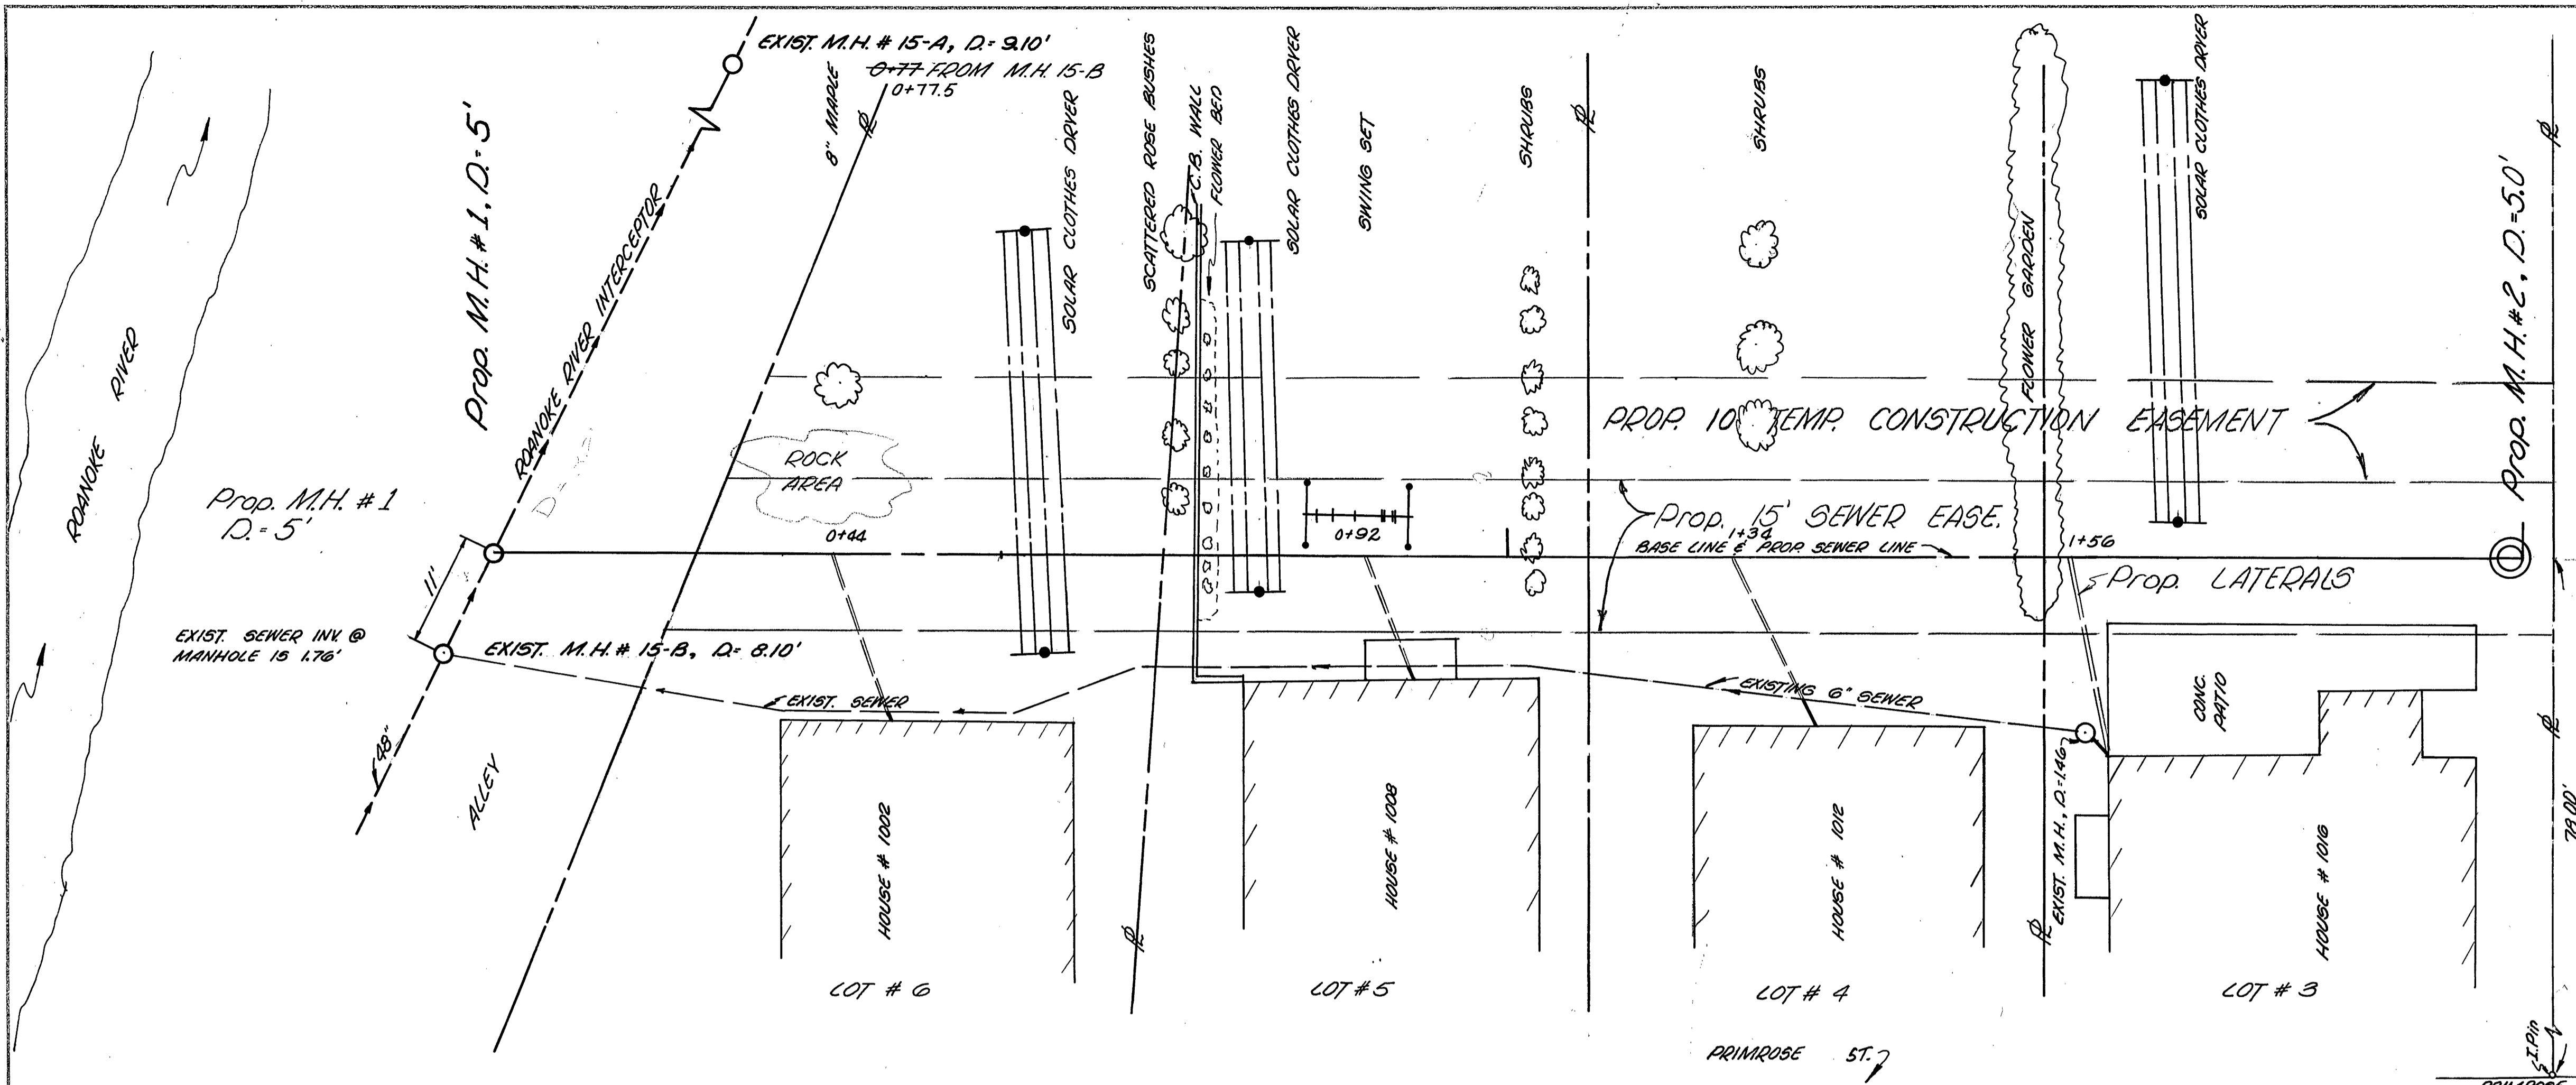

SCALE: 1"=10'
 APPROVED: *Sharon Brooks*
 CITY ENGINEER DATE: 12-2-17

DATE: _____
 BY: _____
 SURVEYED: _____
 PLOTTED: _____
 NOTE BOOK: _____
 NO. 563

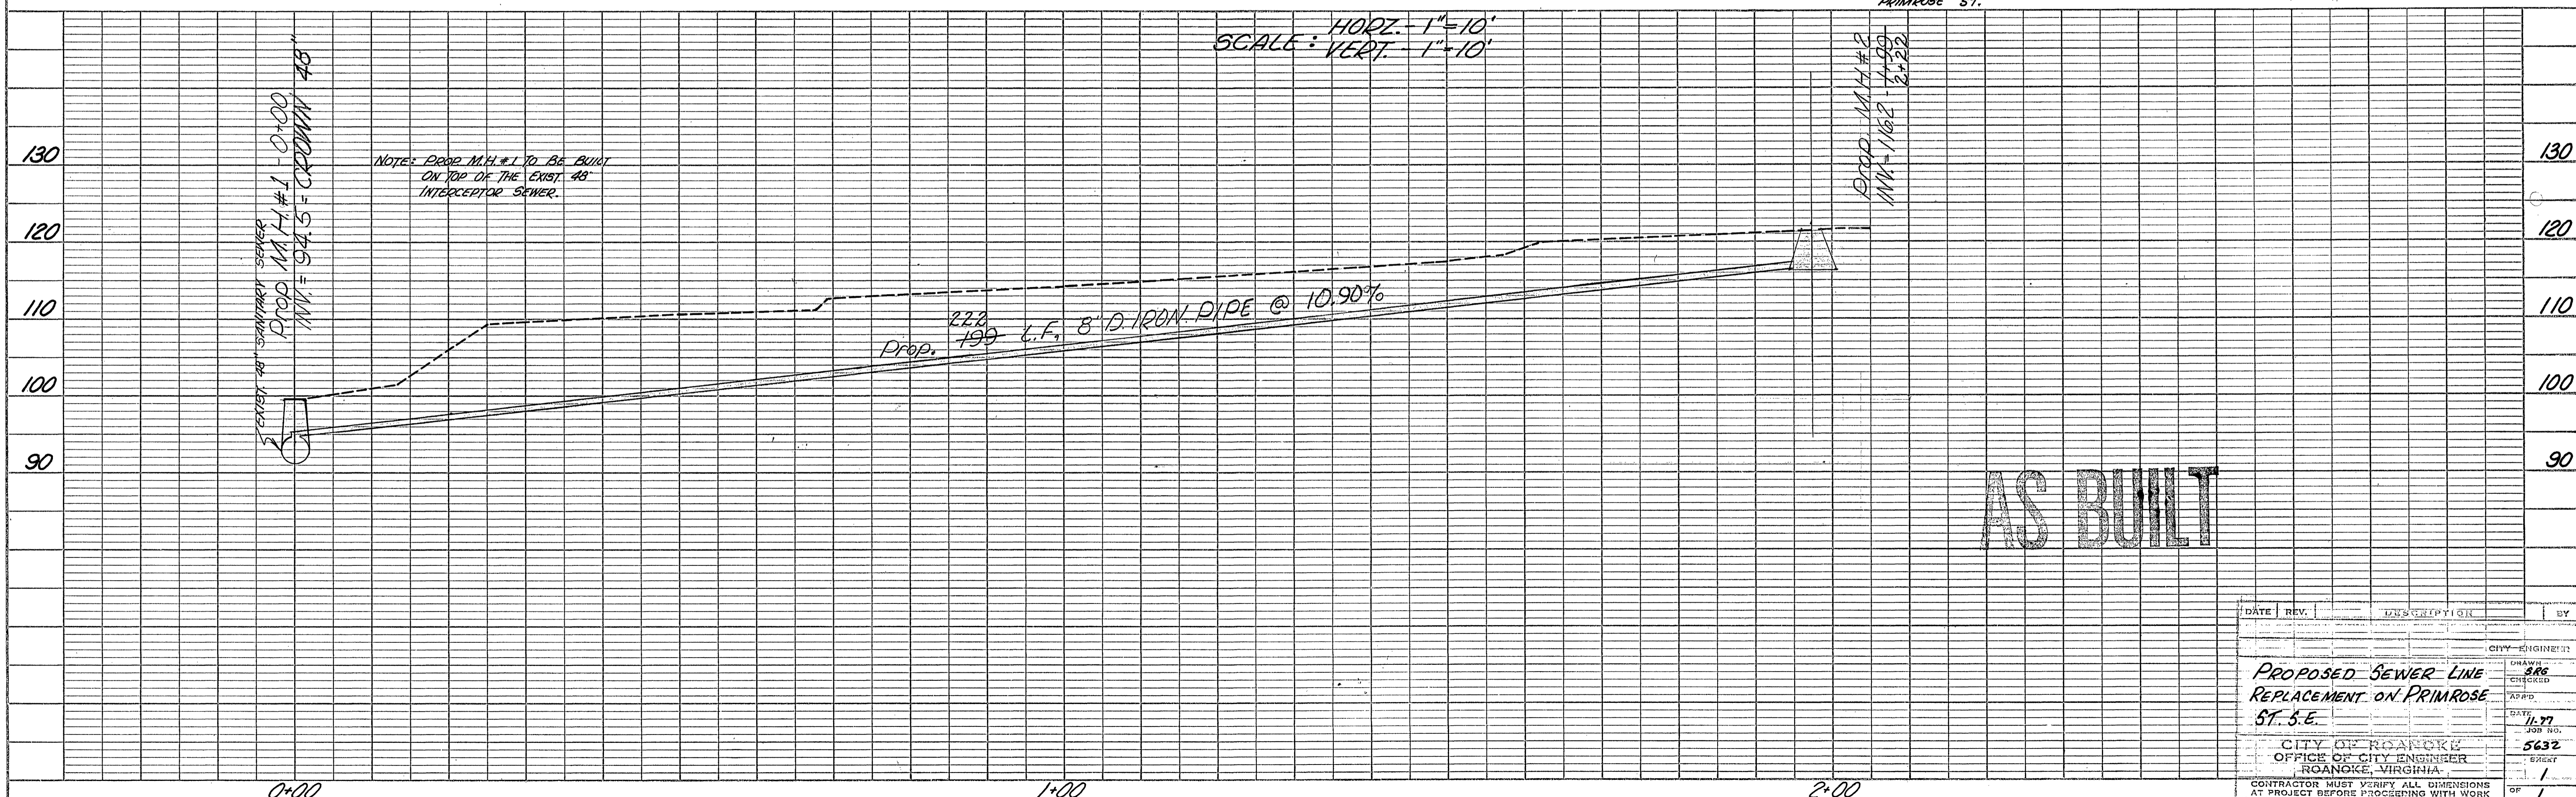

NOTE: PROP. M.H.#1 TO BE BUILT ON TOP OF THE EXIST. 48" INTERCEPTOR SEWER.

HORIZ. 1"=10'
 SCALE: VERT. 1"=10'

AS BUILT

DATE	REV.	DESCRIPTION	BY
11/17/17	1	PROPOSED SEWER LINE REPLACEMENT ON PRIMROSE ST. S.E.	SRG
11/17/17	2		SRG

CITY OF ROANOKE
 OFFICE OF CITY ENGINEER
 ROANOKE, VIRGINIA

CONTRACTOR MUST VERIFY ALL DIMENSIONS AT PROJECT BEFORE PROCEEDING WITH WORK